


10-12-54



00525

BOOK 890313
AMENDED PLAT OF
FOOTHILLS COUNTRY CLUB UNIT NO. 2

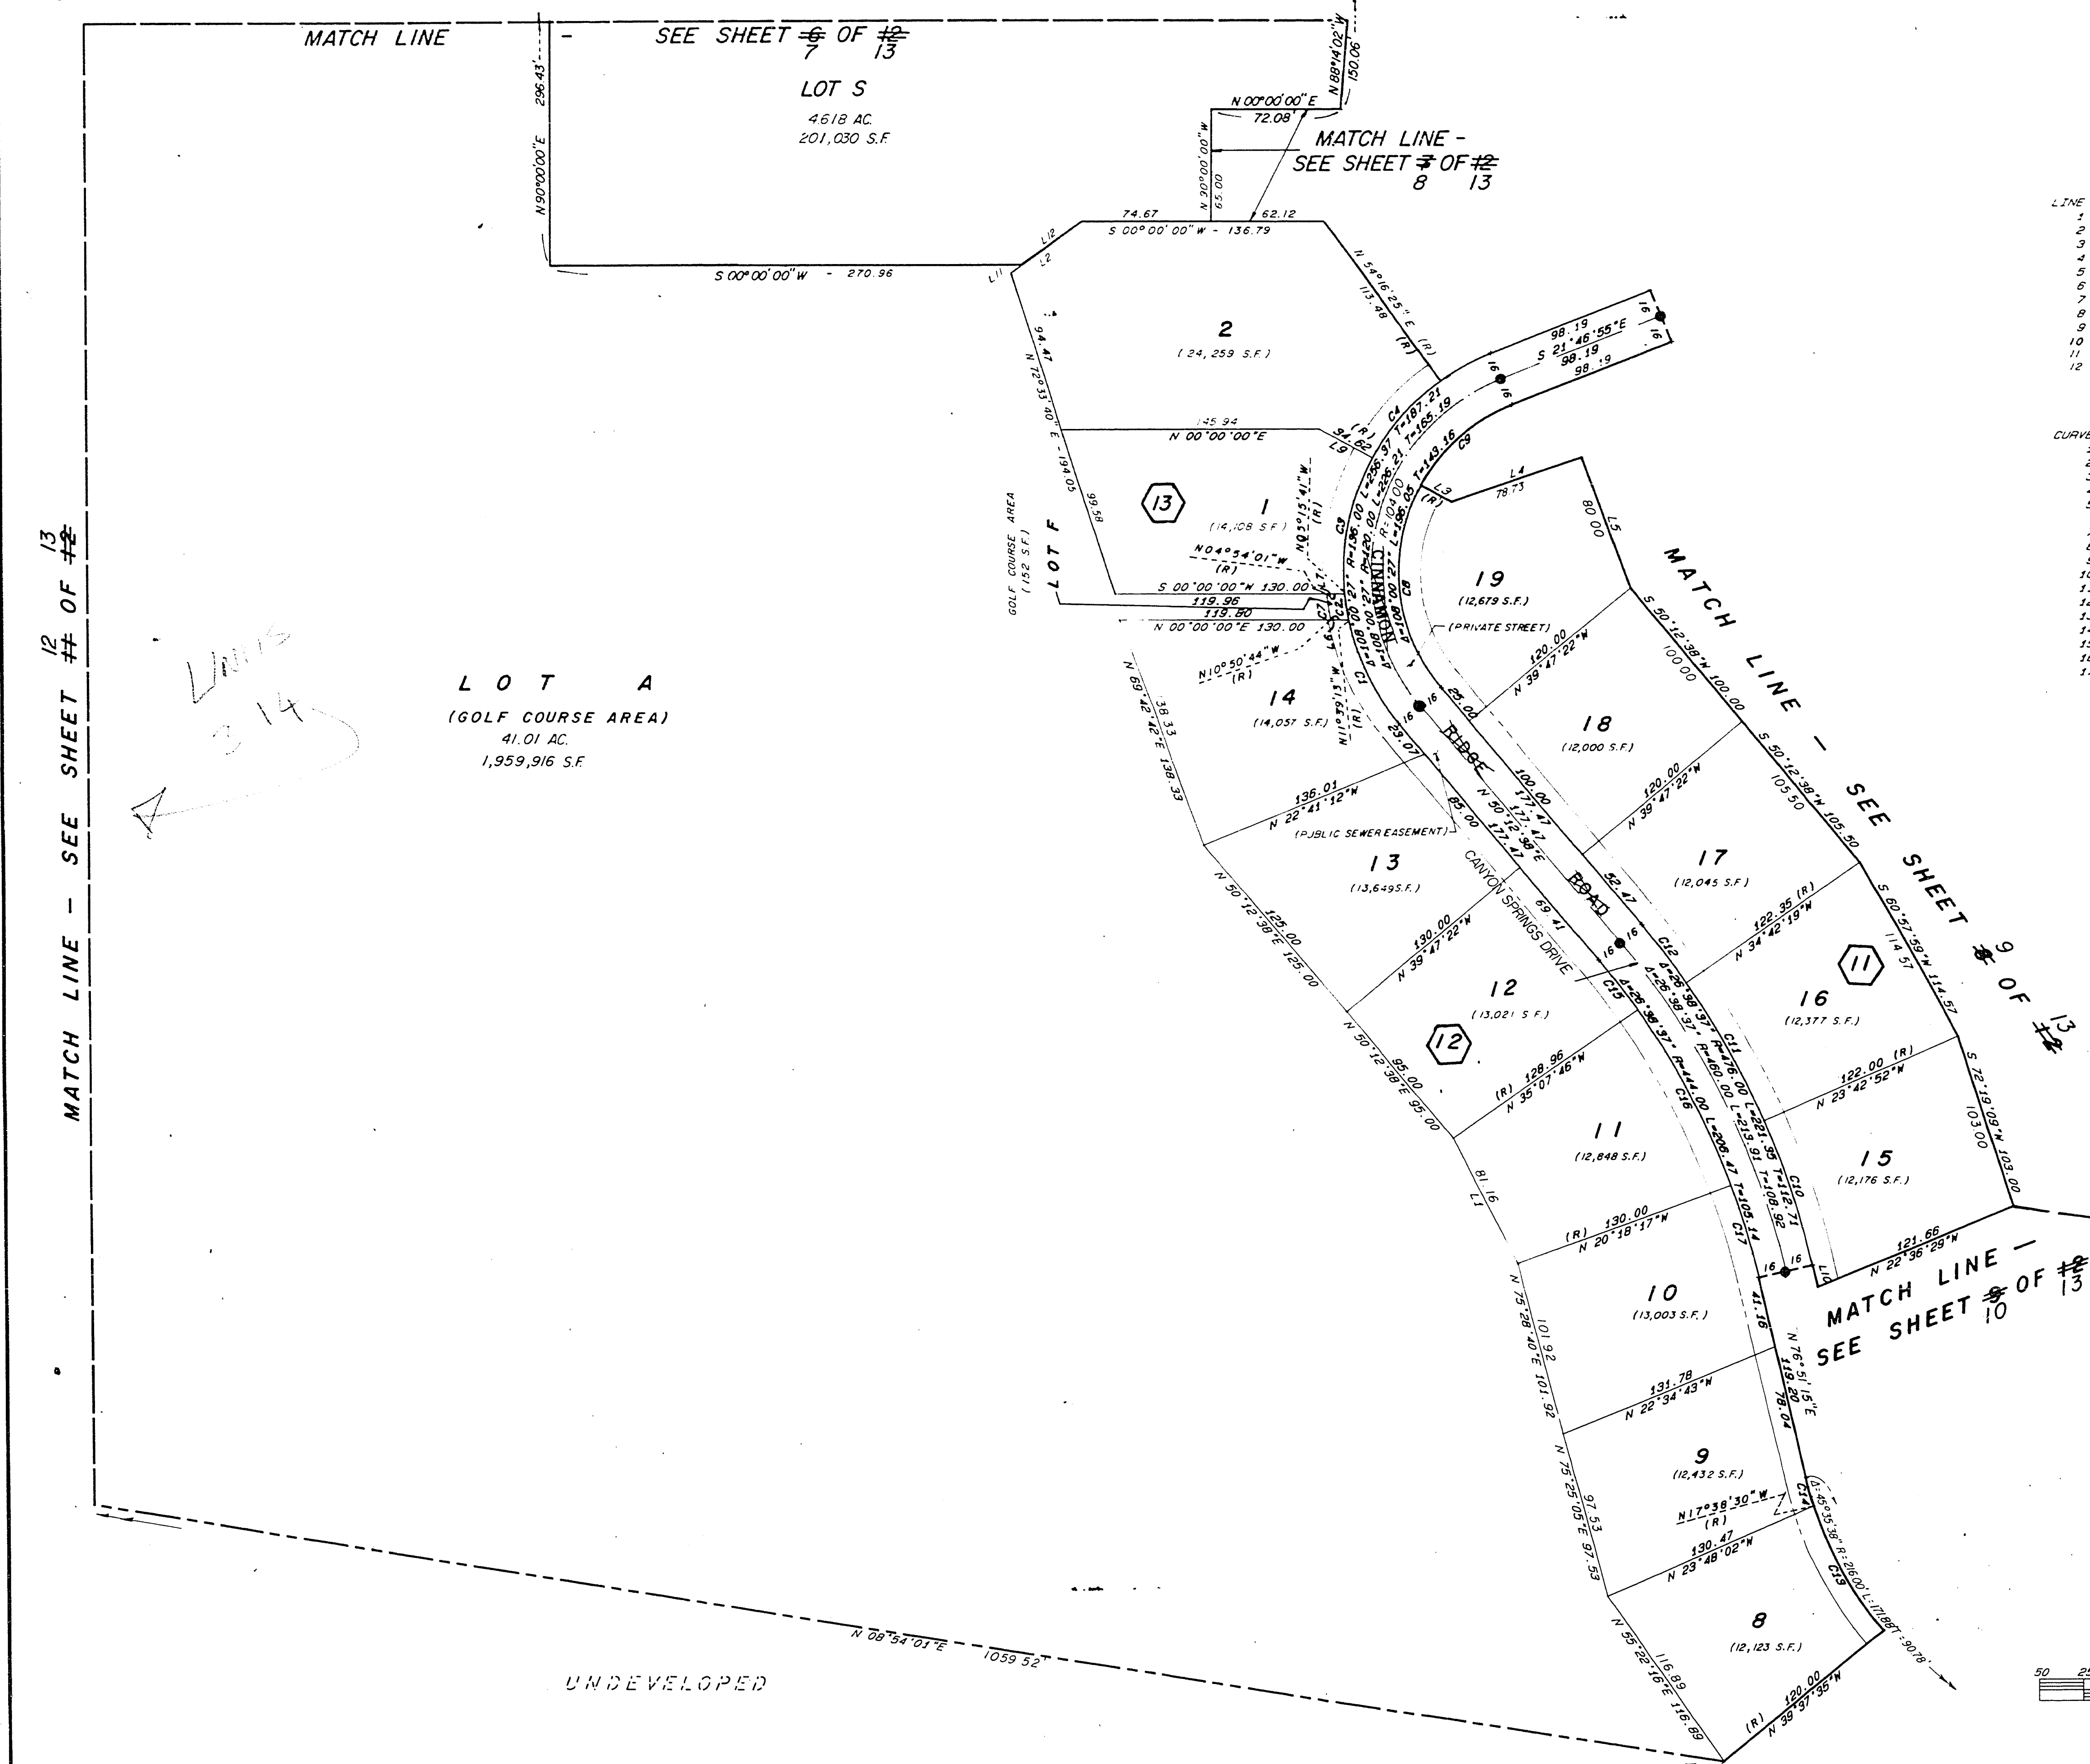

LINE	BEARING	DISTANCE
1	N 63°00'43"E	81.16
2	N 35°00'00"W	50.82
3	S 28°55'17"W (R)	20.00
4	S 18°57'42"E	28.73
5	S 70°00'00"W	80.00
6	S 00°00'00"N	10.20
7	N 00°00'00"E	10.04
8	S 54°16'25"N (R)	10.00
9	N 28°55'37"E (R)	34.62
10	N 76°51'15"E	13.00
11	N 36°00'00"W	8.33
12	N 36°00'00"W	42.53

CURVE	DELTA	RADIUS	LENGTH	TANGENT
1	28°08'09"	136.00	56.78	34.08
2	8°23'32"	136.00	15.17	7.59
3	34°11'16"	136.00	81.15	41.62
4	25°20'48"	136.00	60.16	30.58
5	13°56'40"	136.00	33.10	16.63
7	5°56'43"	146.00	15.15	7.58
8	68°42'39"	104.00	124.72	71.09
9	39°17'49"	104.00	71.33	37.13
10	10°34'07"	476.00	87.80	44.03
11	10°59'27"	476.00	91.31	45.60
12	5°05'03"	476.00	46.24	21.13
13	21°59'05"	216.00	62.88	41.56
14	4°29'45"	216.00	16.95	8.48
15	4°39'36"	444.00	36.11	18.07
16	14°49'29"	444.00	114.88	57.76
17	7°09'32"	444.00	55.48	27.77

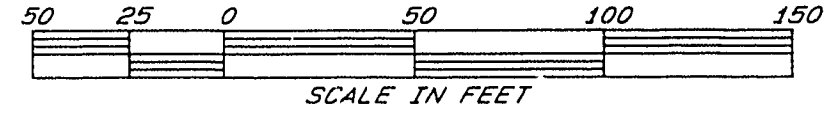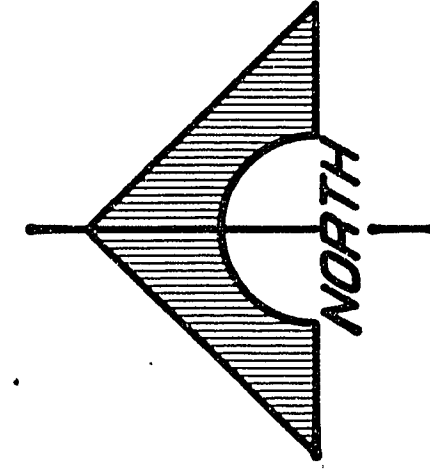

11 OF 13
SHEET 10 OF 12