




10-12-55

00525

BOOK 890313
AMENDED PLAT OF
FOOTHILLS COUNTRY CLUB UNIT NO. 2

LINE	BEARING	DISTANCE
1	N 61°20'33"E	80.00
2	N 61°20'33"E	80.00
3	S 28°39'27"E	10.00
4	S 28°39'27"E	16.00
5	S 28°39'27"E	16.00

CURVE	DELTA	RADIUS	LENGTH	TANGENT
1	14°50'06"	300.00	77.68	39.06
2	29°40'12"	300.00	155.35	79.46
3	14°50'06"	316.00	81.82	41.14
4	29°40'12"	284.00	147.07	75.22
5	14°50'06"	284.00	73.53	36.97
6	8°03'30"	284.00	39.94	20.00
7	6°46'36"	284.00	33.59	16.81
8	29°40'12"	316.00	163.64	83.70
9	7°34'58"	316.00	41.82	20.94
10	14°32'40"	316.00	80.22	40.32
11	7°32'34"	316.00	41.60	20.83
12	6°48'17"	284.00	33.81	16.93
13	8°00'49"	284.00	39.72	19.89

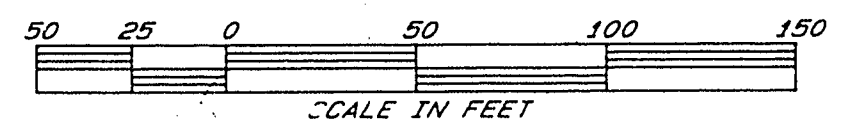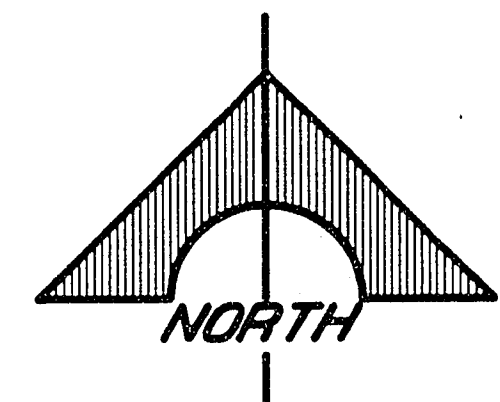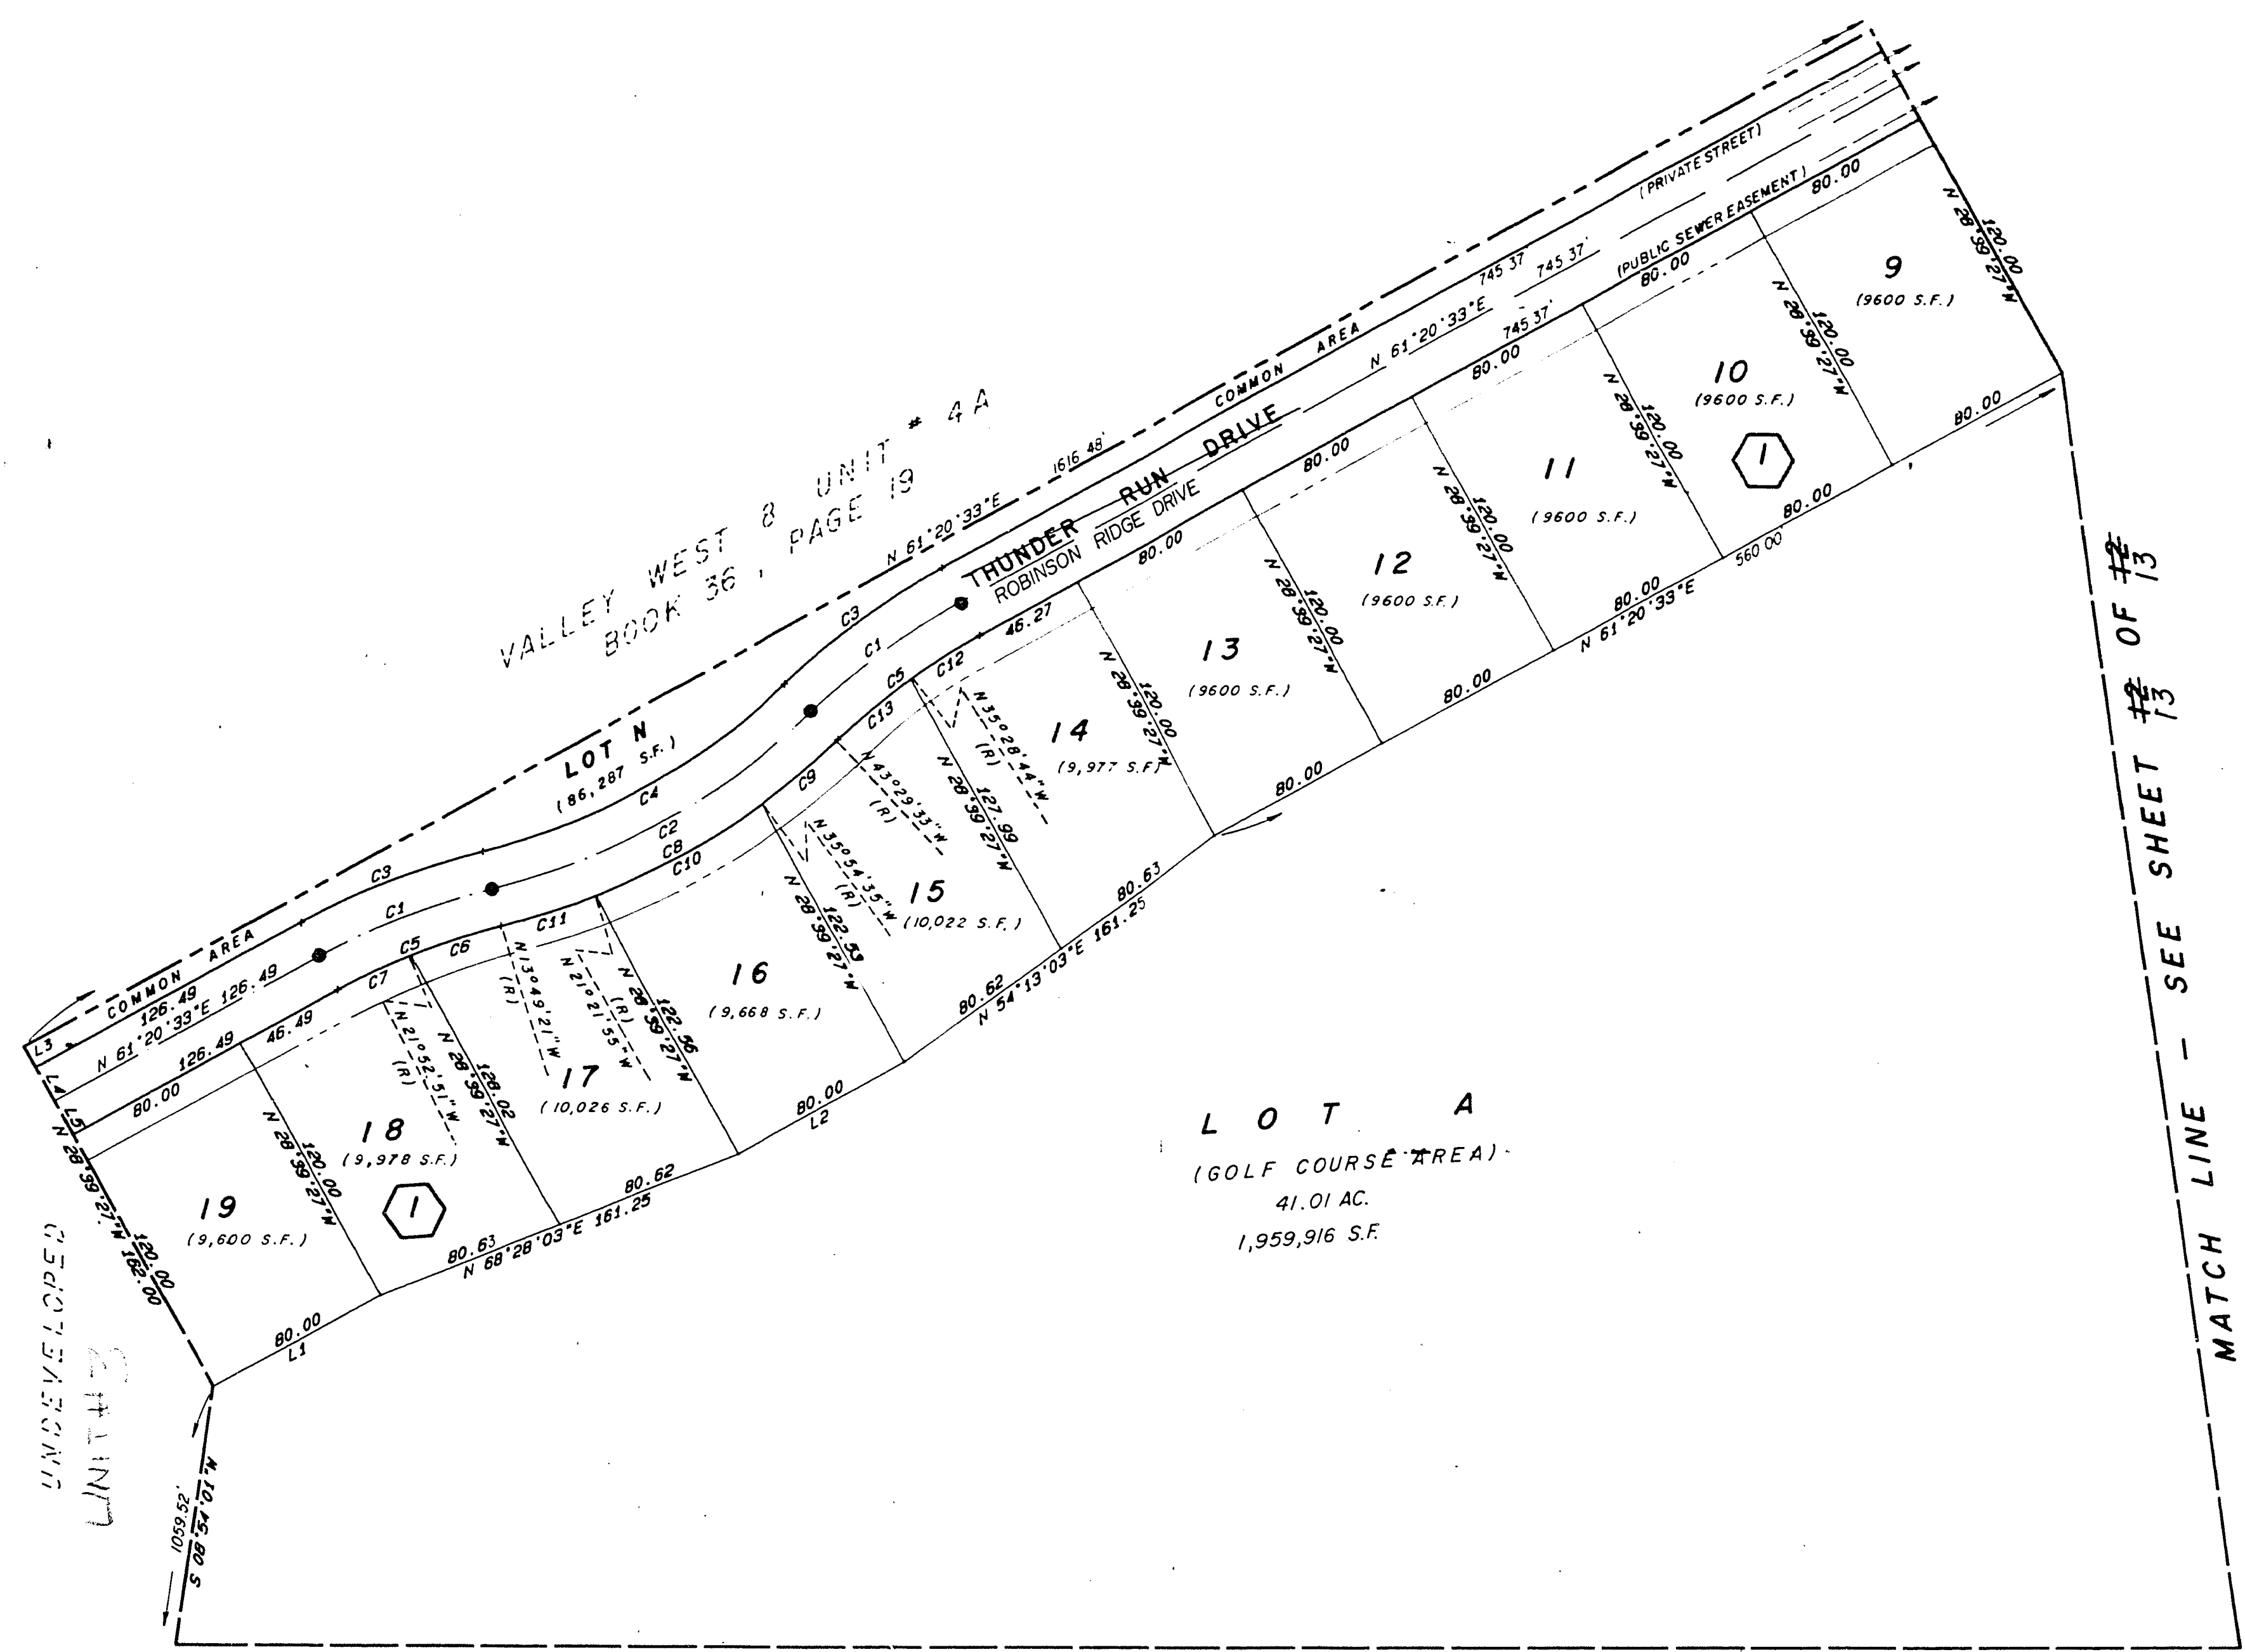

12 OF 13
SHEET 11 OF 12

Book 42 Page 4

Book 57 Page 57

1407-2 Amended