


Book 890313
 AMENDED PLAT OF
 FOOTHILLS COUNTRY CLUB UNIT NO. 2



10-12-56
 00525

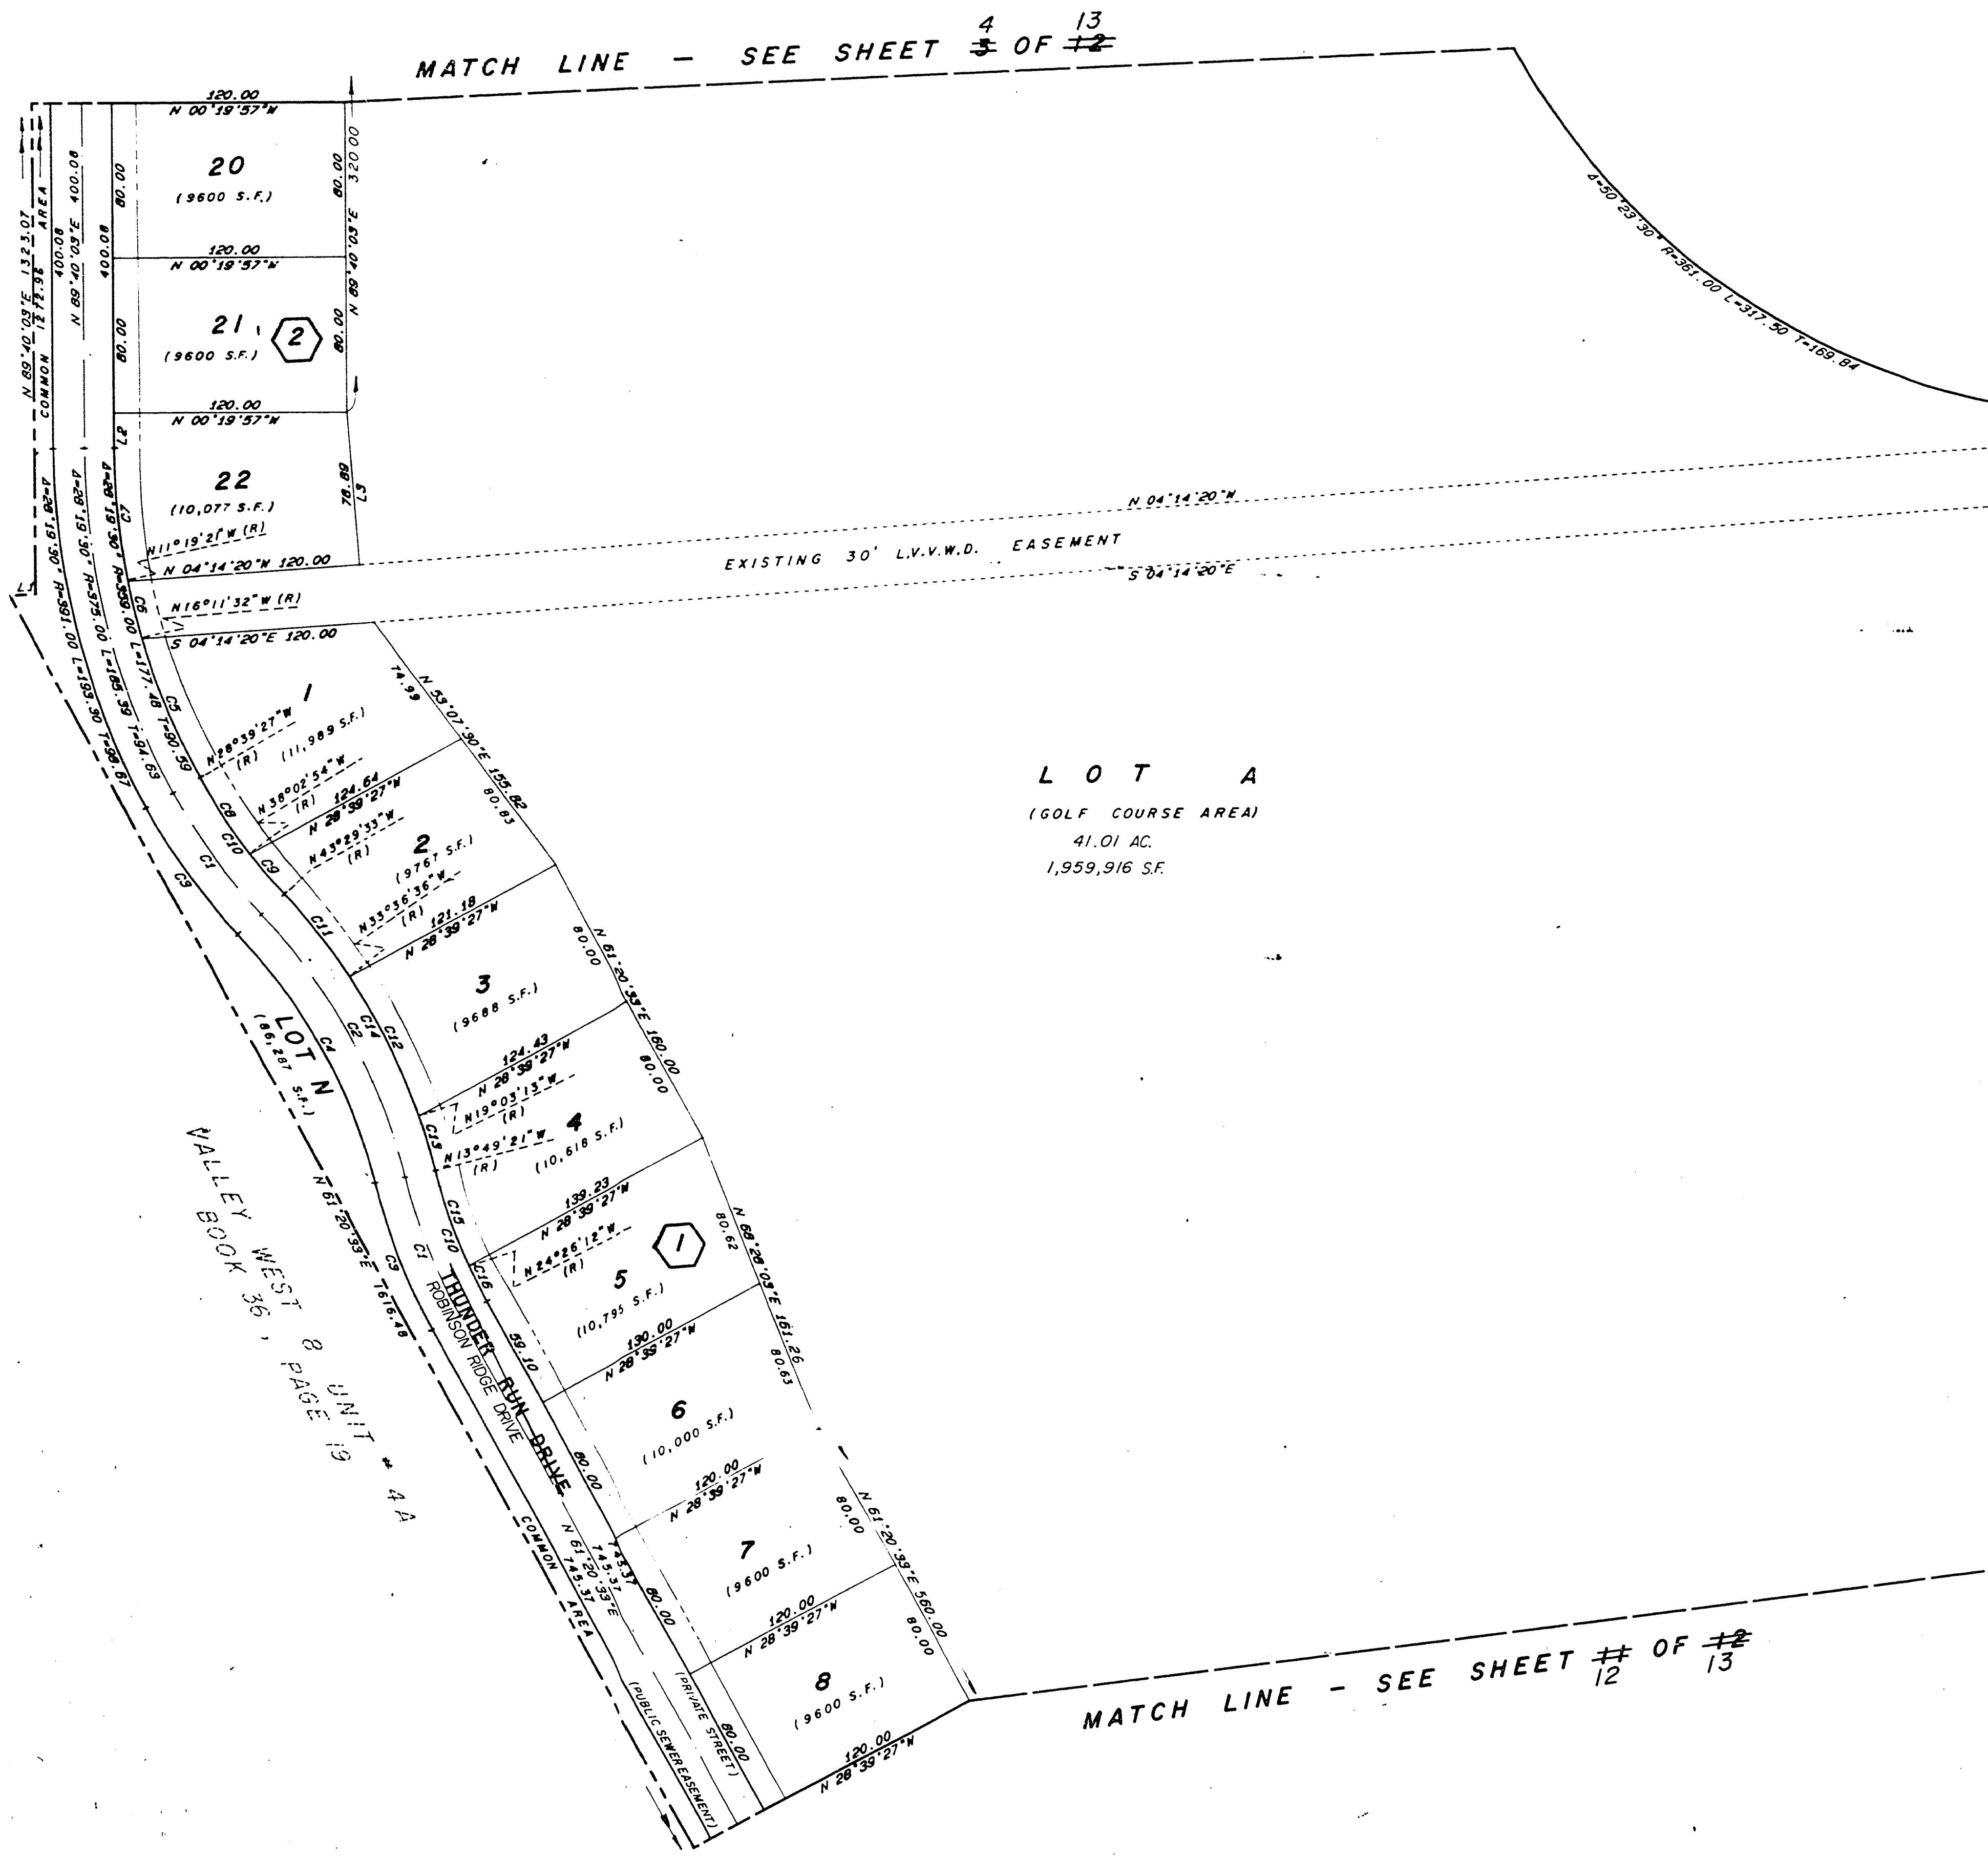

LINE	BEARING	DISTANCE
1	S 04°14'20"E	13.77
2	N 89°40'03"E	18.37
3	N 85°05'00"E	78.89

CURVE	DELTA	RADIUS	LENGTH	TANGENT
1	14°50'06"	300.00	77.68	39.06
2	29°40'12"	300.00	155.35	78.46
3	14°50'06"	316.00	81.82	41.14
4	29°40'12"	284.00	147.07	75.22
5	12°27'55"	359.00	78.10	39.21
6	4°52'11"	359.00	30.51	15.27
7	10°59'24"	359.00	68.86	34.54
8	9°23'27"	284.00	46.55	23.33
9	5°26'29"	284.00	26.99	13.50
10	14°50'06"	284.00	73.53	36.97
11	9°52'57"	316.00	54.50	27.32
12	14°33'23"	316.00	80.28	40.36
13	5°13'52"	316.00	28.85	14.44
14	29°40'12"	316.00	163.64	83.70
15	10°36'51"	284.00	52.61	26.38
16	4°13'15"	284.00	20.92	10.47

MATCH LINE - SEE SHEET 12 OF 13

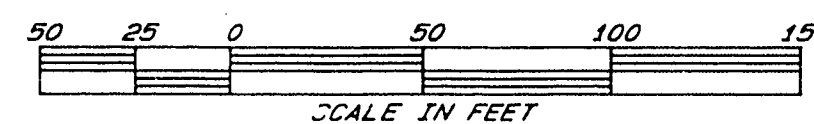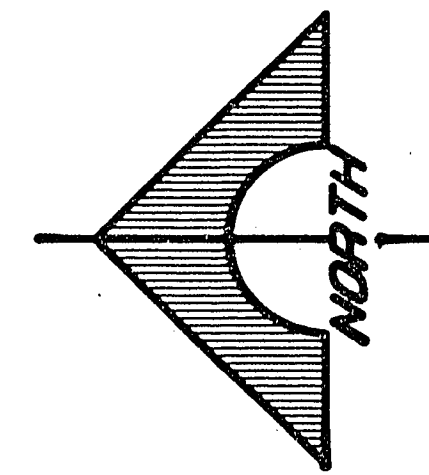

13 OF 13
 SHEET 12 OF 12