



23-4-107

APPROXIMATE QUANTITIES - THIS SHEET									
CONST. NOTE	ITEM NO.	DESCRIPTION	C.L.V.	S.I.D.	R.S.H.	UNIT	TOTAL		
	201.100	ROADWAY EXCAVATION			167.827	CY	167.827		
		ROADWAY FILL TO SUBGRADE				CY	23		
(1)		WHEEL CUT A.C. PAV'T			518.1032	LF	518.1032		
(2)		REMOVE A.C. PAV'T			390.409	SY	390.409		
(15)	334.006	3" A.C. PAV'T.			210.385	TN	210.385		
(17)	334.003	1-1/2" A.C. OVERLAY			151.131	TN	151.131		
(18)	333.501	3/4" OPENGRADE			2756.3556	SY	2756.3556		
(19)		PRIME COAT			225.617	GAL	225.617		
(20)		TACK COAT			225.617	GAL	225.617		
(23)	302.200	TYPE II GRAVEL BASE			181.230	CY	181.230		
(10)	340.014	24" "L" TYPE C&G			1000	LF	1000		
(13)	340.226	CONC. COMM. D/W			640	SF	640		
	334.003	1 1/2" AC PAV'T (BIKE PATH)	29			TN	29		

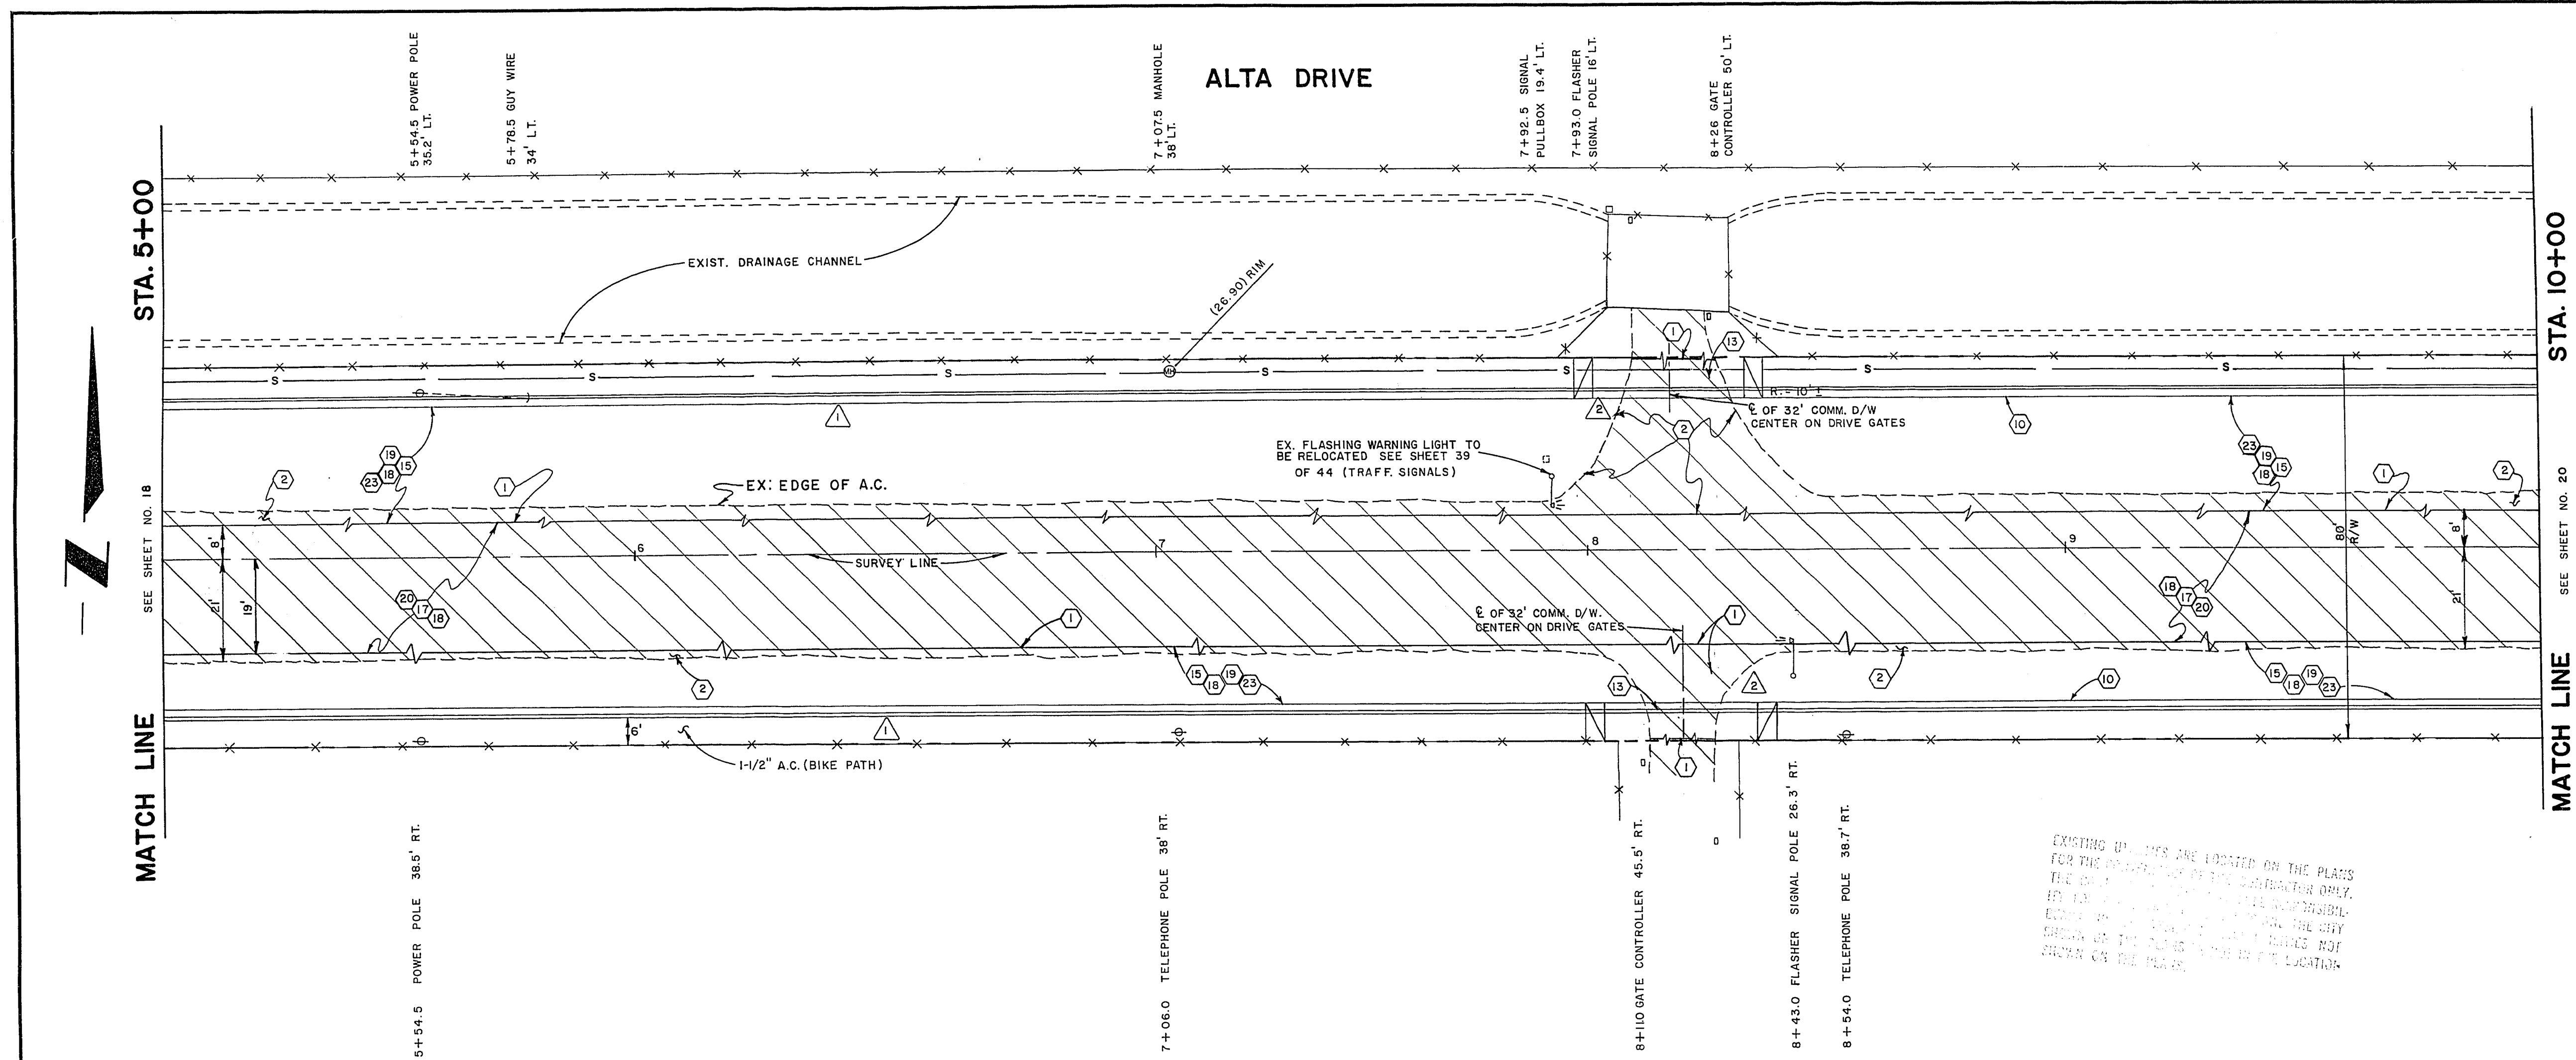


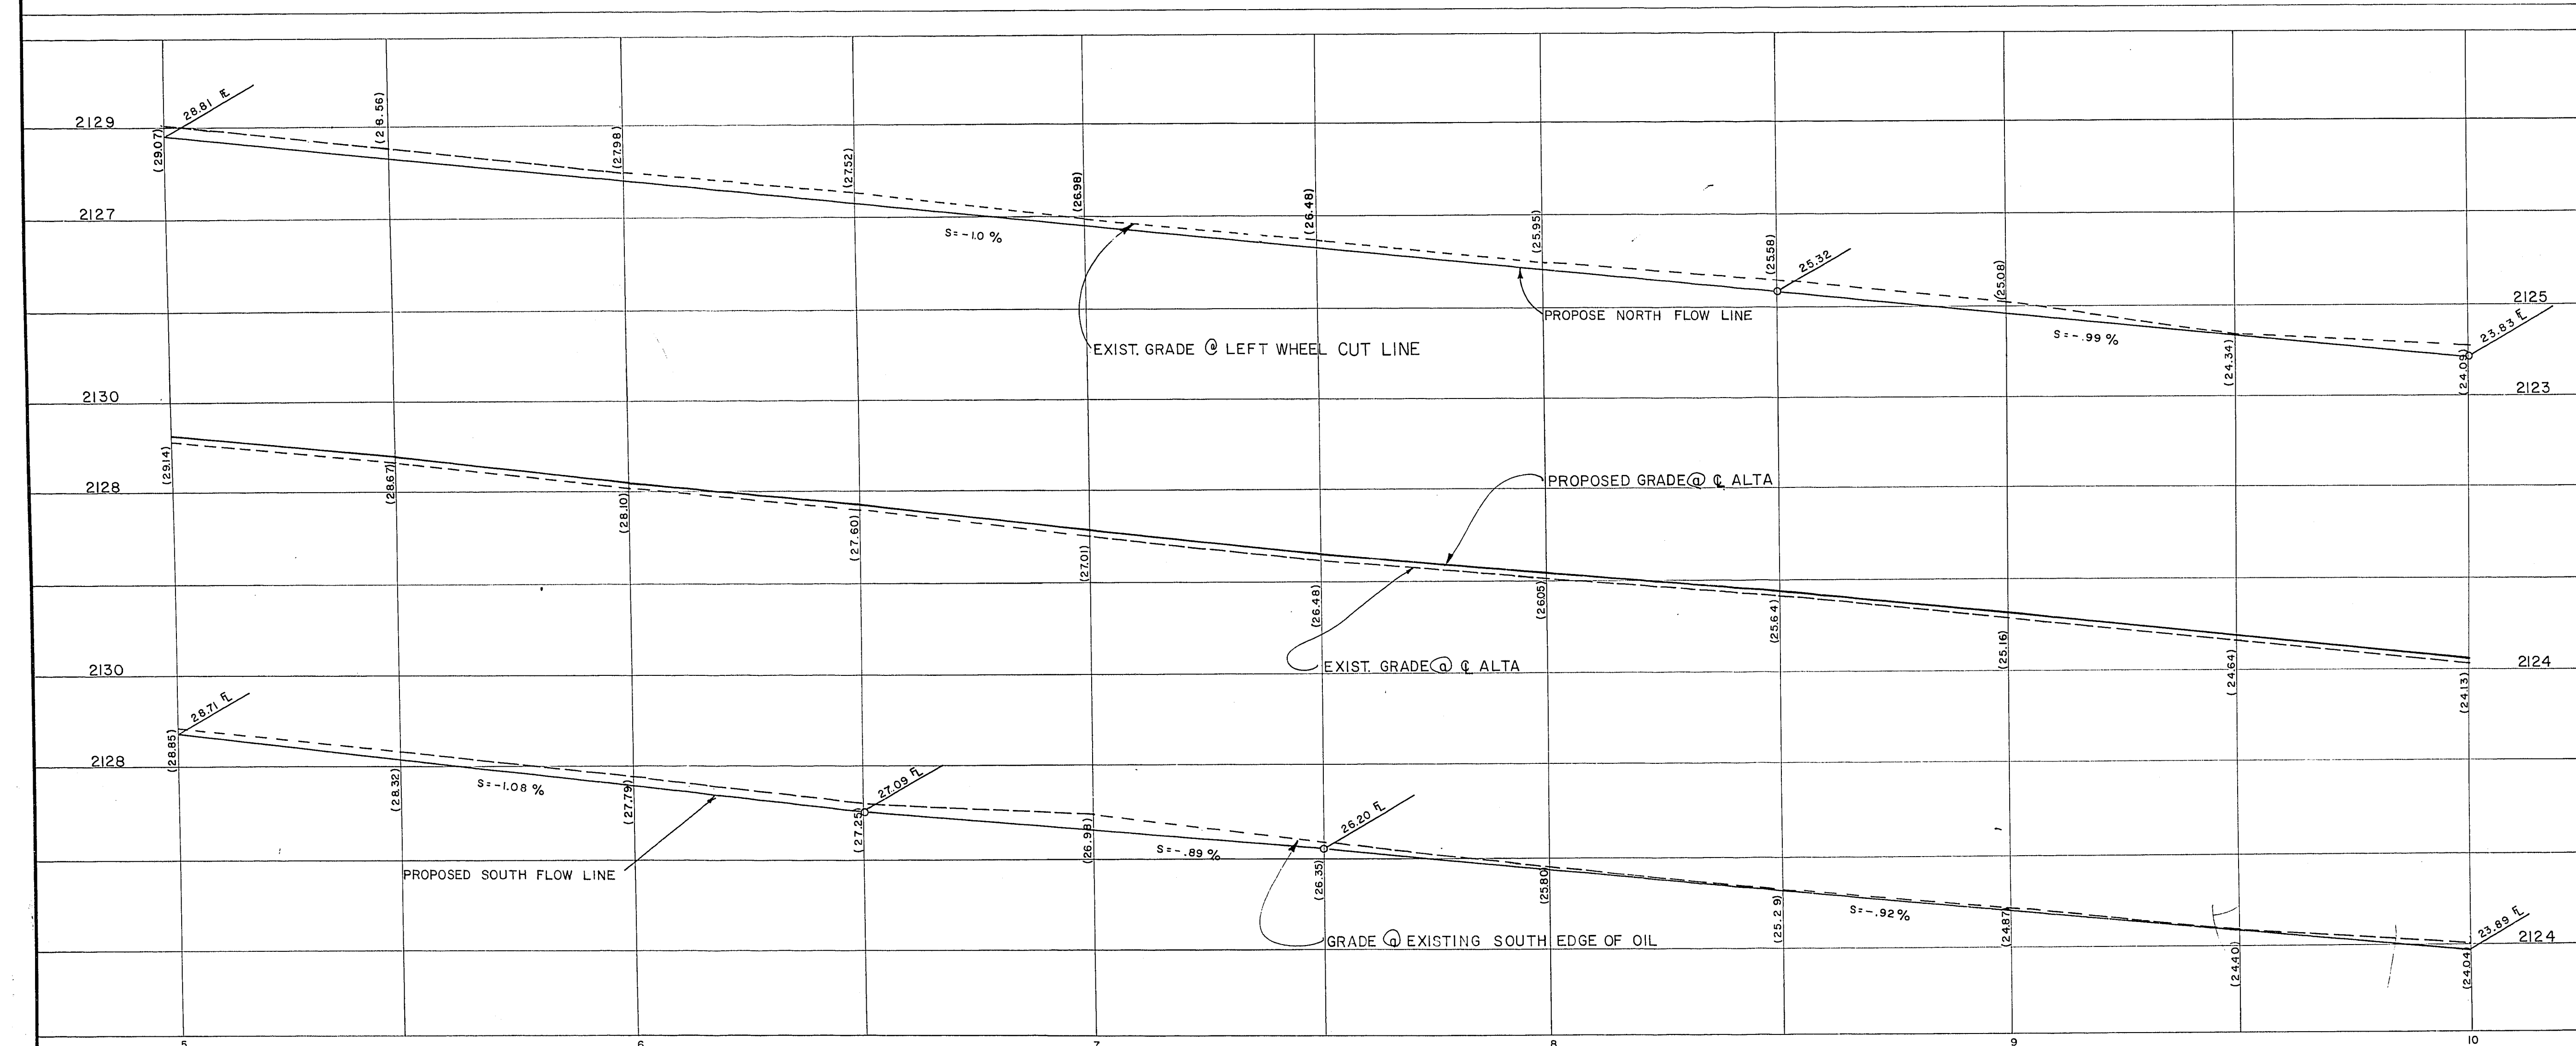

C.P. Buckh
REVISION APPROVED BY R.S.H.
DATE 4-5-78

10/4/77
CONTRACT DRAWING
OCT. 28, 1977

NO.	DESCRIPTION	BY	APPROVED	DATE
(2)	ADD COMM. DRIVEWAYS AND BIKE PATH TO SOUTHSIDE	CK		3/29/78
(1)	ADD C&G TO NORTH & SOUTH SIDES	CK		3/29/78

REVISIONS
CITY OF LAS VEGAS
Department of Public Services
Engineering Design Division

ALTA DRIVE
STA. 5+00 TO STA. 10+00
scale (h) 1"=20'
scale (v) 1"=2'
w.o.no. 7705
f.bk.no. 77-2X
drawing no. 107V-967
design by C. KAJKOWSKI
drawn by S.J.A. & J.A.M.
approved by Director of Public Services
date 11/1/77
sh. 19 of 23