

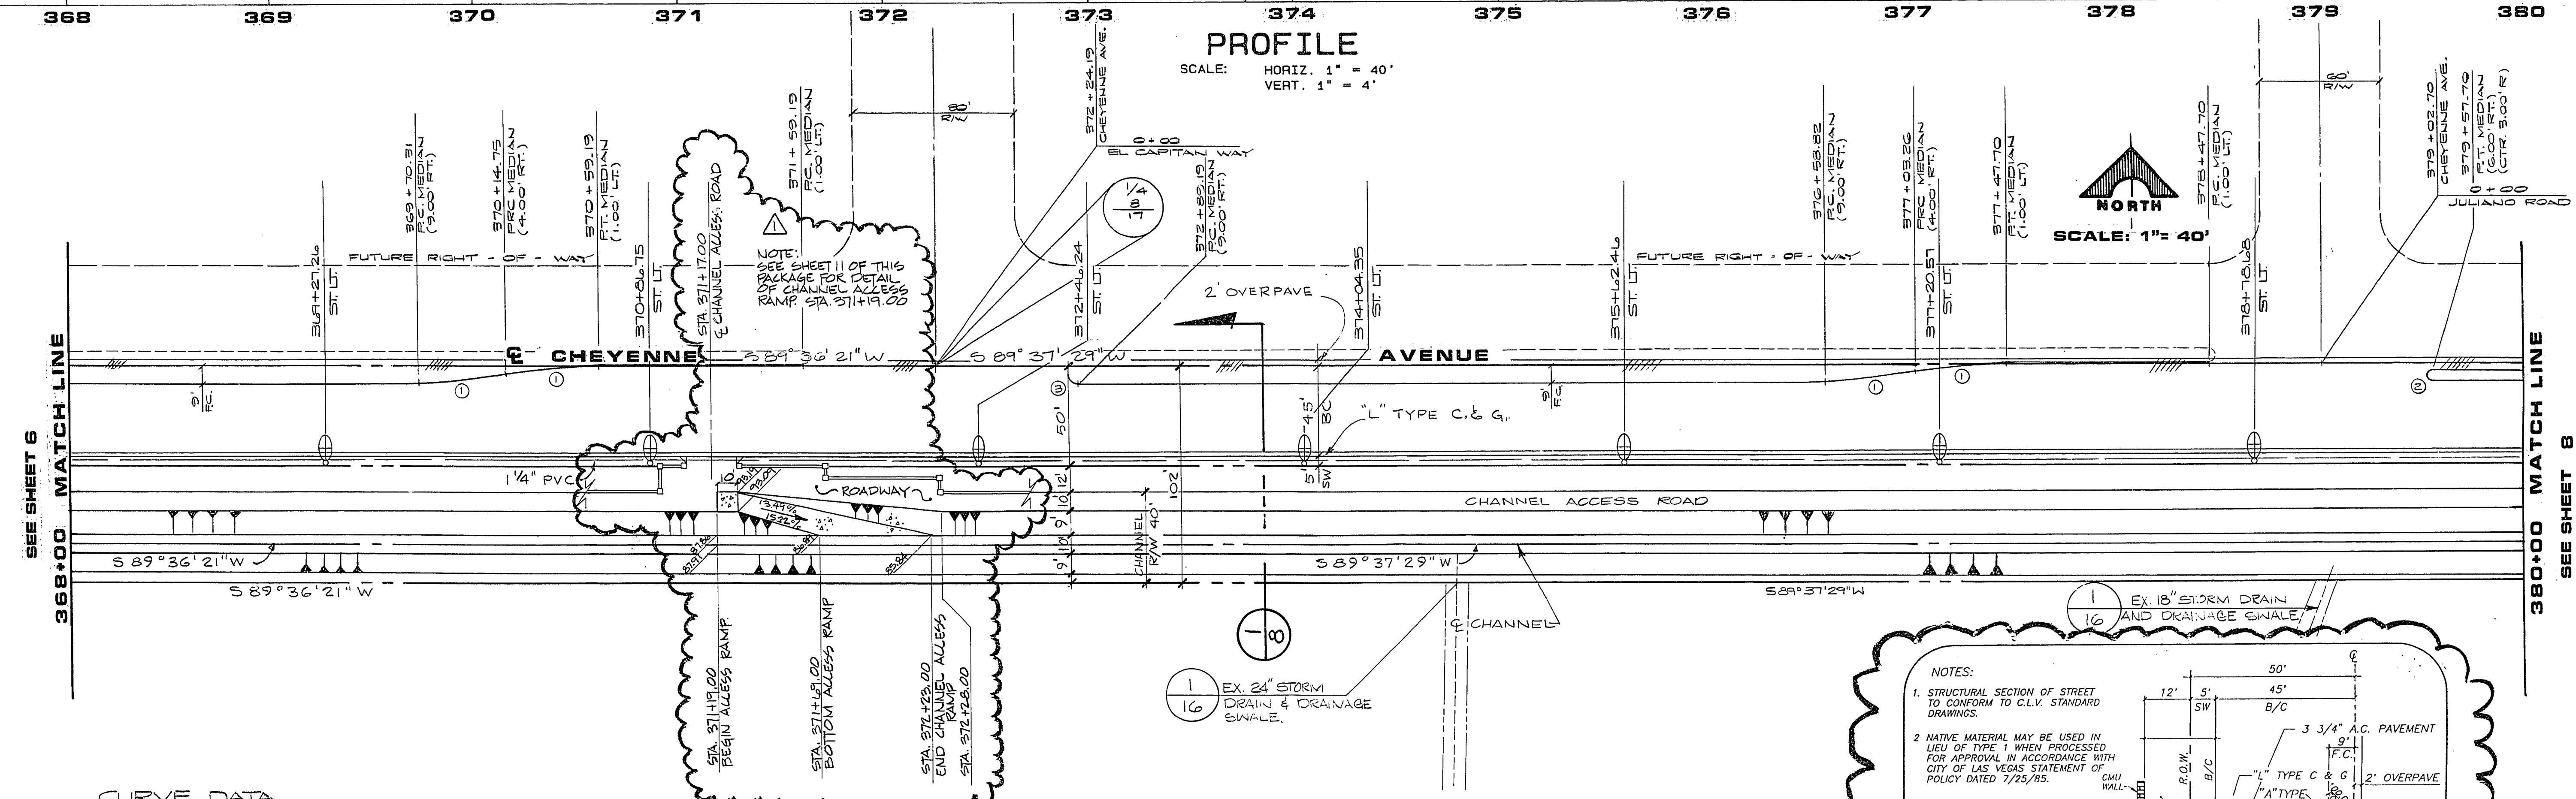


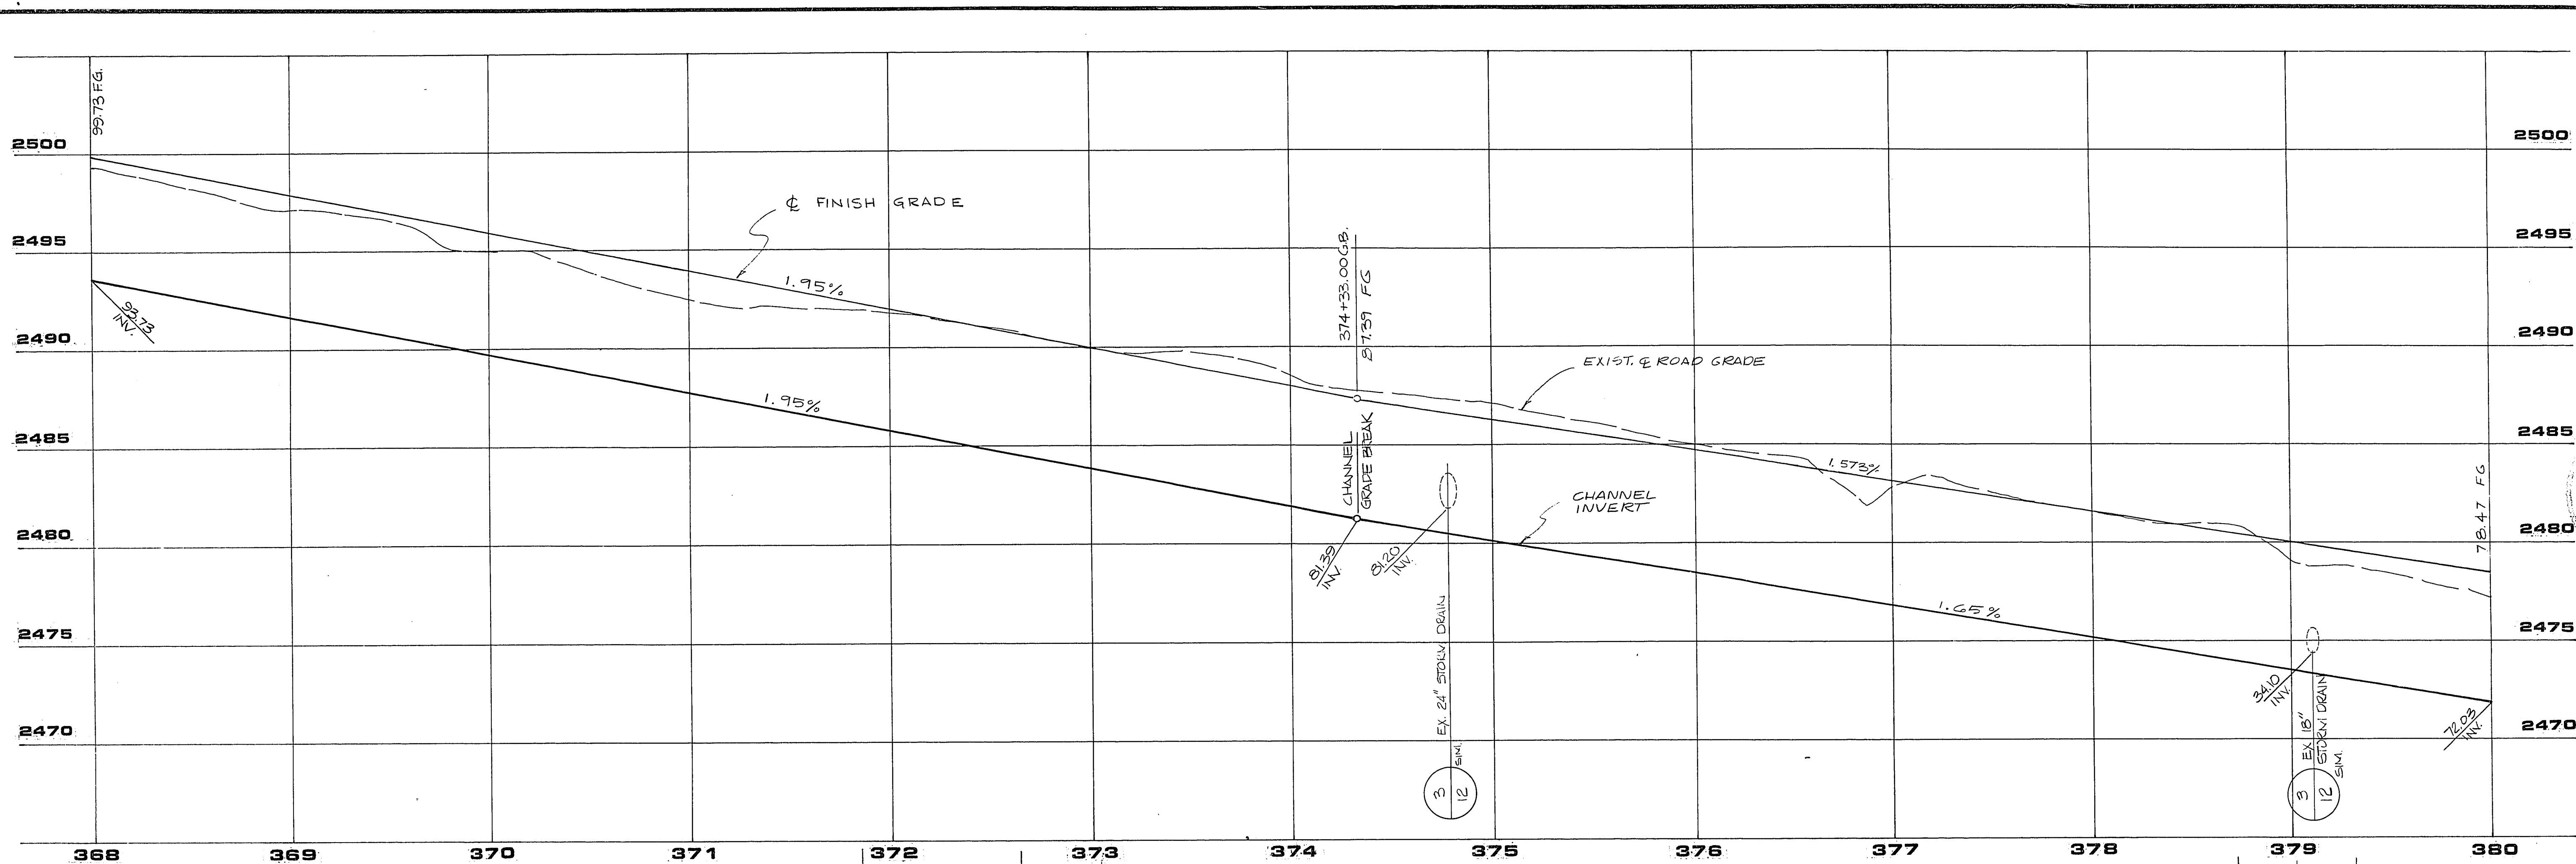

NO.	R	Δ	L	T
1	200.00'	12° 50' 17"	44.81'	22.50'
2	3.00'	180° 00' 00"	3.42'	∞
3	5.00'	90° 00' 00"	7.89'	5.00'

NOTES:

1. STRUCTURAL SECTION OF STREET
TO CONFORM TO C.L.V. STANDARD
DRAWINGS.
- 2 NATIVE MATERIAL MAY BE USED IN
LIEU OF TYPE 1 WHEN PROCESSED
FOR APPROVAL IN ACCORDANCE W/
CITY OF LAS VEGAS STATEMENT OF
POLICY DATED 7/25/85.

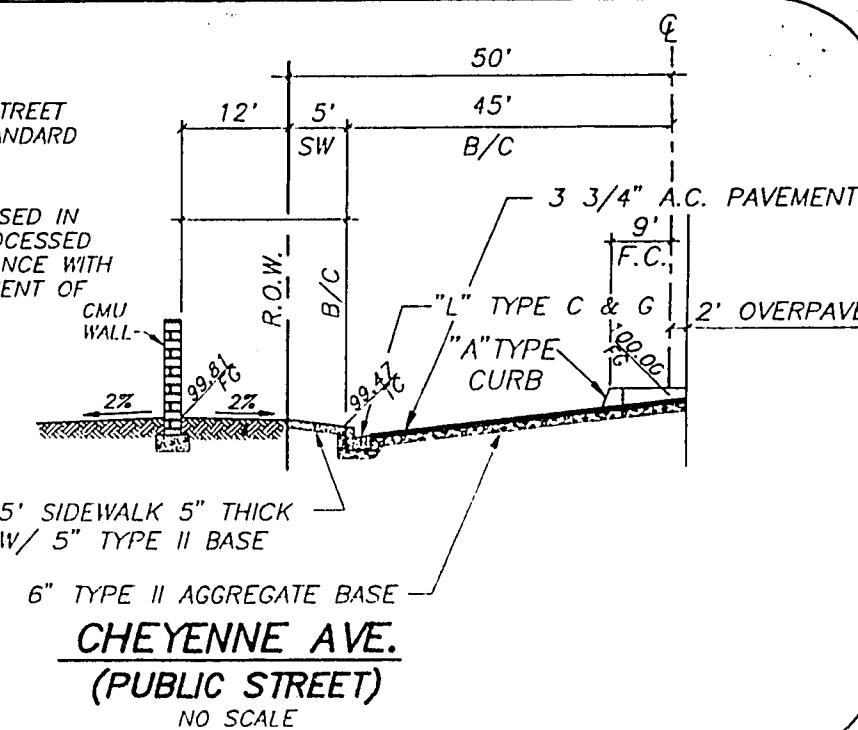

(PUBLIC STREET)
NO SCALE

SHEET		7		OF 17 SHEETS	
DEL E. WEBB COMMUNITIES INC. SUN CITY SUMMERLIN CHEYENNE AVE. & CHEYENNE CHANNEL					
 G.C. WALLACE, INC. Engineering/Architecture		1555 SOUTH RAINBOW BLVD SUITE 200, LAS VEGAS, NEVADA 89102			
RECOMMENDED MICHAEL J. ROSS DATE: 11/11/01		R.O.P. R.E. NO. 3666 M		DATE: 3/26/01	
REVISIONS NO. 1 DATE: 11/11/01		NO. 2 DATE: 11/11/01		NO. 3 DATE: 11/11/01	
