
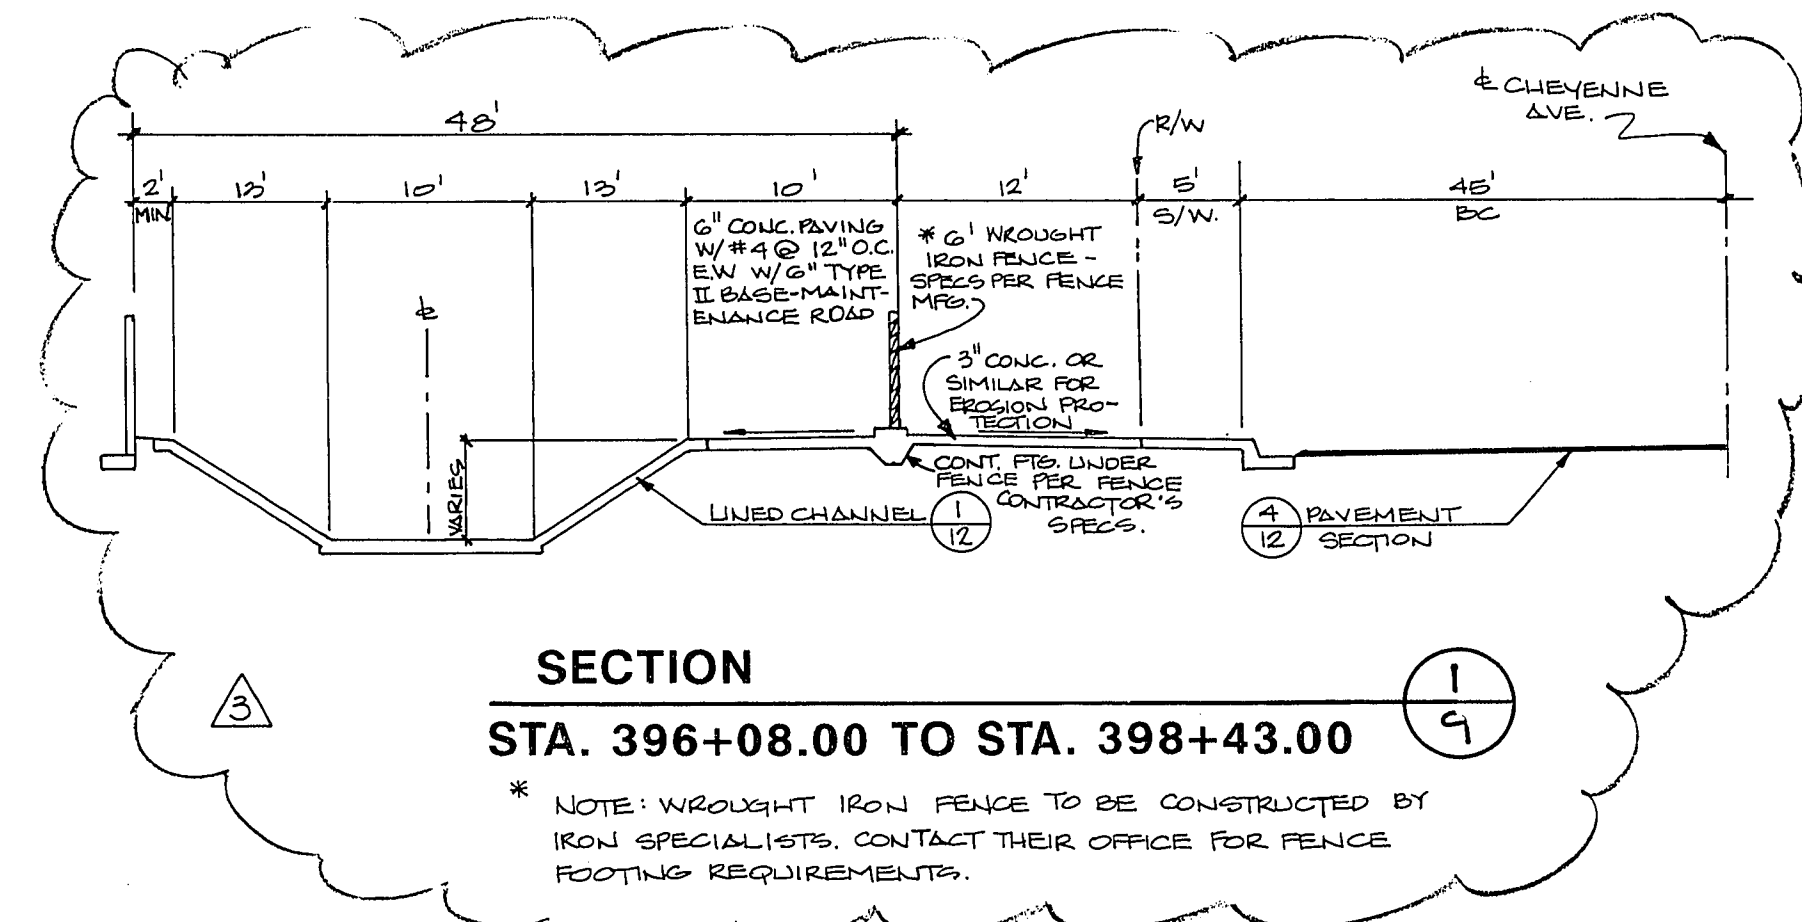


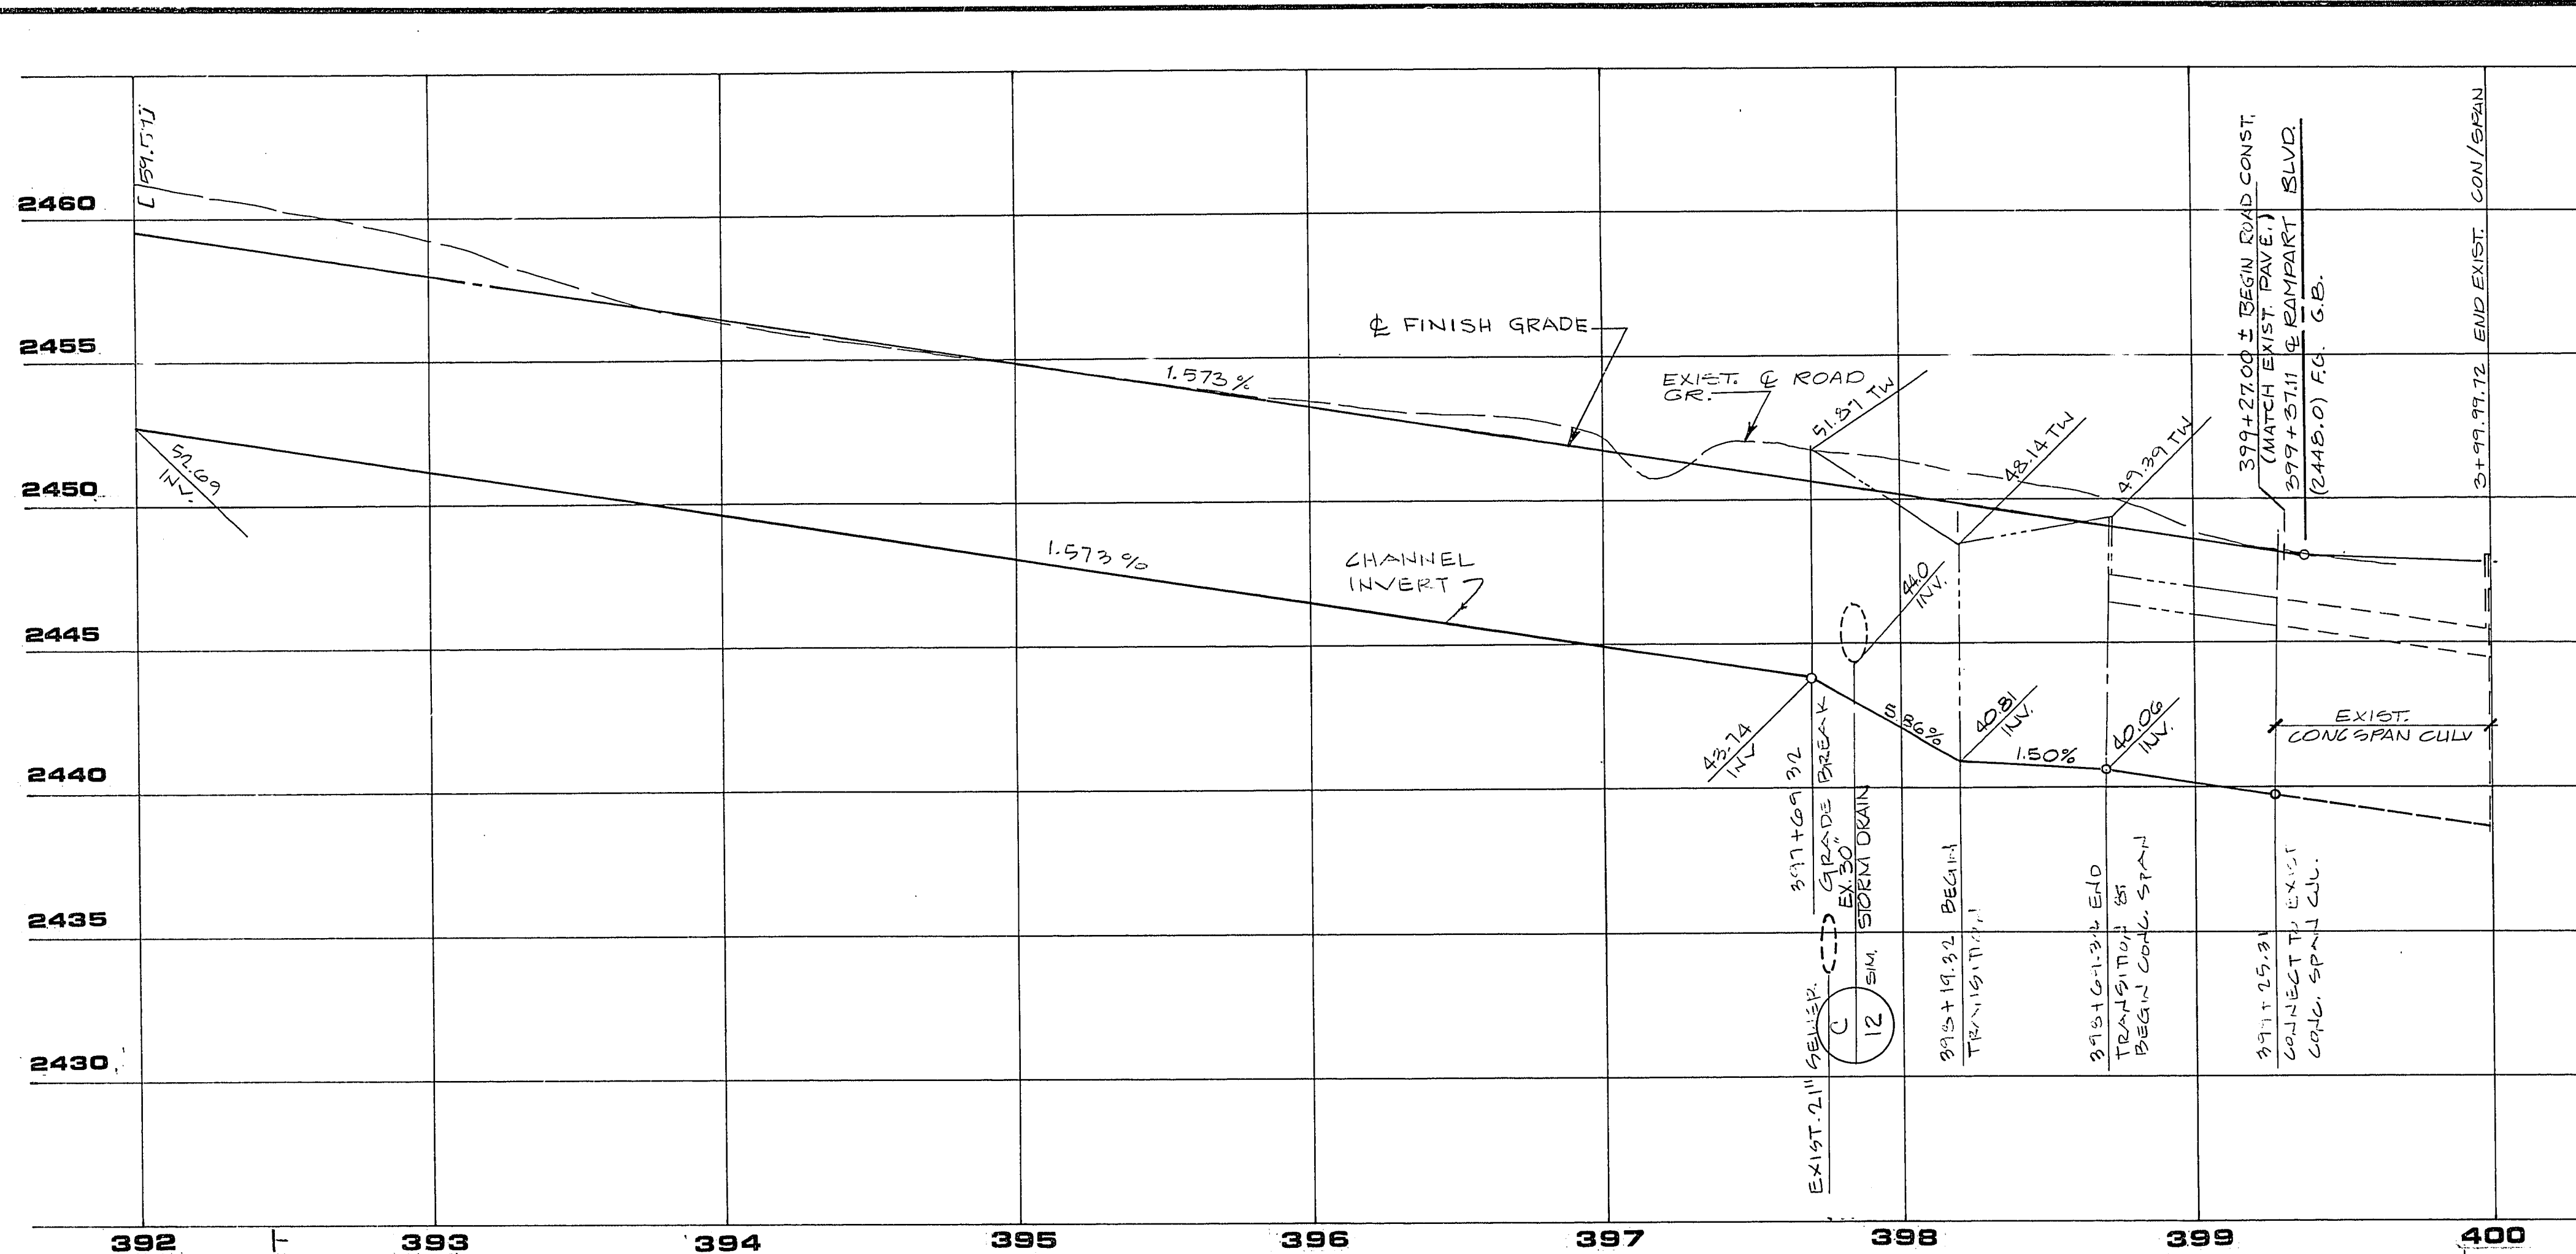


SECTION
STA. 396+08.00 TO STA. 398+43.00

* NOTE: WROUGHT IRON FENCE TO BE CONSTRUCTED BY IRON SPECIALISTS. CONTACT THEIR OFFICE FOR FENCE FOOTING REQUIREMENTS.


PROFILE
SCALE: HORIZ. 1" = 40'
VERT. 1" = 4'

NOTE:
SEE ENLARGED PLAN SHEET
FOR PLAN OF EXISTING CON/SPAN DESIGN
SEE DESERT SHORES PHASE 1-A SHT. C-1
OF 17 SHTS.

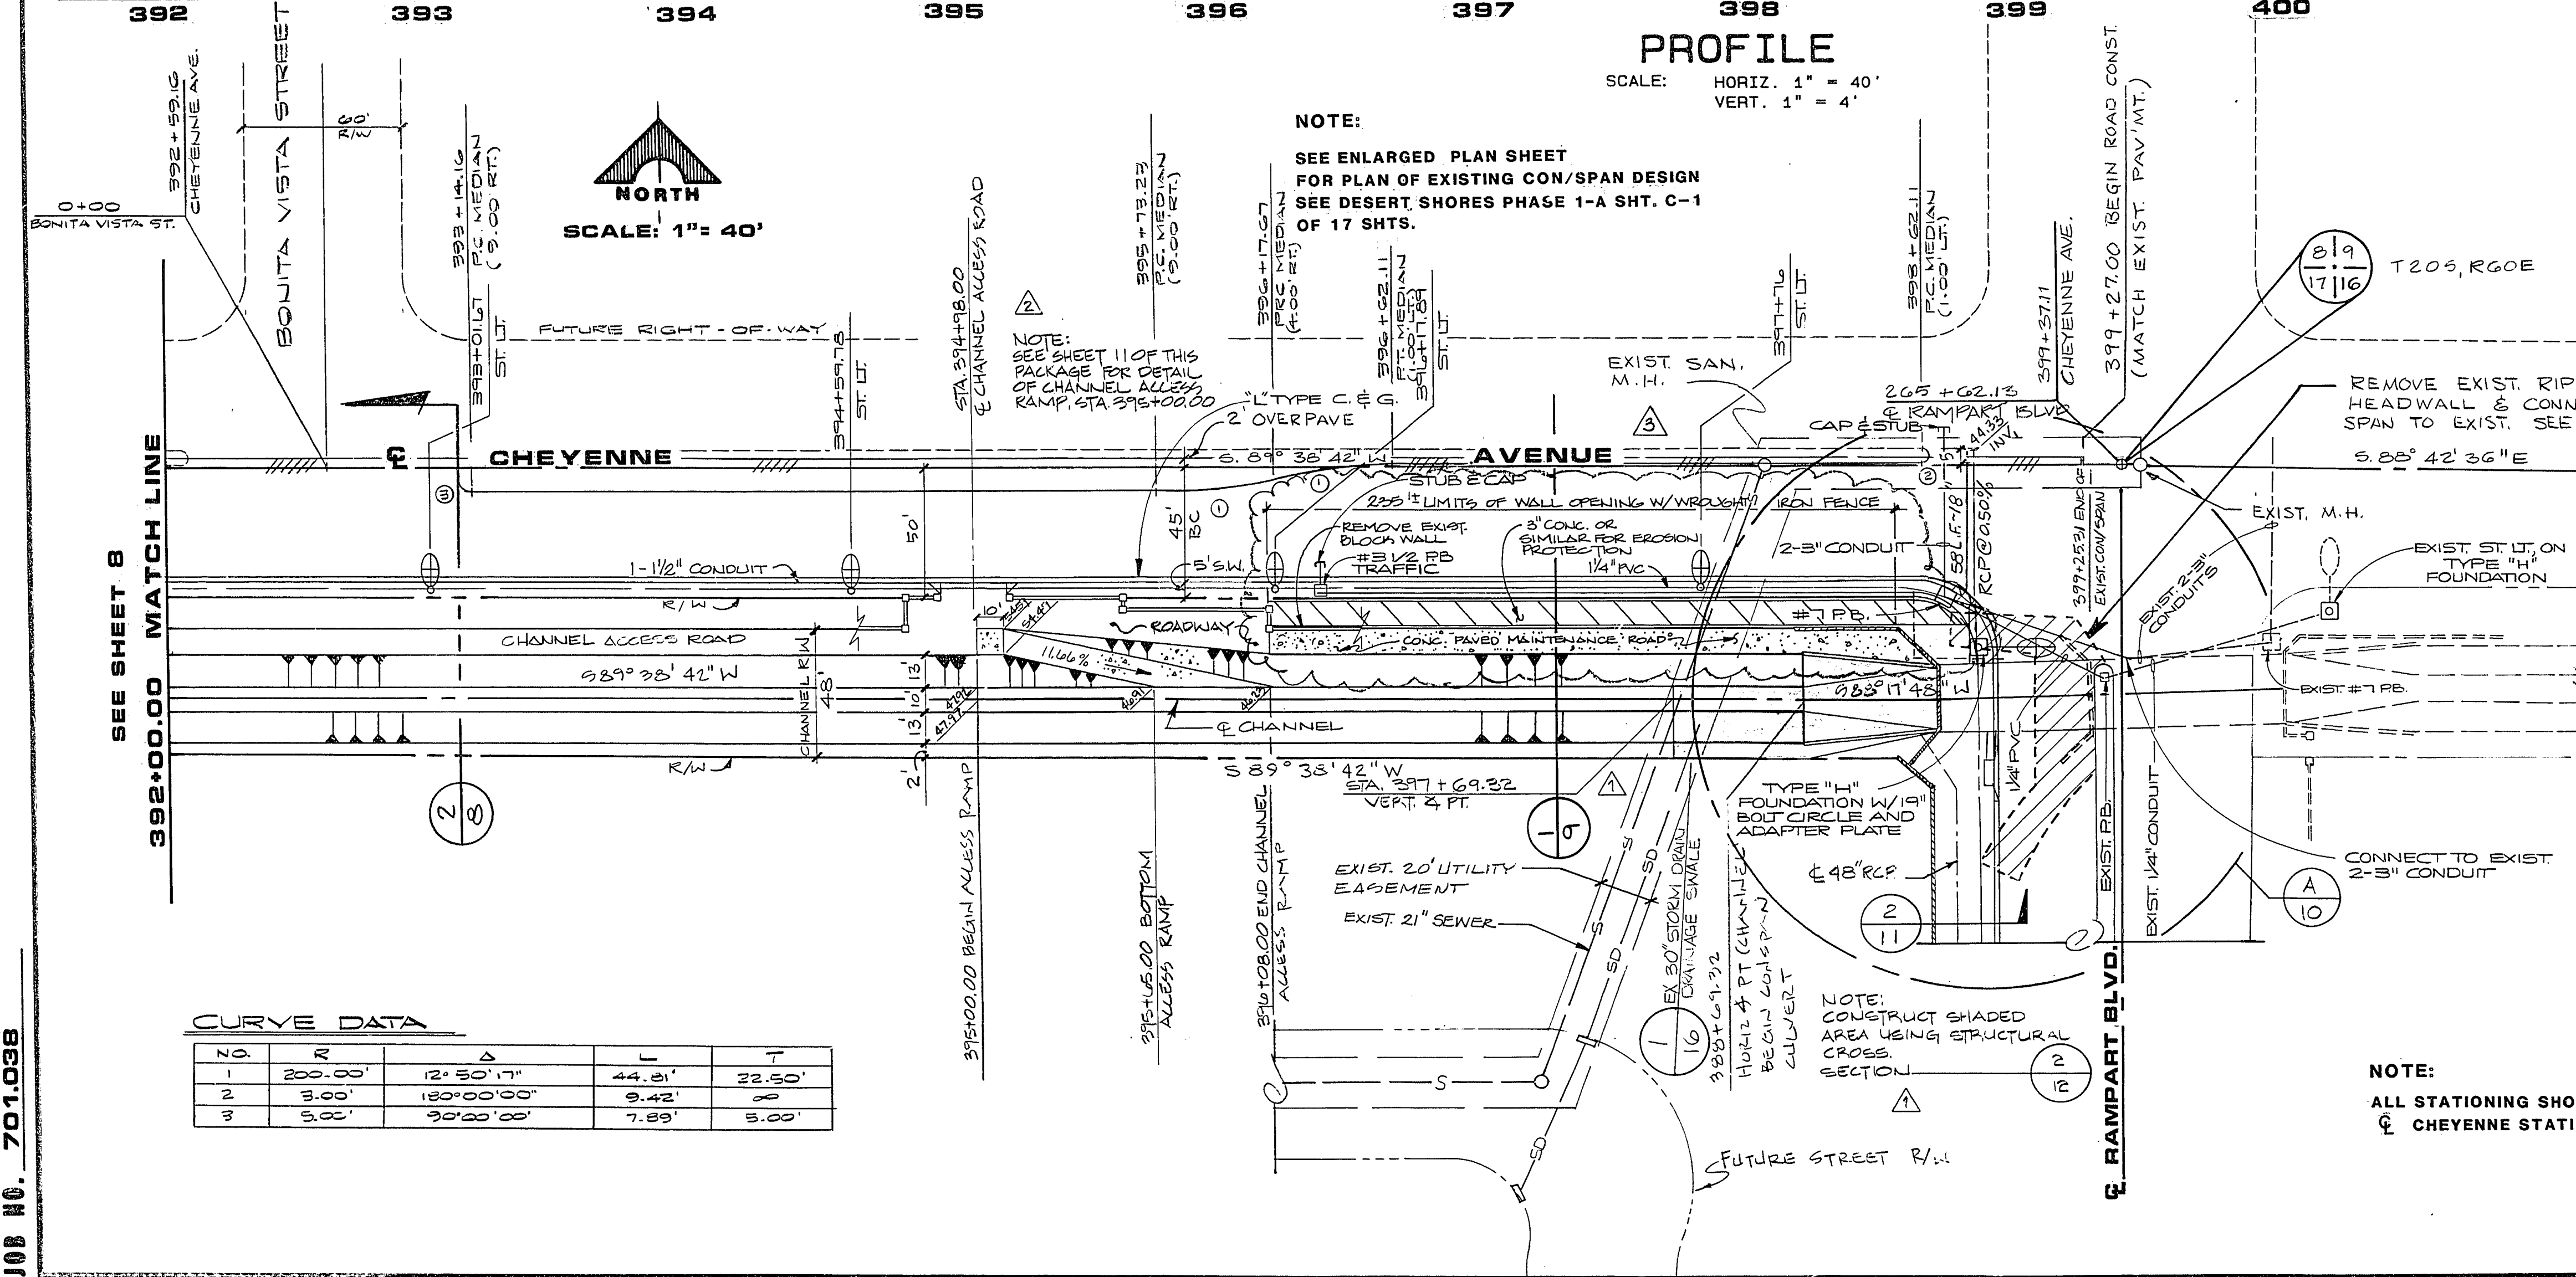

CURVE DATA

NO.	R	Δ	L	T

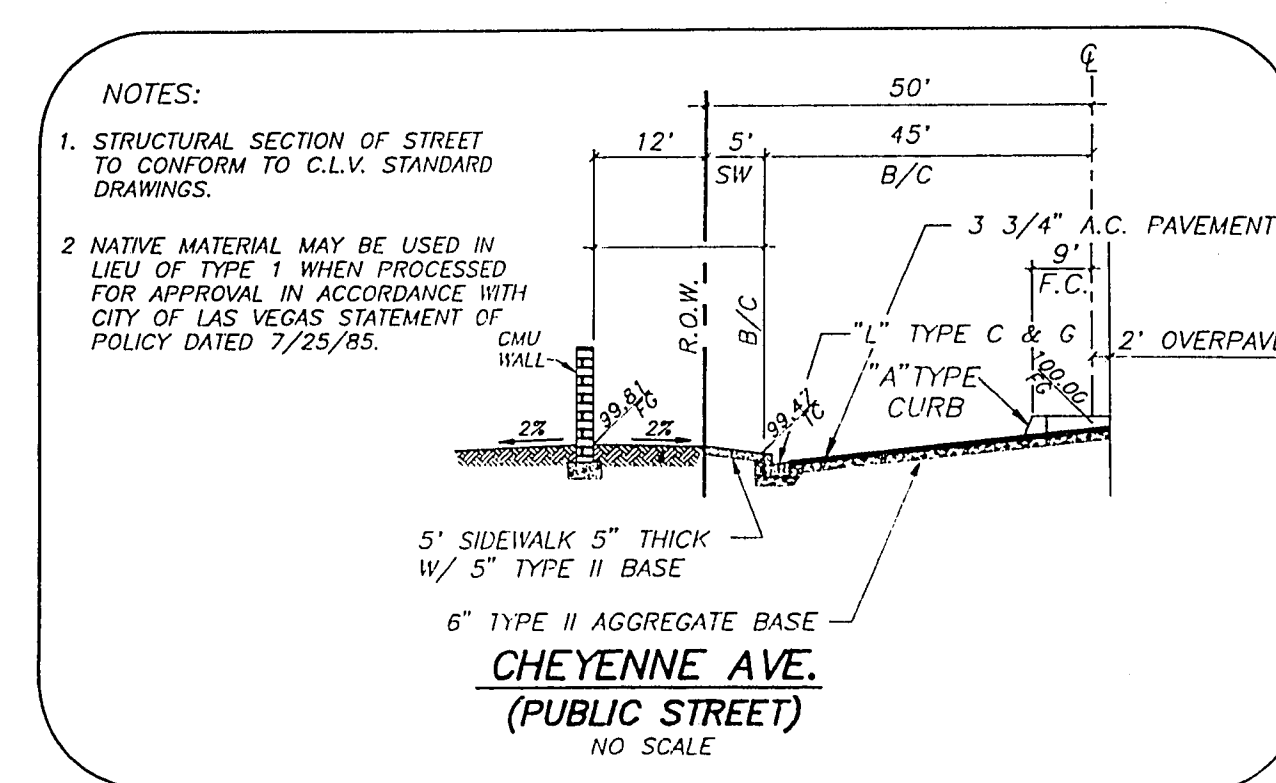

- NOTES:
- STRUCTURAL SECTION OF STREET TO CONFORM TO C.L.V. STANDARD DRAWINGS.
 - NATIVE MATERIAL MAY BE USED IN LIEU OF TYPE 1 WHEN PROCESSED FOR APPROVAL IN ACCORDANCE WITH CITY OF LAS VEGAS STATEMENT OF POLICY DATED 7/25/85.

NOTE:
ALL STATIONING SHOWN IS
CHEYENNE STATIONING

REV	DATE	DESCRIPTION
1	3/10/11	REVISED STRUCTURAL SECTION OF CHANNEL
2	3/10/11	REVISED CHANNEL ACCESS RAMP
3	3/10/11	REVISED CHANNEL ACCESS RAMP
RECOMMENDED
MICHAEL R. BROS
1555 SOUTH RAINBOW BLVD LAS VEGAS, NEVADA 89102

G.C. WALLACE, INC.
Engineering/Architecture

DEL E. WEBB COMMUNITIES INC.
SUN CITY SUMMERLIN
CHEYENNE AVE. & CHEYENNE CHANNEL
STA. 392+00 TO STA. 399+25.31

SHEET
9
OF 17 SHEETS