



GENERAL NOTES:

- CONSTRUCTION SPECIFICATIONS: SHALL BE UNIFORMED STANDARD SPECIFICATIONS FOR PUBLIC WORKS CONSTRUCTION OFFSITE IMPROVEMENTS, CLARK COUNTY AREA, NEVADA, 1986.
- LIVE LOAD: HS20-44 AASHTO LOADING.
- CONCRETE: CAST-IN-PLACE CONCRETE SHALL HAVE AN ULTIMATE COMPRESSIVE STRENGTH FS=3000 PSI AT 28 DAYS. ALL EXPOSED EDGES SHALL BE CHAMFERED 3/4".
- CON-SPAN UNITS: SHALL BE SUPPLIED BY HYDRO-CONDUIT CORPORATION. INSTALLATION SHALL BE IN ACCORDANCE WITH CON-SPAN SPECIFICATIONS.
- REINFORCING STEEL: ALL REINFORCING SHALL MEET THE REQUIREMENTS OF ASTM A615 GRADE 60. THE MINIMUM CLEARANCE, MEASURED FROM THE FACE OF THE CONCRETE TO THE SURFACE OF ANY REINFORCING BAR SHALL BE 2" EXCEPT WHERE OTHERWISE NOTED.
- MASONRY: MASONRY UNITS TO BE GRADE IN HOLLOW UNITS. MORTAR TO BE TYPE M, GROUT-F' C=2000 PSI.
- SOIL ENGINEERING: REFER TO THE CURRENT SOILS REPORT FOR ANY QUESTIONS REGARDING SOILS REQUIREMENTS. REPORT BY: WESTERN TECHNOLOGIES, INC., DATED: PROJECT NO.:
- CONTRACTOR TO VERIFY EXACT LOCATION OF ALL UTILITIES BEFORE CONSTRUCTION.

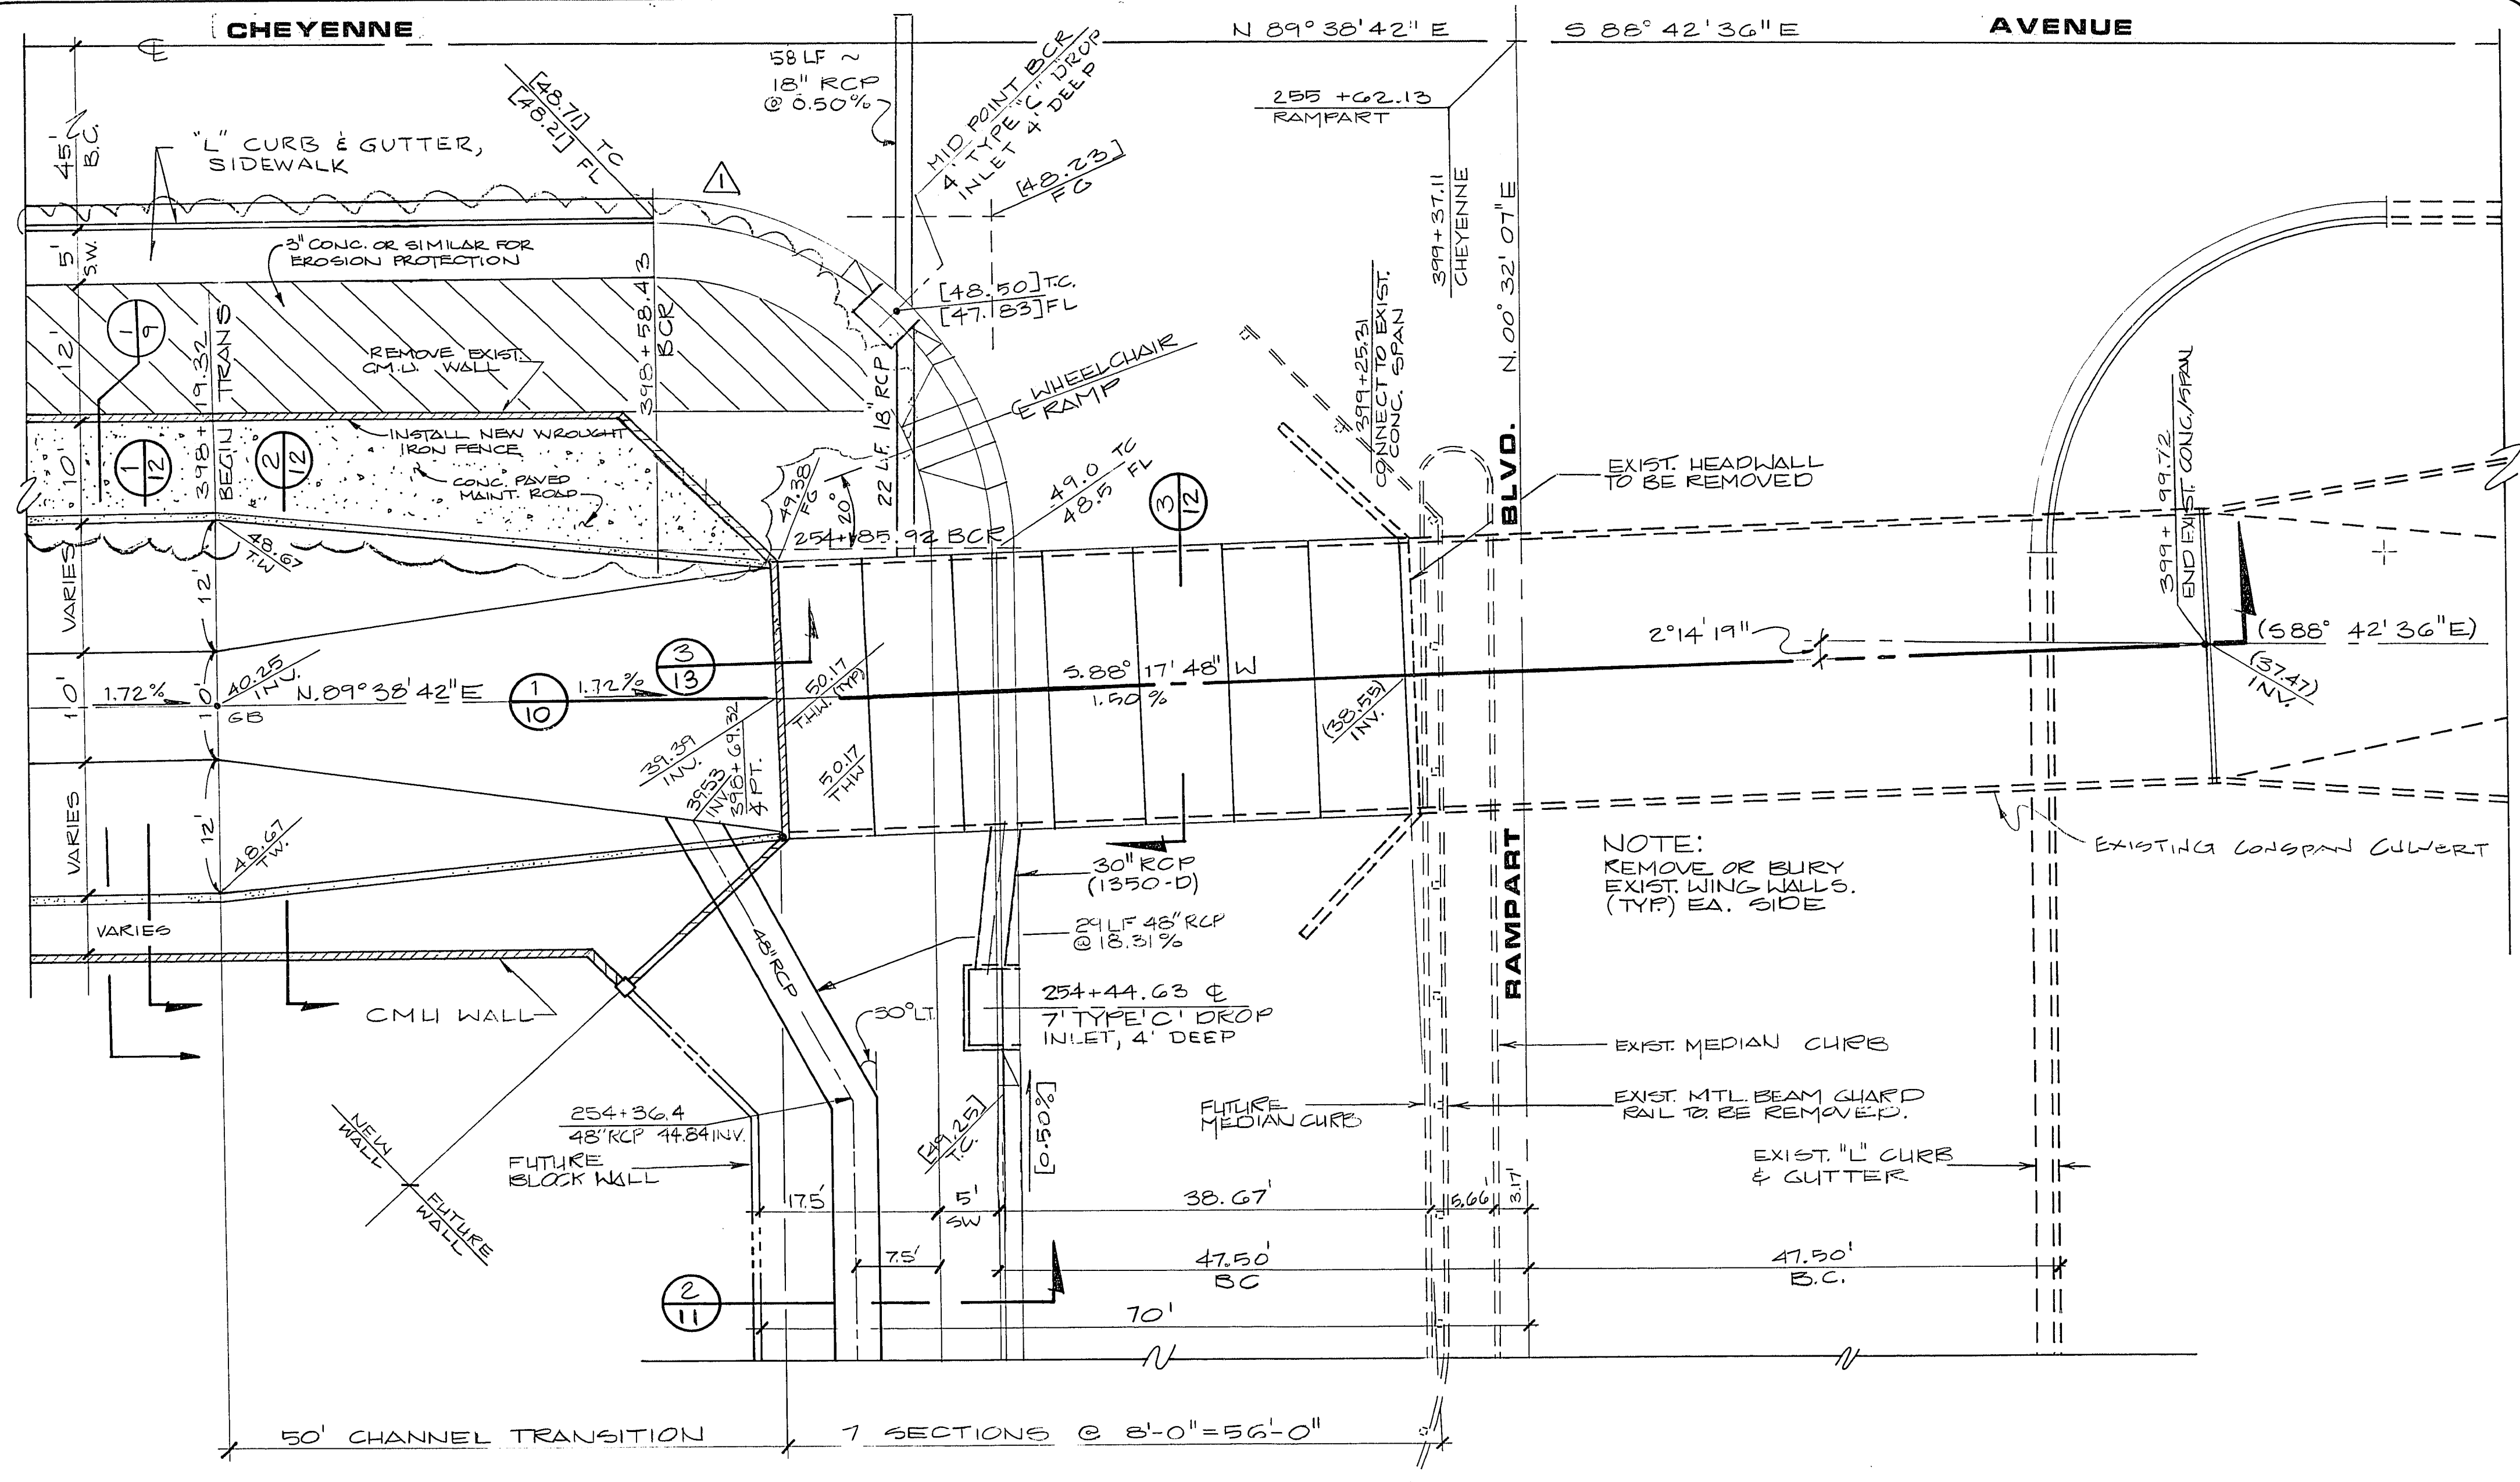

ENLARGED PLAN
SCALE: 1" = 10'

A
10

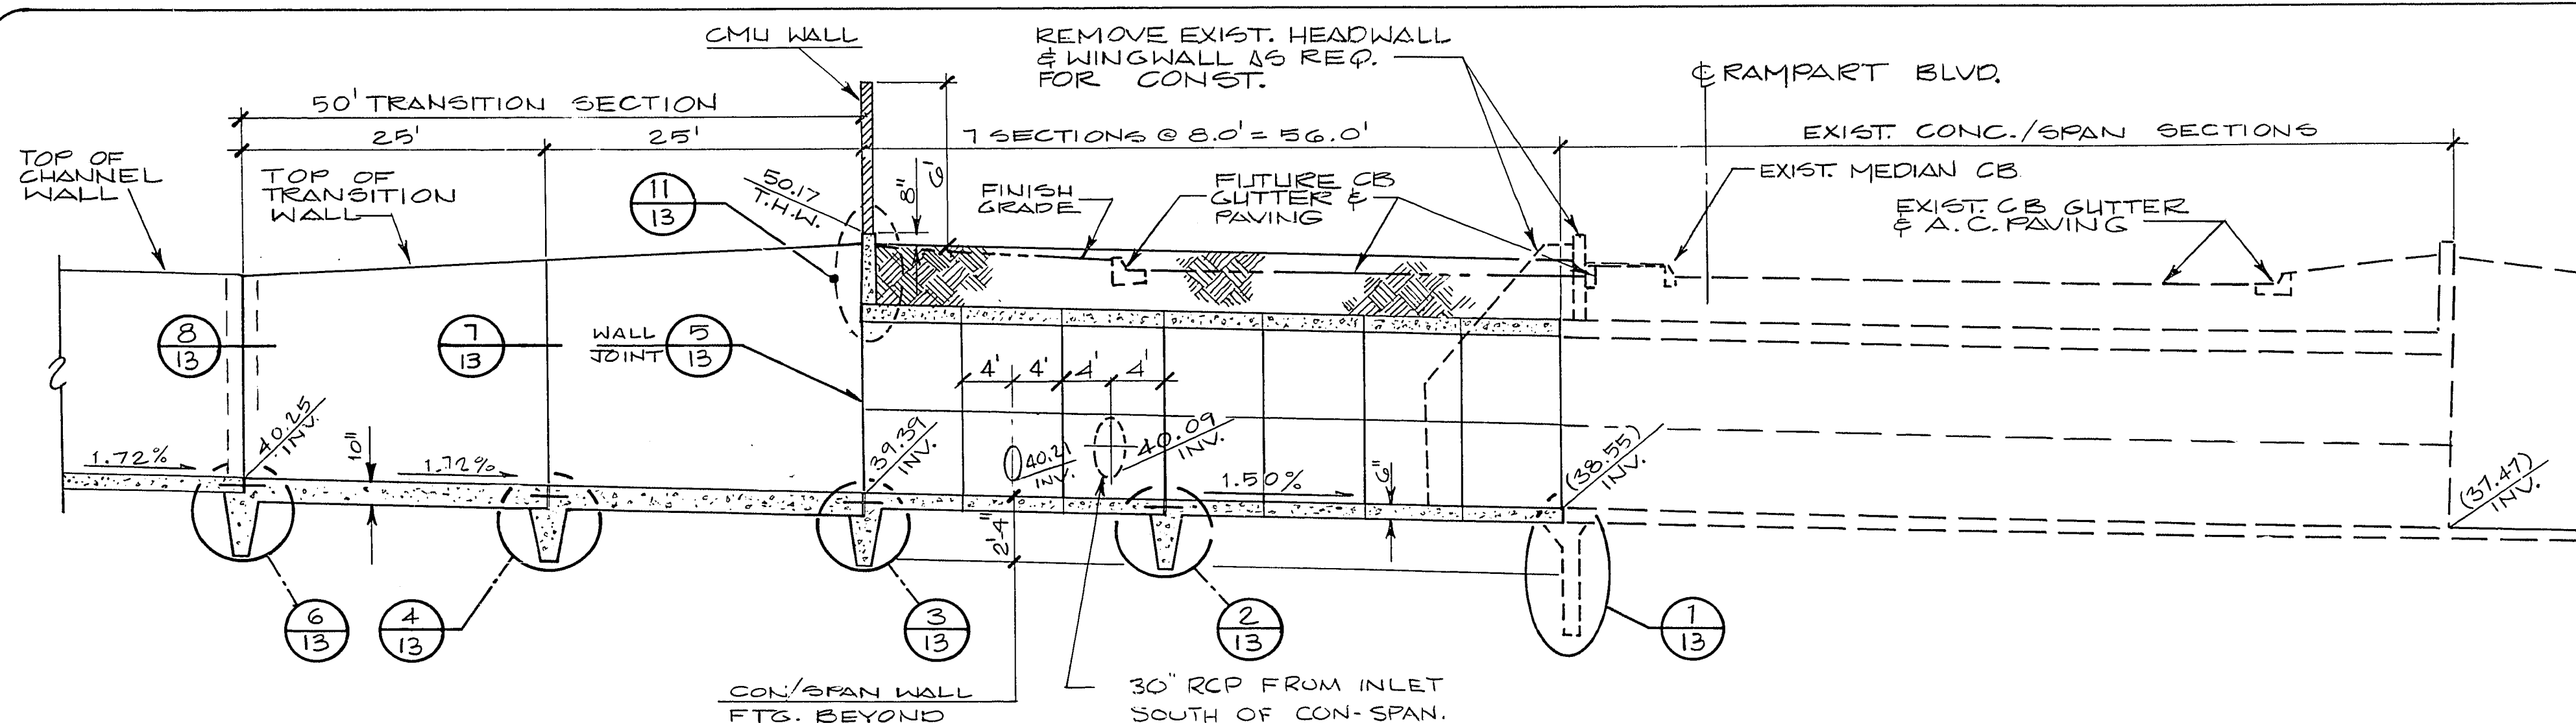

SECTION
HORIZONTAL: 1" = 10'
VERTICAL: 1" = 6'

1
10

REV	DATE	DESCRIPTION
RECOMMENDED BY: *[Signature]*
MICHAEL D. ROSS, P.E.
1555 SOUTH RAINBOW BLVD., LAS VEGAS, NEVADA 89102

G.C. WALLACE, INC.
Engineering/Architecture

DEL E. WEBB COMMUNITIES INC.
SUN CITY SUMMERLIN
CHEYENNE AVE. & CHEYENNE CHANNEL
ENLARGED PLAN AND SECTION

SHEET
10
OF 17 SHEETS