


JOB NO. 412.350

MATCHLINE-STA. 121+20.00-SEE SHT. SD-13

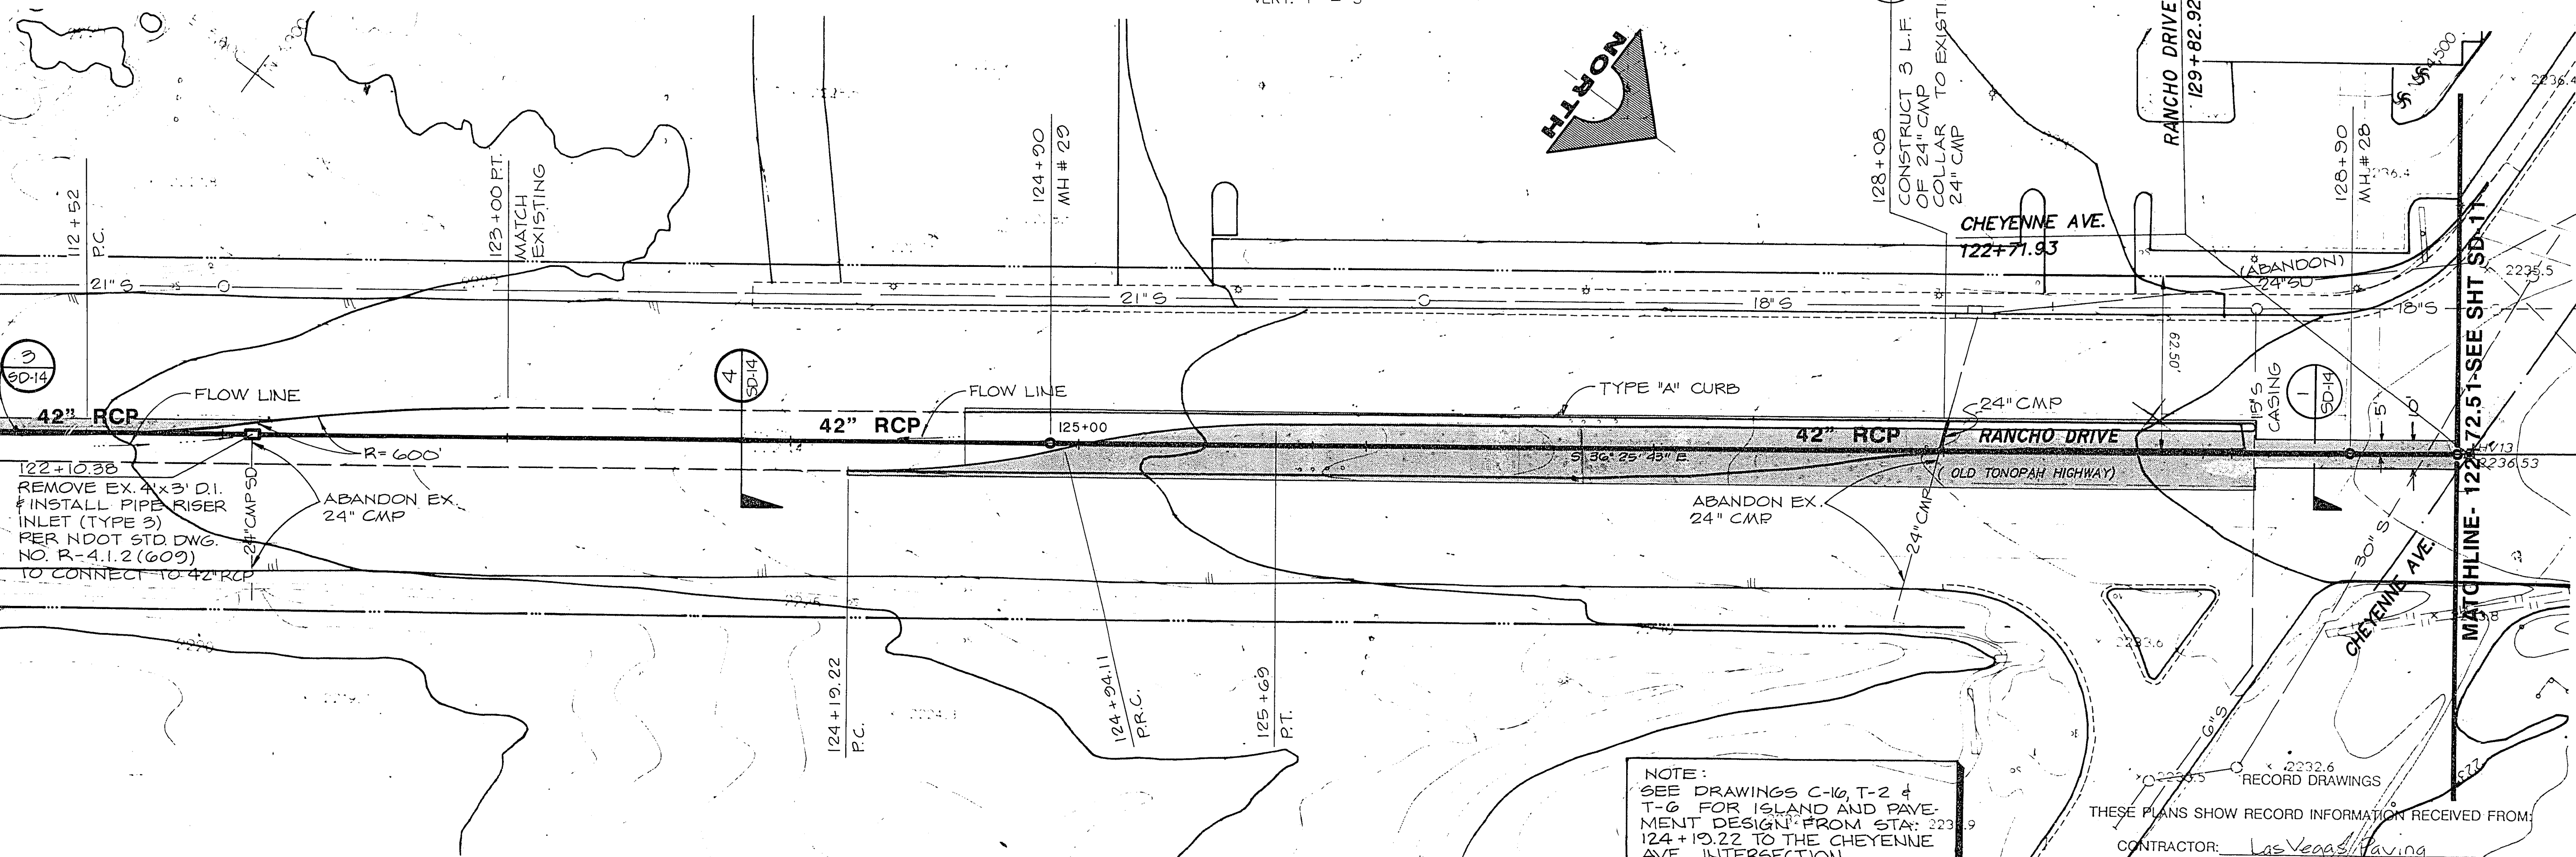


RANCHO DRIVE

PLAN
SCALE: HORIZ. 1" = 30'

PROFILE

SCALE: HORIZ. 1" = 30'
VERT. 1" = 3'

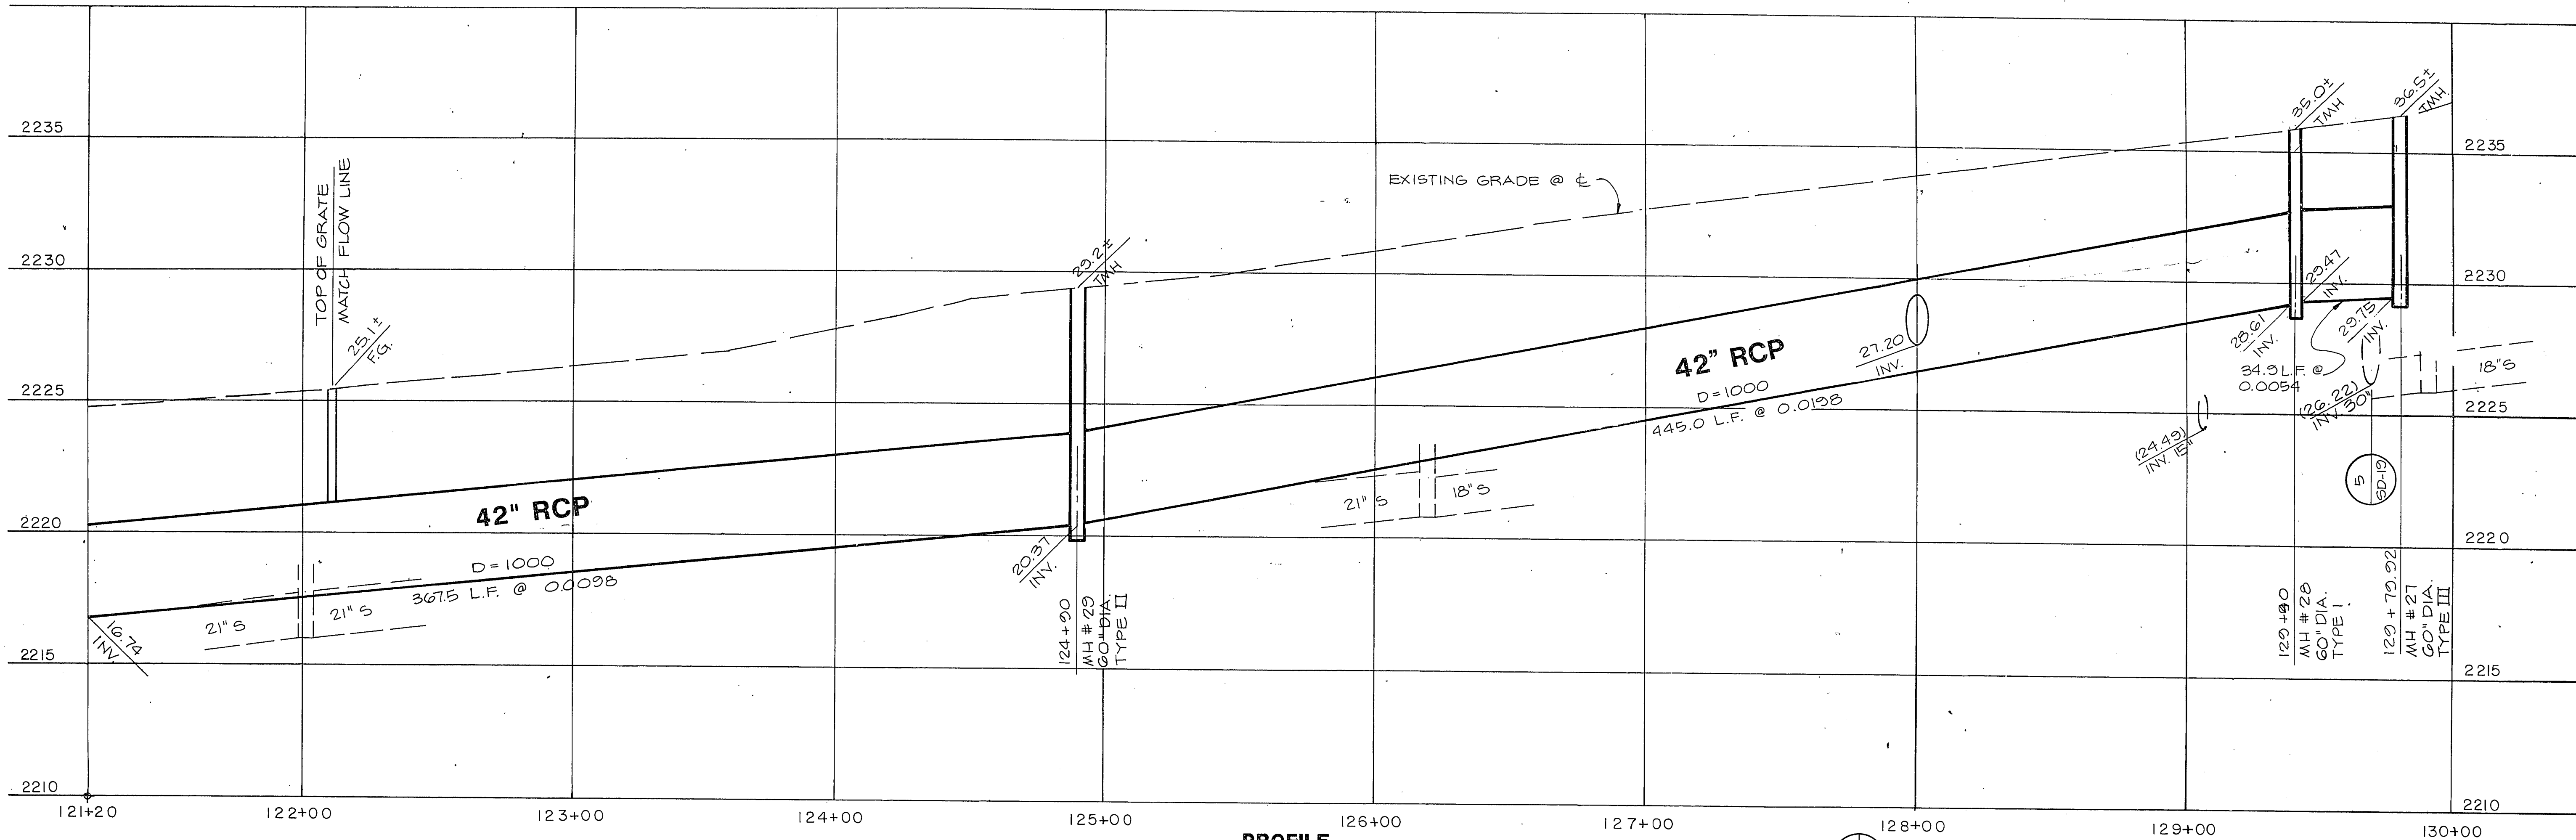

NOTE:

THESE PLANS SHOW RECORD INFORMATION RECEIVED FROM:

DATE: 2/24/93

THIS DATA MAY OR MAY NOT REFLECT THE ACTUAL FIELD LOCATIONS. ALL DATA SHOULD BE CONFIRMED PRIOR TO USE ON DEVELOPMENT OR ENGINEERING PLANS.

107-V1776

SHEET

SD-12

OF 52 SHEETS

G.C. WALLACE, INC.
Engineering/Architecture

CITY OF LAS VEGAS
CHEYENNE AVENUE
STORM DRAIN PLAN & PROFILE
STA. 121+20.00 TO STA. 122+72.51

REV	DATE	DESCRIPTION
1	1-14-92	DATE
2	1-14-92	DATE
