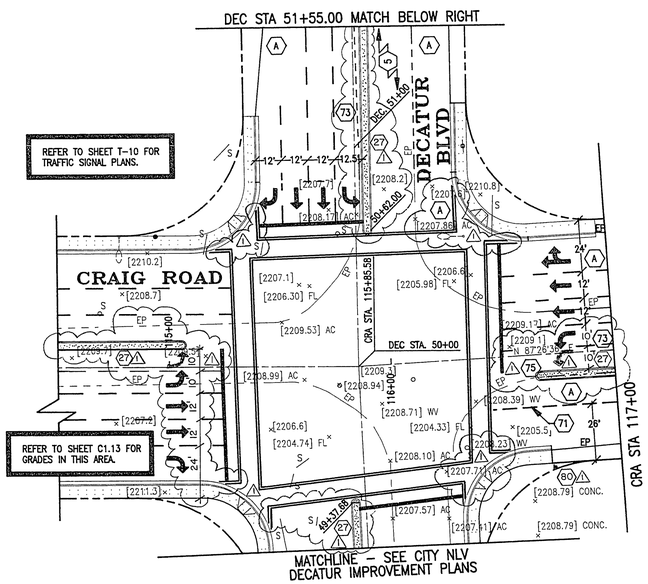

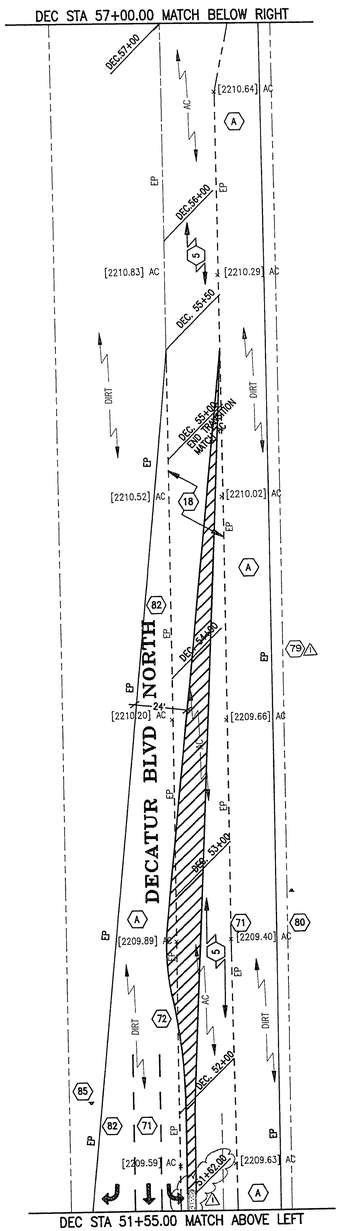

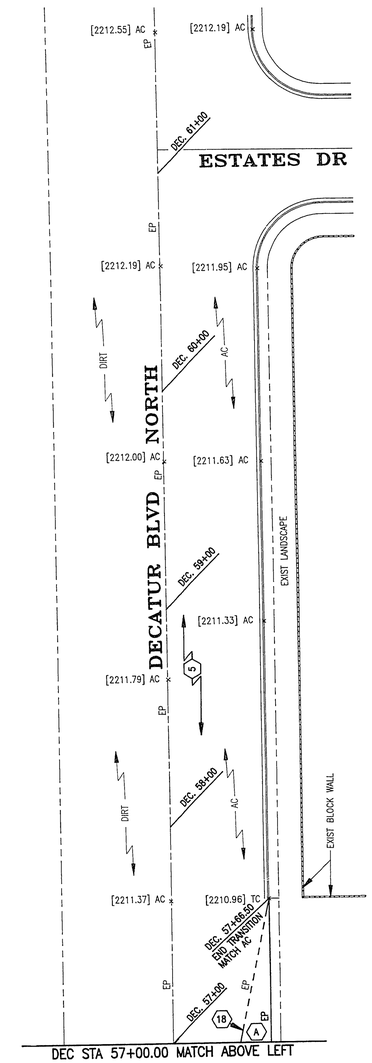

NORTH
SCALE 1" = 30'

NOTE Ⓐ:

CONTRACTOR TO INSTALL AN ASPHALT TRANSITION WHICH MATCHES THE EXISTING EDGE OF PAVEMENT. TRANSITION TO HAVE A 2% MINIMUM CROSS SLOPE. REFER TO IMPROVEMENT NOTE #10 FOR MORE INFORMATION.

DATE	REVISION
11-29-91	1 PER CITY COMMENTS DATED 11-26-91

HEFNER ENGINEERING
CIVIL ENGINEERING • DESIGN
LAND PLANNING & DEVELOPMENT
4441 South Polaris Avenue, Las Vegas, Nevada 89103
Phone: (702) 798-1900

CRAIG ROAD
INTERSECTION DRAWING
DECATUR BOULEVARD AND CRAIG ROAD

SHEET NO.
C2.4
107-V1804
DE-68421 DATE: 11/07/91

23-3-123

SHT. 22/66