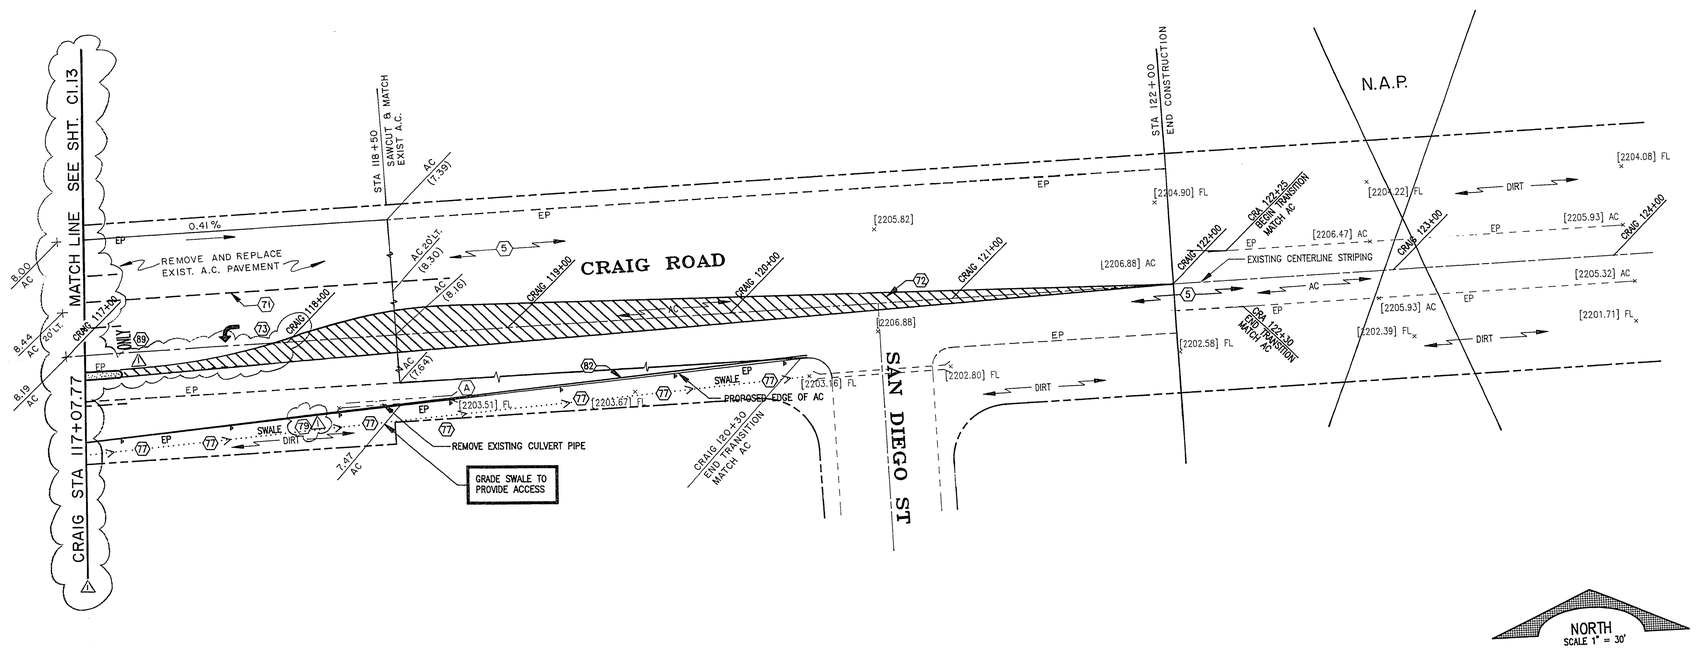

NOTE (A):

CONTRACTOR TO INSTALL AN ASPHALT TRANSITION WHICH MATCHES THE EXISTING EDGE OF PAVEMENT. TRANSITION TO HAVE A 2% MINIMUM CROSS SLOPE. REFER TO IMPROVEMENT NOTE #10 FOR MORE INFORMATION.

DATE	REVISION
9-14-95	1 LANDSCAPE MEDIAN FOR ADJAC. LANE, ADDED LANDSCAPE, ADDED ADA RAMP, CHANGED CONSTRUCTION NOTE
11-16-95	2 ADDED CONSTRUCTION NOTE, CHANGED CONSTRUCTION NOTE

PROFESSIONAL ENGINEER STATE OF NEVADA
WILLIAM E. BURTON
CIVIL
Date Expires 12-31-95
No. 3215

HEFFNER ENGINEERING
CIVIL ENGINEERING • DESIGN
LAND PLANNING & DEVELOPMENT
4441 South Pecos Avenue, Las Vegas, Nevada 89103
Phone: (702) 798-1900

CRAIG ROAD INTERSECTION DRAWING

CRAIG ROAD EAST OF DECATUR BOULEVARD

SHEET NO.

C2.5

107-V1804

DEC-39-92 DATE 11/07/93

SHT. 23/66

23-3-124