



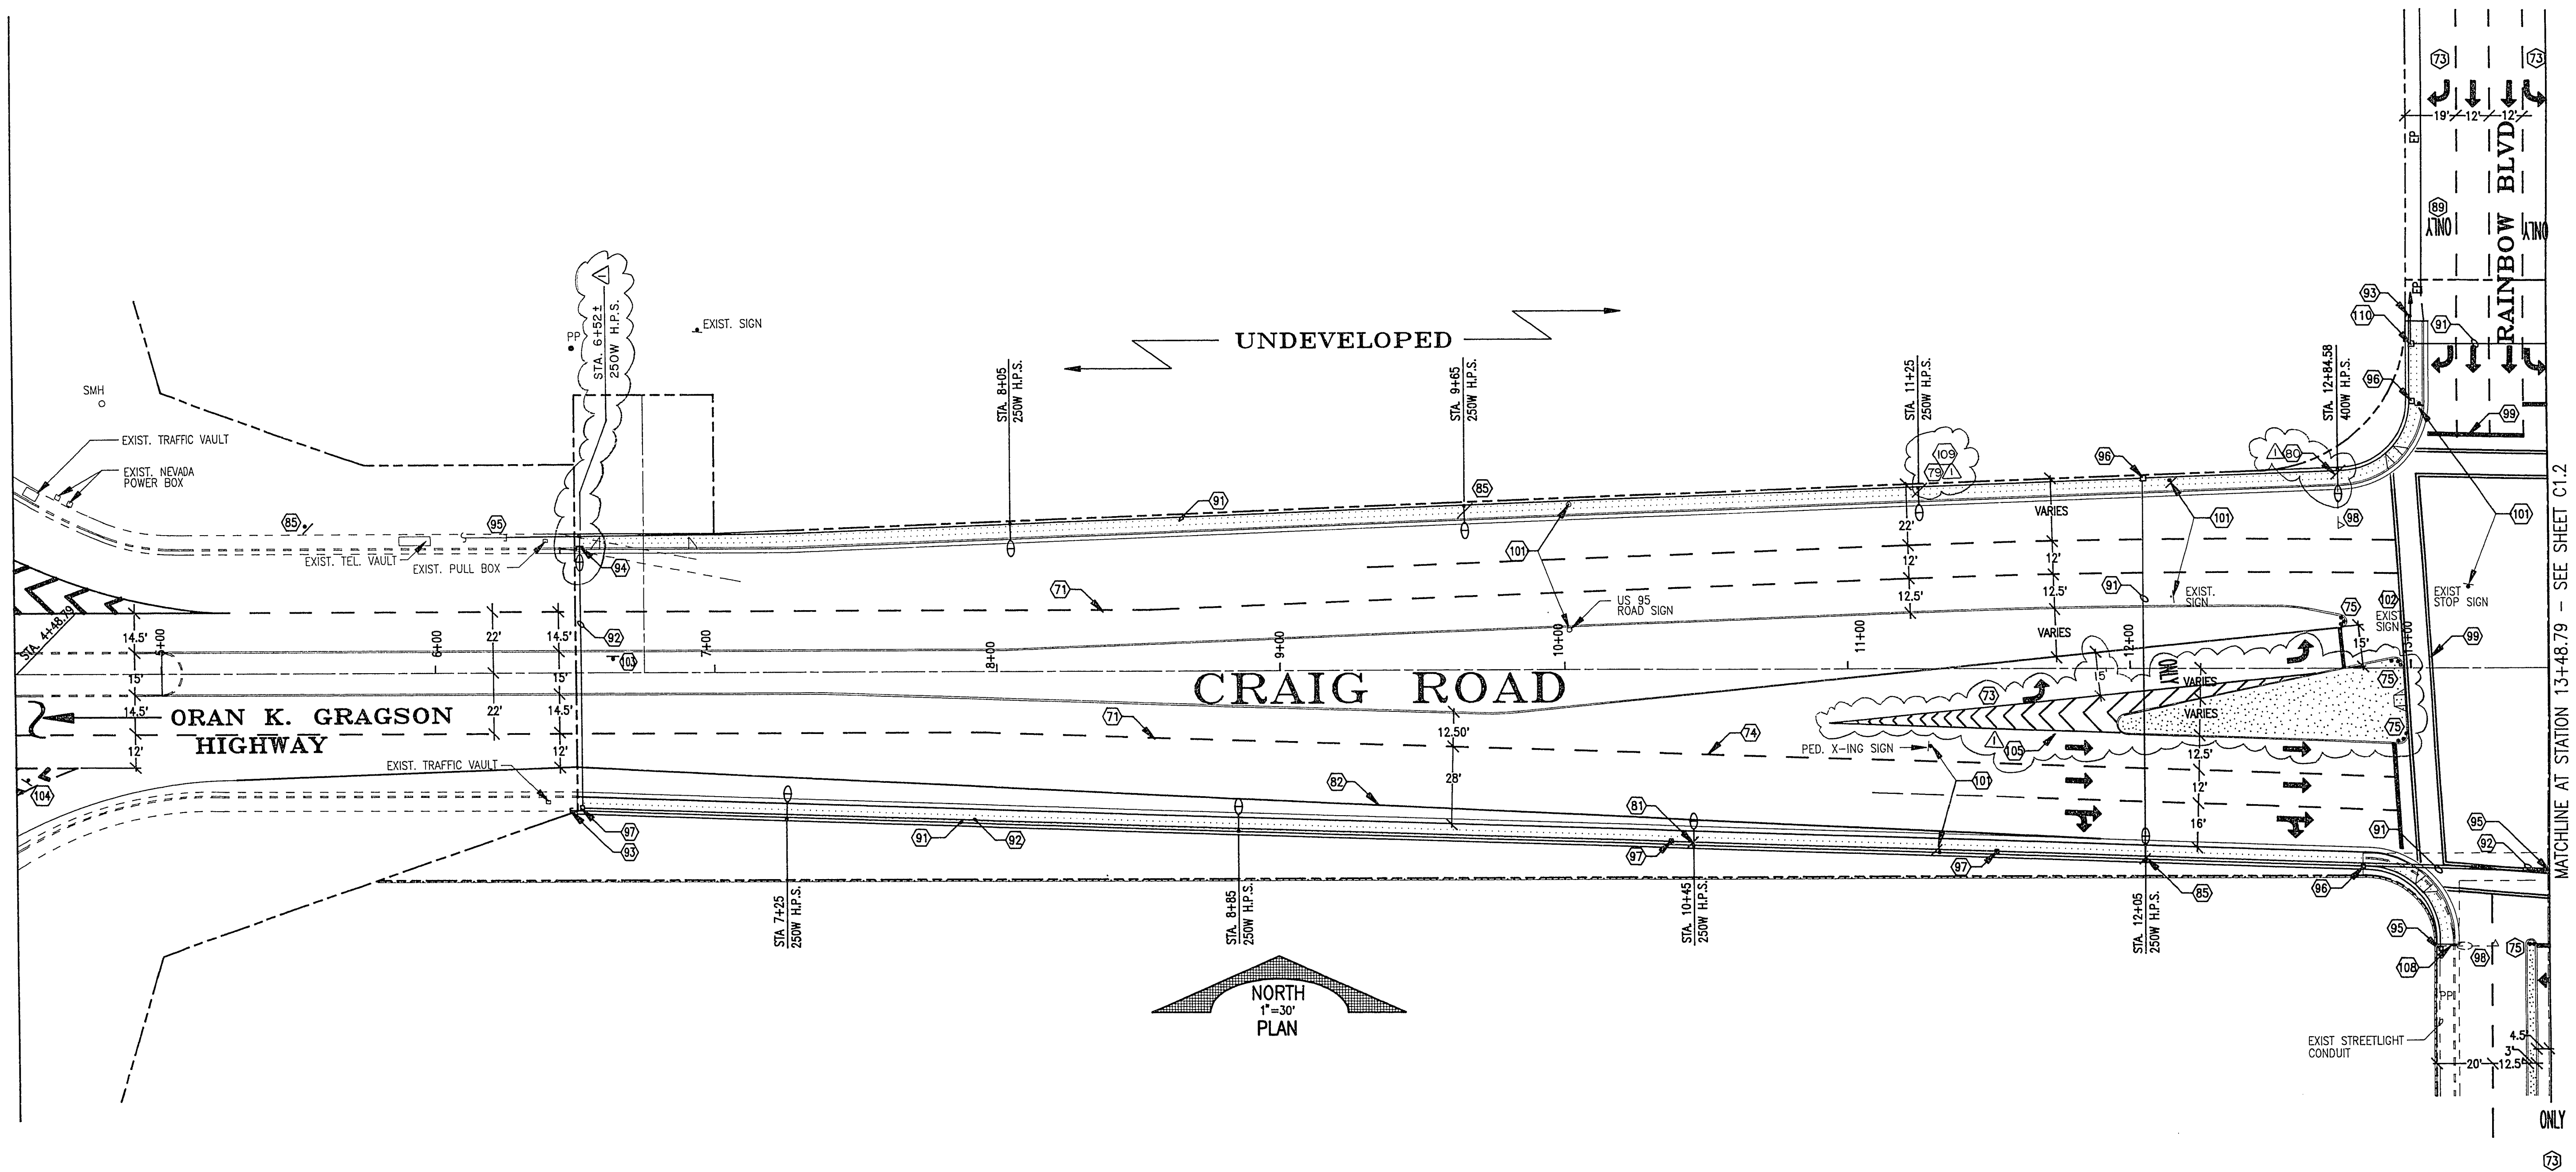

REVISION	DATE
1. PREPARED FOR THE STATE OF NEVADA	11/15/91

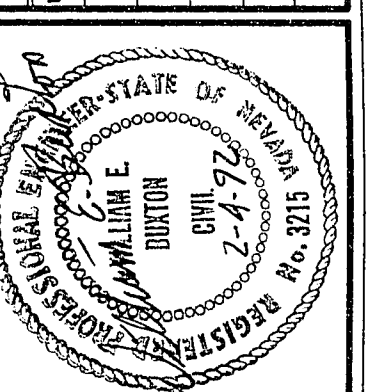

HEAVNER ENGINEERING
 CIVIL ENGINEERING - DESIGN
 LAND PLANNING & DEVELOPMENT
 4441 South Prairie Avenue, Las Vegas, Nevada 89103
 Phone: (702) 795-1900

CRAIG ROAD
TRAFFIC AND STREETLIGHT PLAN
STATION 4+48.79 TO STATION 13+48.79

SHEET NO.
C3.1
 107-V1804
 Y89042BY DATE 11/15/91

23-3-125