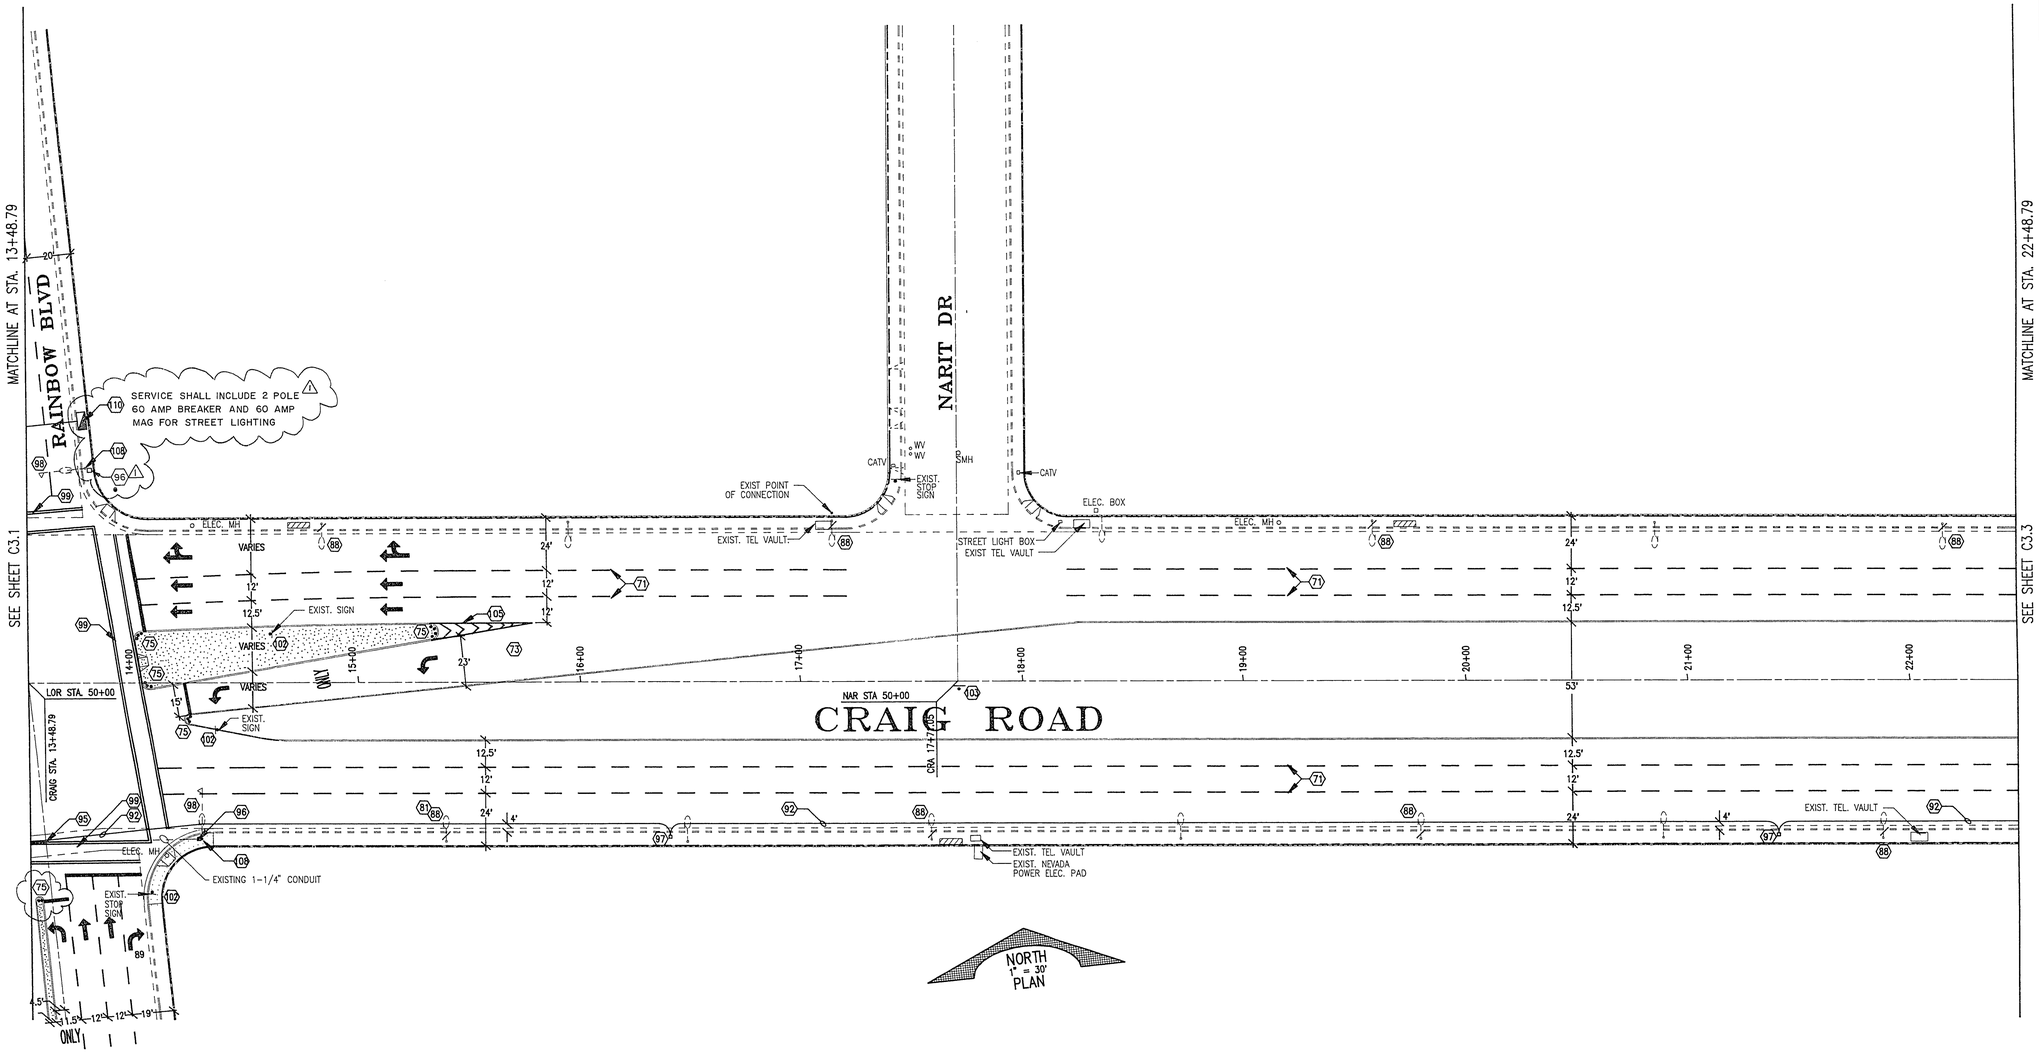

DATE	DIVISION
01-MAY-1996	NOTE & DESIGN

HEFNER ENGINEERING
CIVIL ENGINEERING • DESIGN
LAND PLANNING & DEVELOPMENT
4441 South Pecos Avenue, Las Vegas, Nevada 89103
Phone: (702) 798-1000

CRAIG ROAD
TRAFFIC AND STREETLIGHT PLAN
STATION 13+48.79 TO STATION 22+48.79

SHEET NO.
C3.2
107-V1804
BBBO42P8 DATE: 11/15/91
SHT. 25/66

73-3-126