
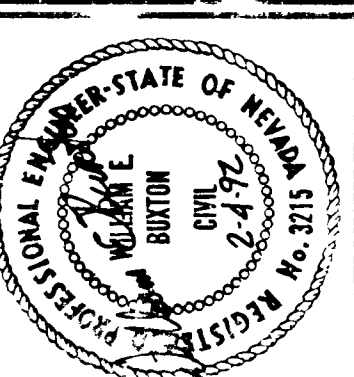
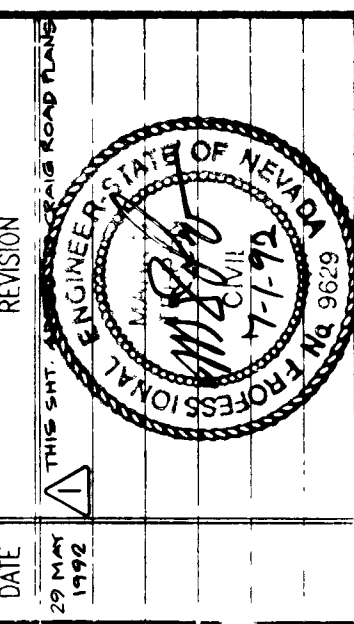


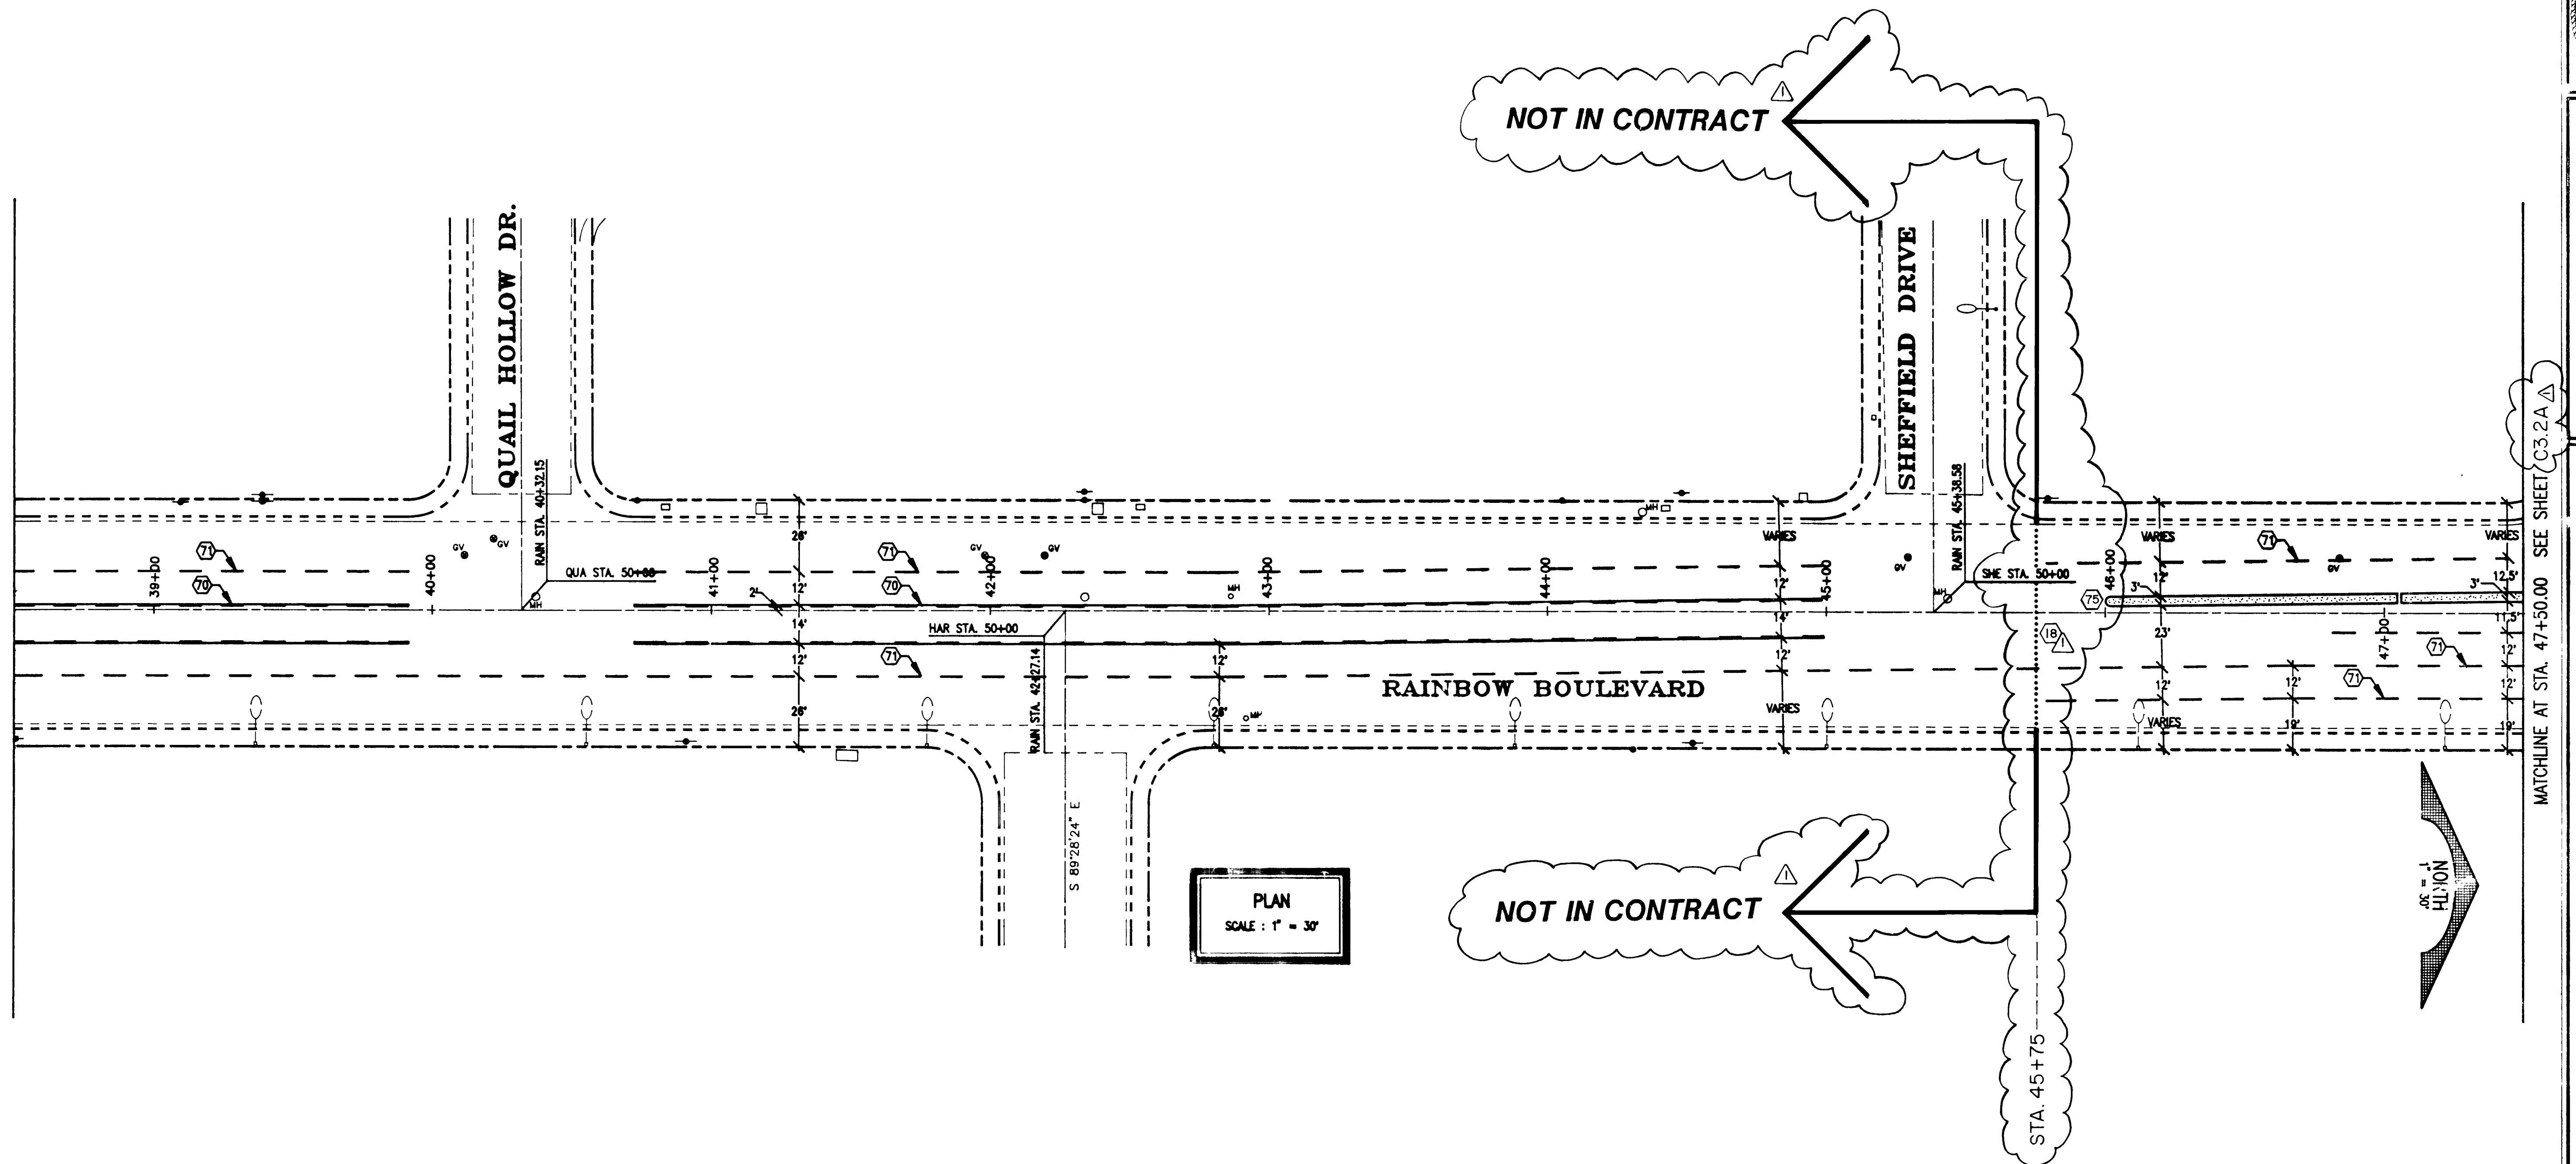



RAINBOW BOULEVARD
TRAFFIC AND STREETLIGHT PLAN
STATION 38+50.00 TO STATION 47+50.00

SHEET NO.

C3.2B
107-V1804
SHT. 27/66

1236

23-3-128

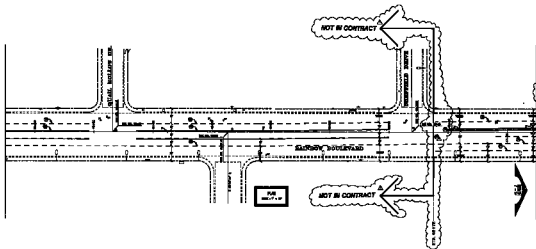









