



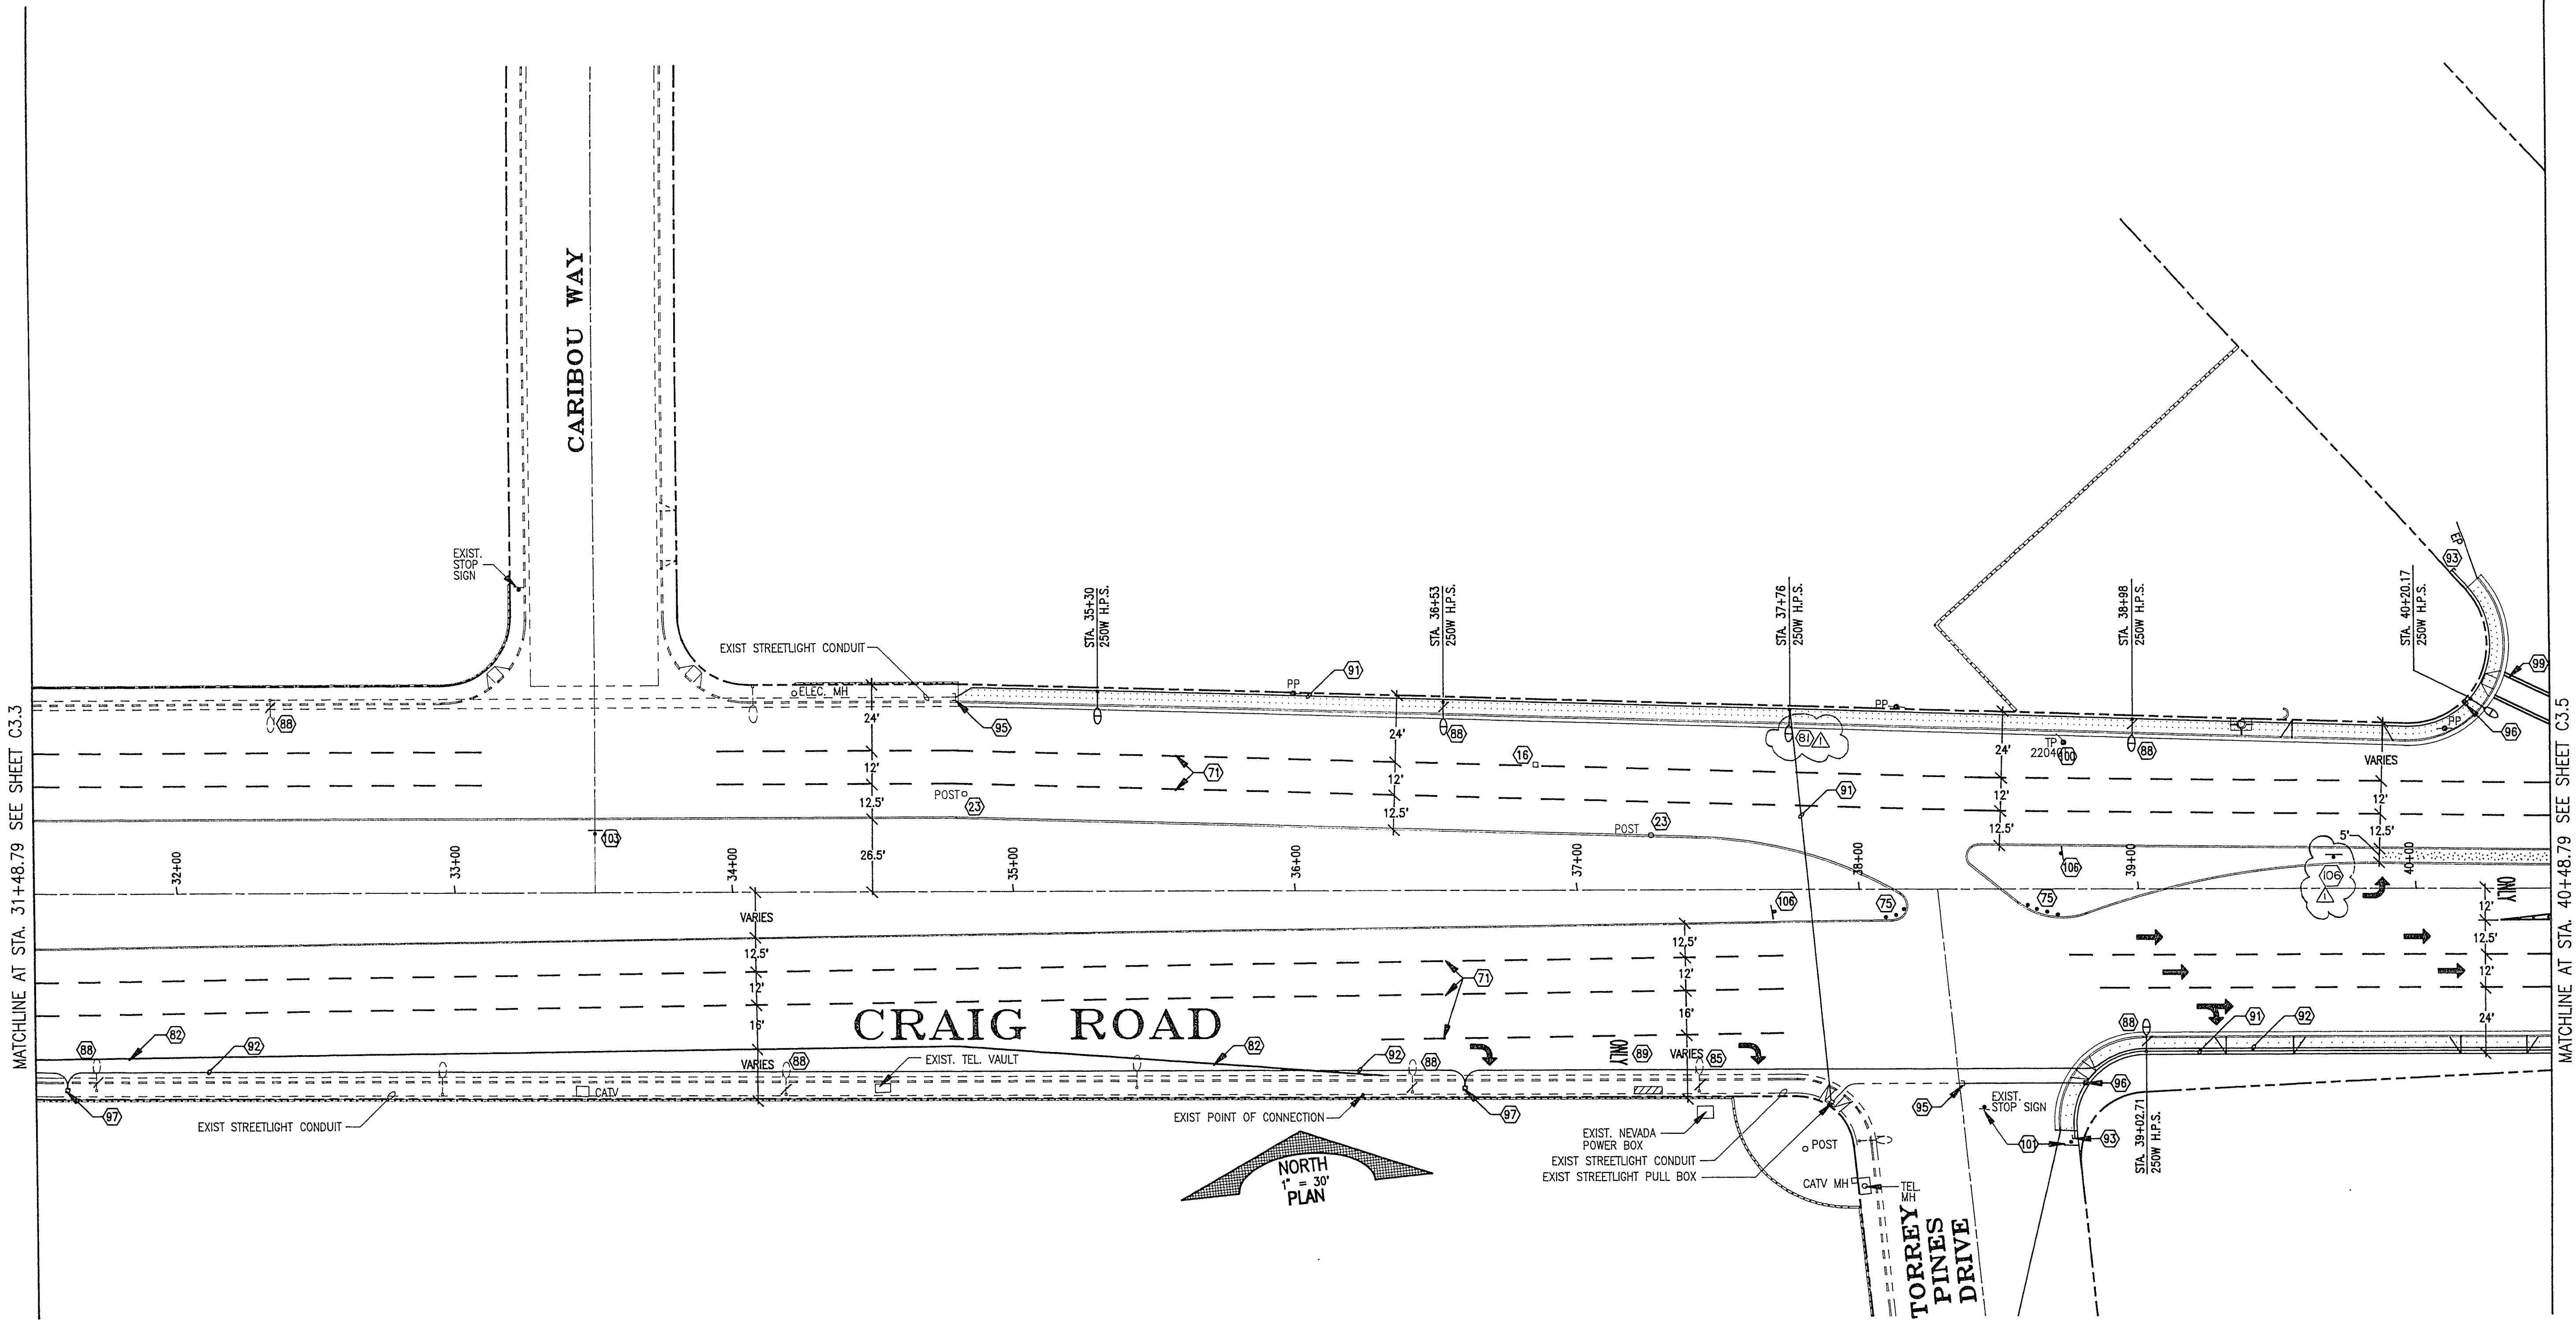

DATE	REVISION
APRIL 1992	FIELD NOTES CORRECTIONS - RIGHT SIDE

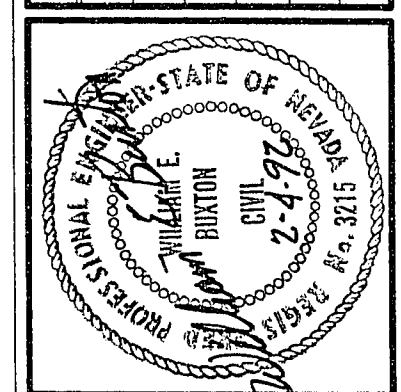

HEFFNER ENGINEERING
 CIVIL ENGINEERING • DESIGN
 LAND PLANNING & DEVELOPMENT
 4441 South Polaris Avenue, Las Vegas, Nevada 89103
 Phone: (702) 798-1900

CRAIG ROAD
TRAFFIC AND STREETLIGHT PLAN
STATION 31+48.79 TO STATION 40+48.79

SHEET NO.
C3.4

107-V1804
 038042201 DATE: 11/11/91
 SHT. 29/66

23-3-130