



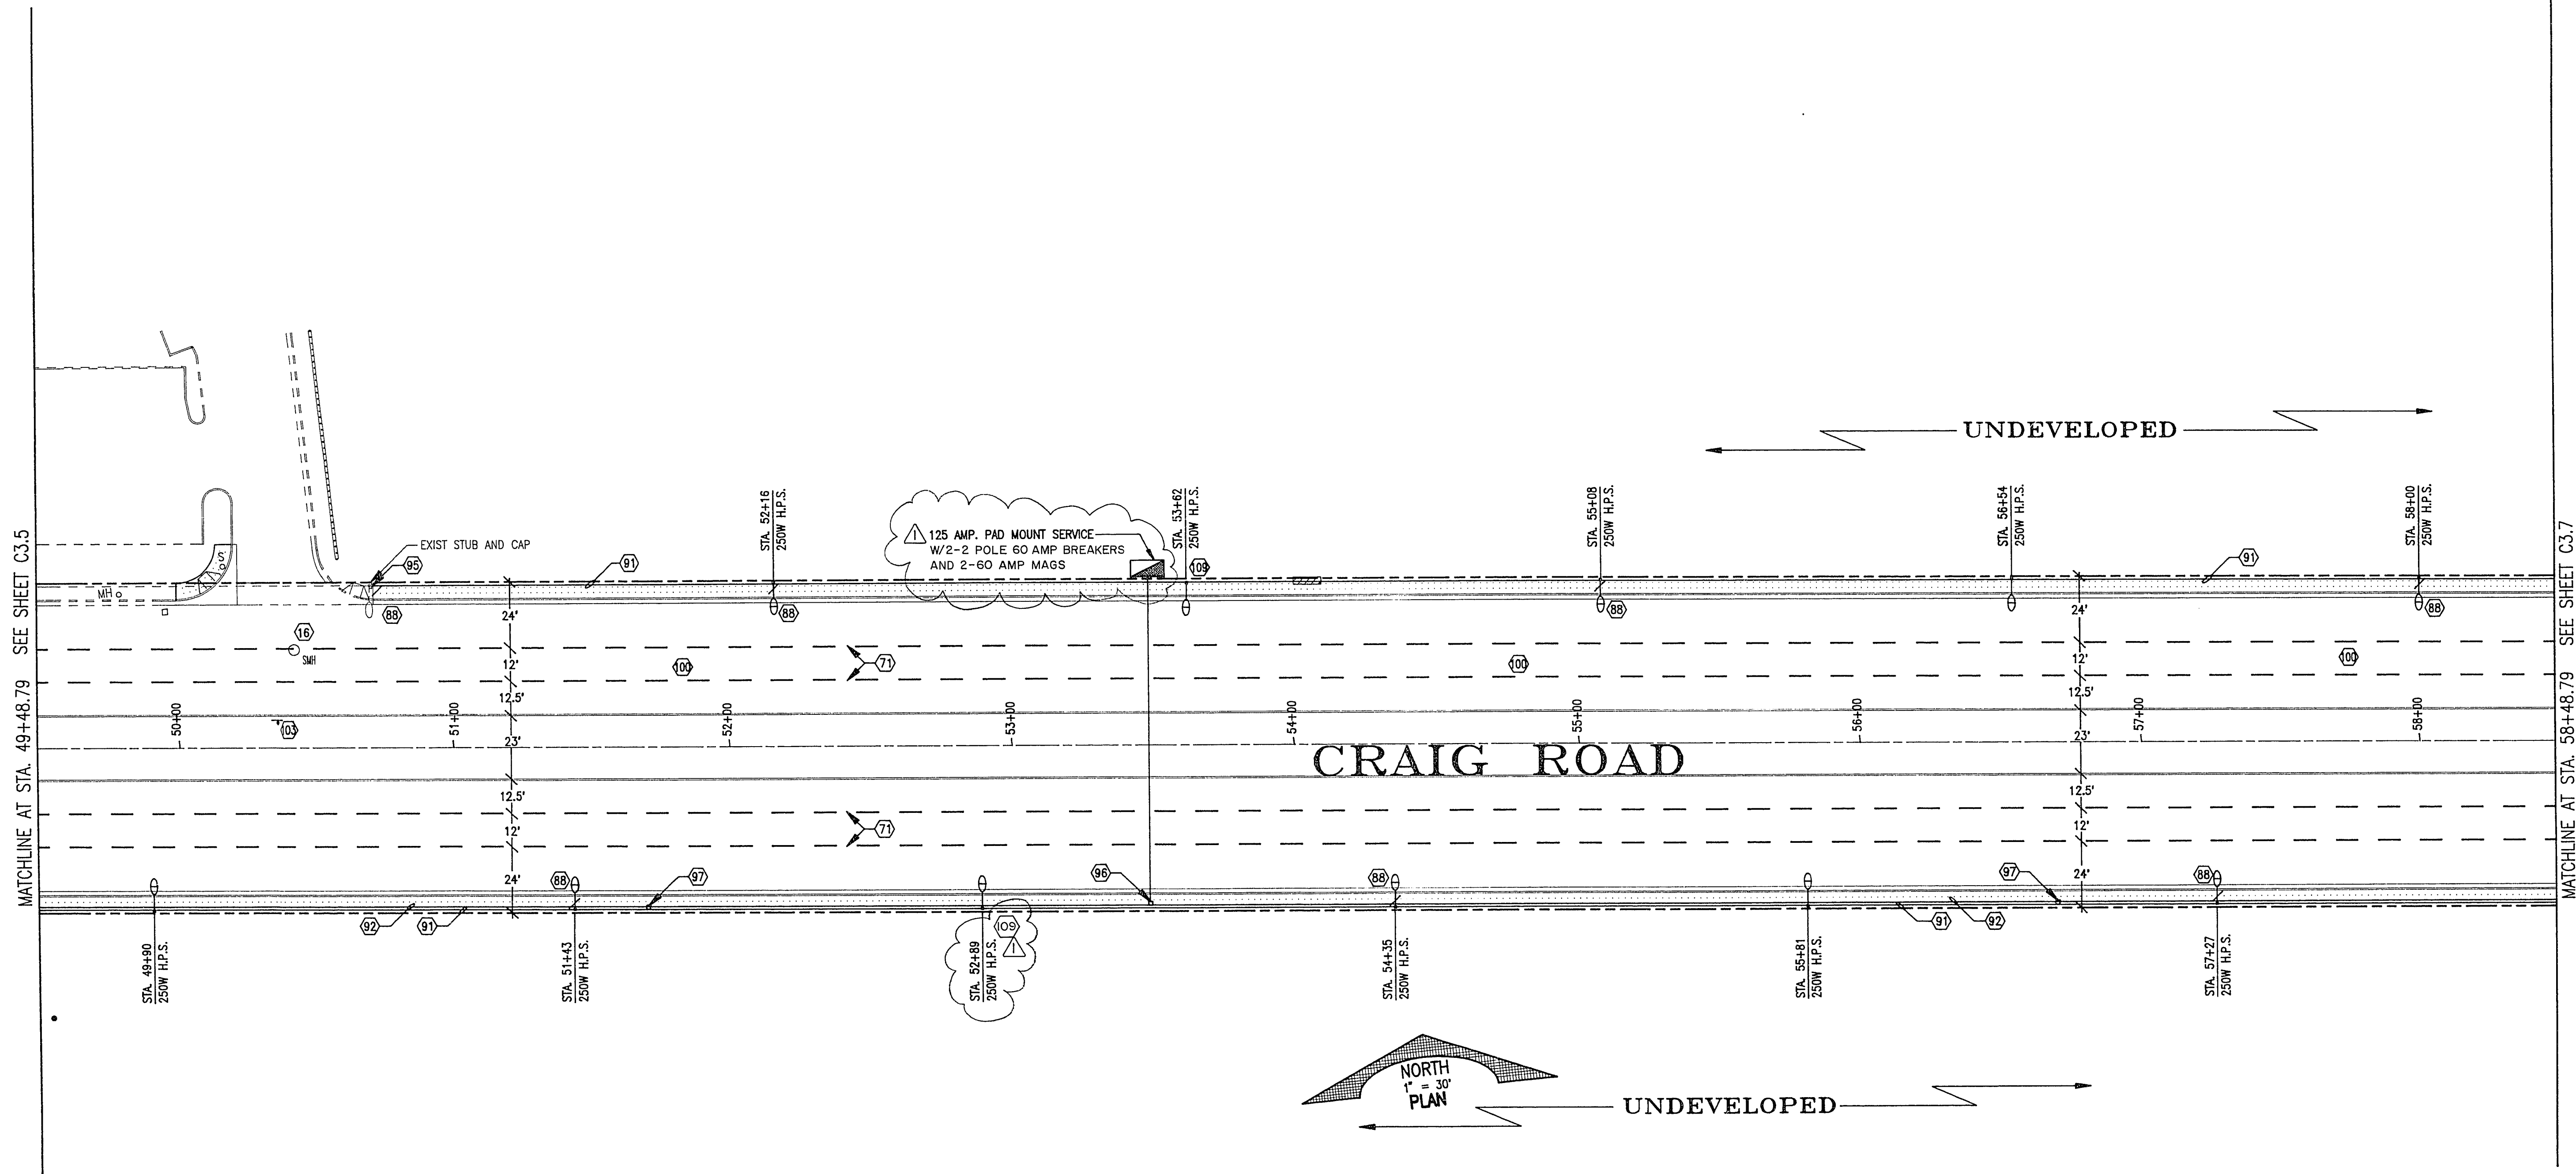

DATE	REVISION

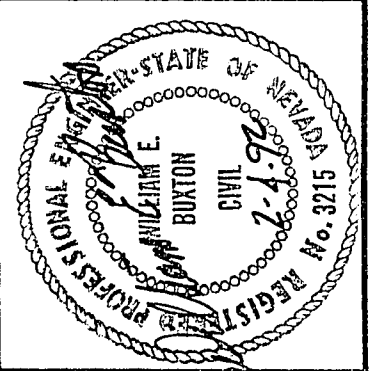

HEFFNER ENGINEERING

CIVIL ENGINEERING • DESIGN
LAND PLANNING & DEVELOPMENT

4441 South Polaris Avenue, Las Vegas, Nevada 89103
Phone: (702) 798-1900

CRAIG ROAD

TRAFFIC AND STREETLIGHT PLAN

STATION 49+48.79 TO STATION 58+48.79

SHEET NO.

C3.6

107-VI804
189042P DATE 11/17/91
SHT. 31/66

23 3.132