


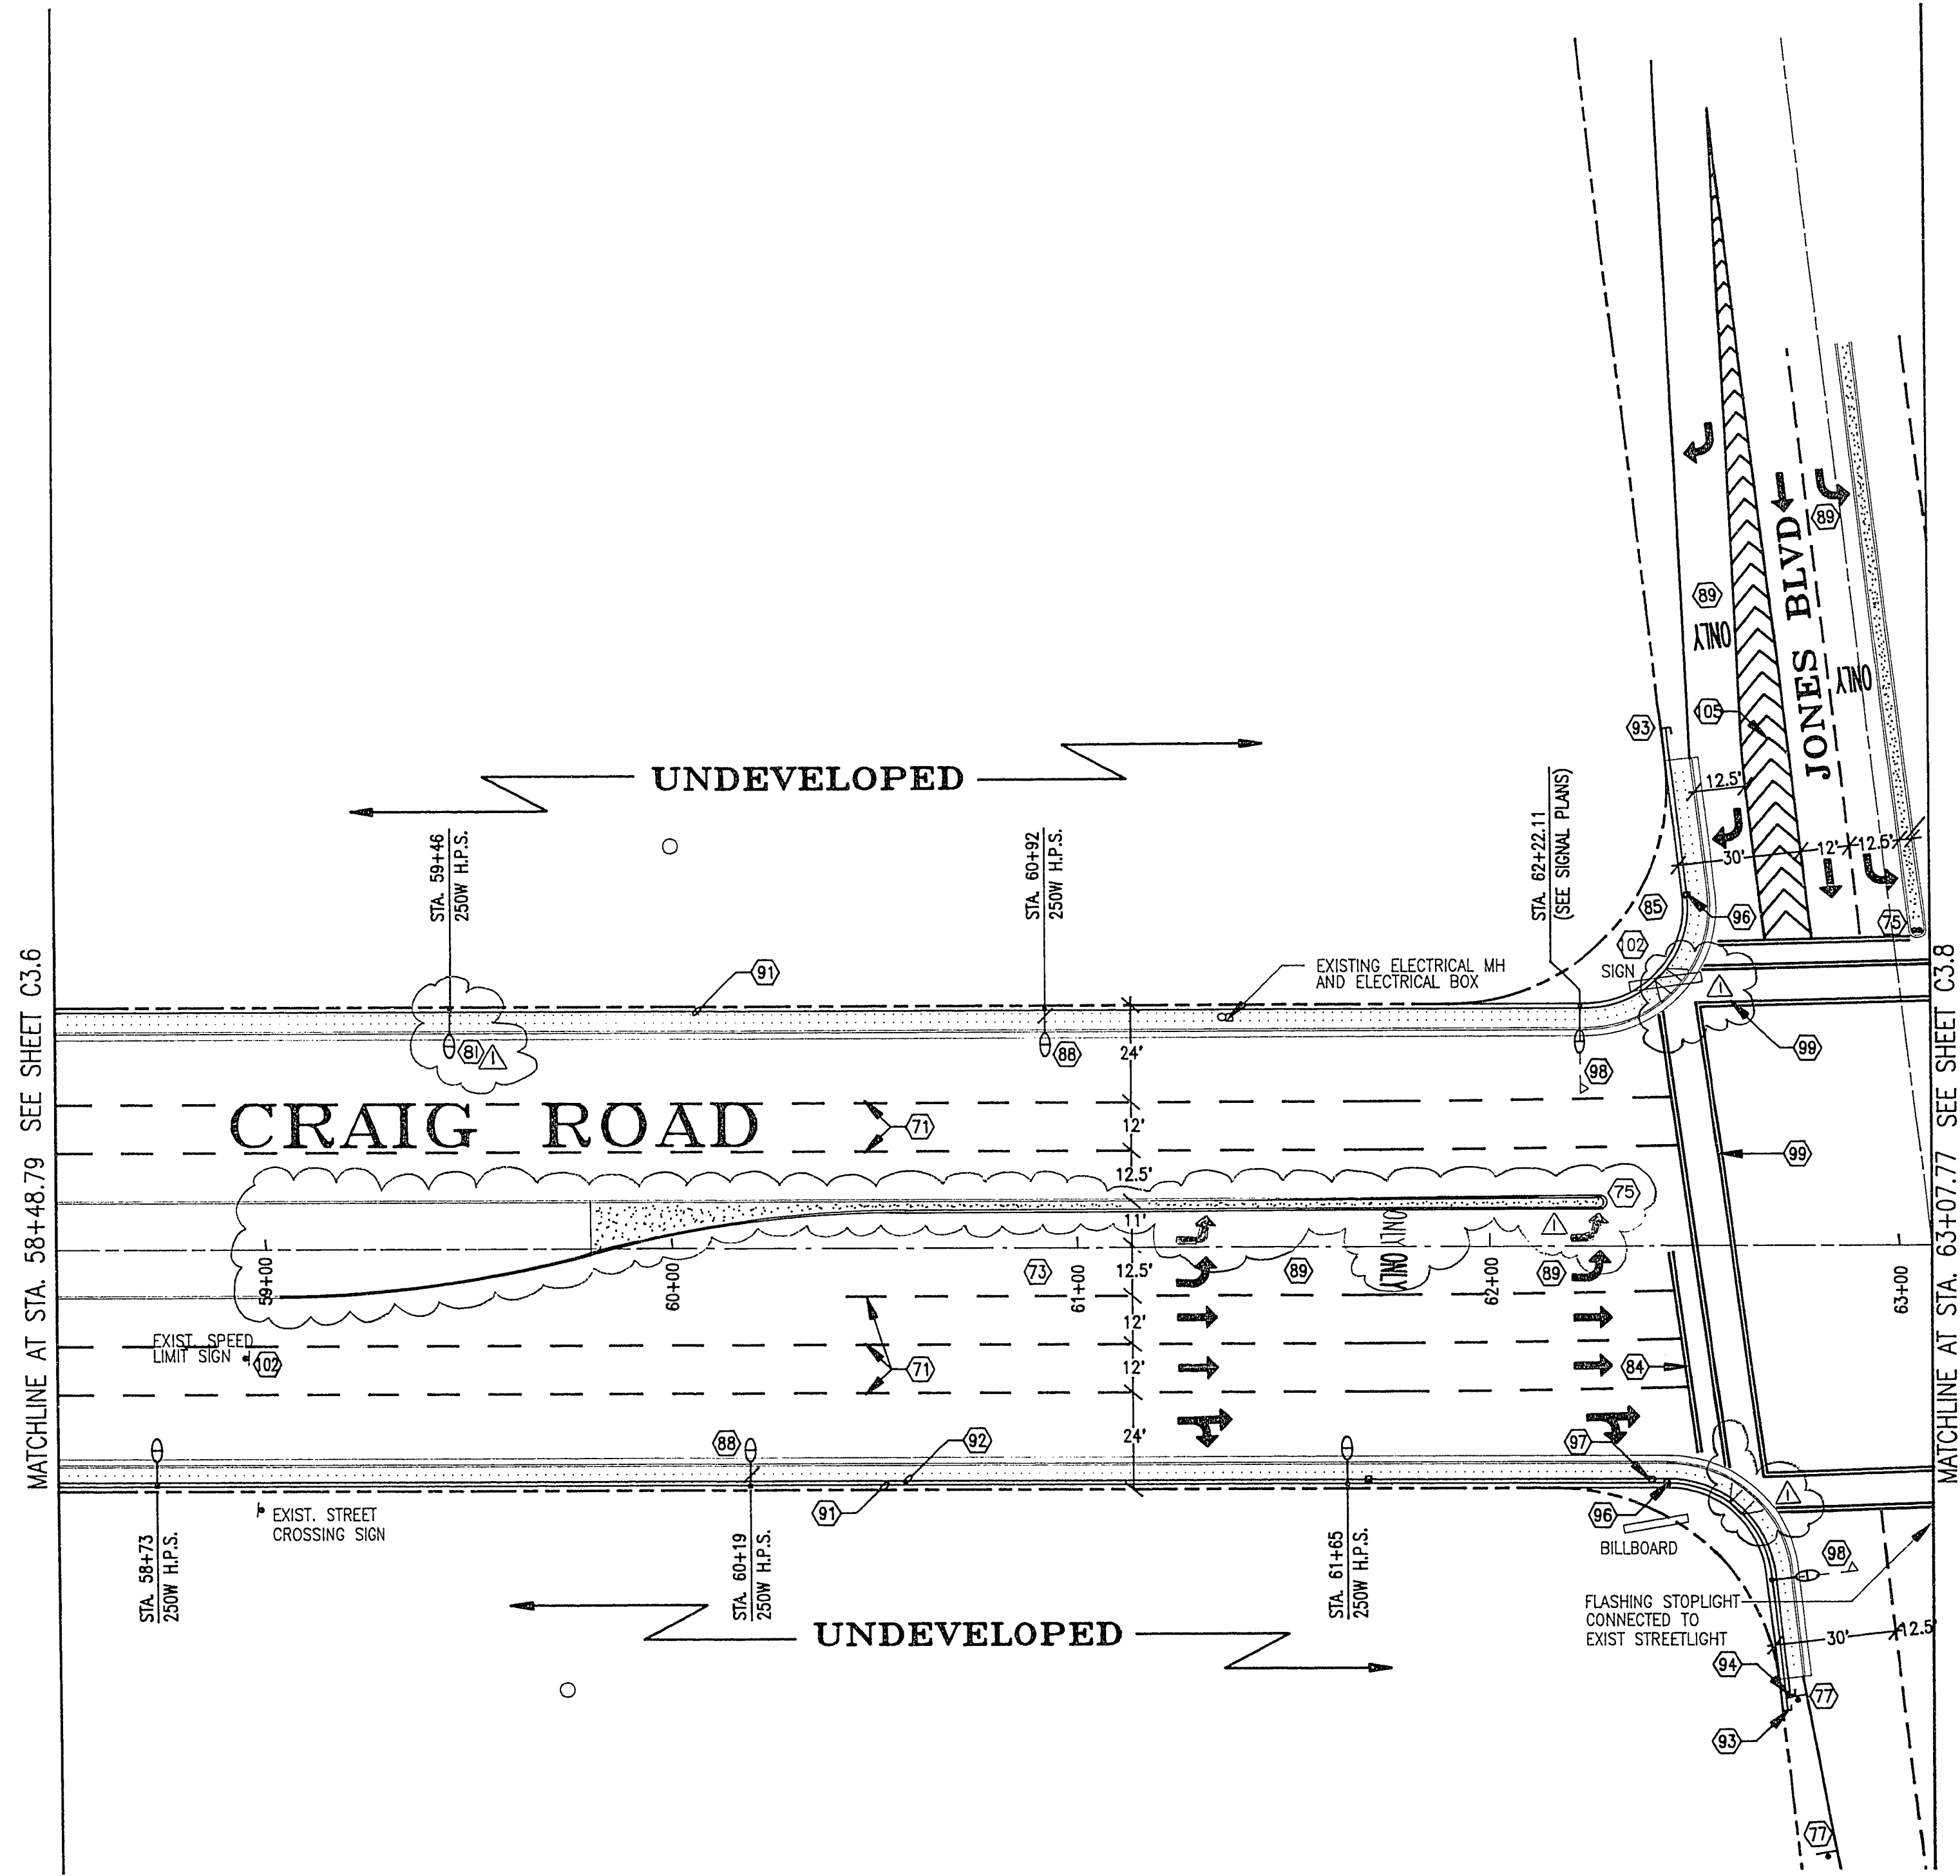

DATE 7/1/92	REVISION 1. REVISION 1 7/1/92			HEFNER ENGINEERING CIVIL ENGINEERING • DESIGN LAND PLANNING & DEVELOPMENT 4441 South Pointe Avenue, Las Vegas, Nevada 89103 Phone: (702) 798-1800	SHEET NO. C3.7 107-V1804 68804/2/92 DATE: 10/08/91
CRAIG ROAD TRAFFIC AND STREETLIGHT PLAN STATION 58+48.79 TO STATION 63+07.77					

23 3-133