


MATCHLINE AT STATION 81+07.77 SEE SHEET C3.9

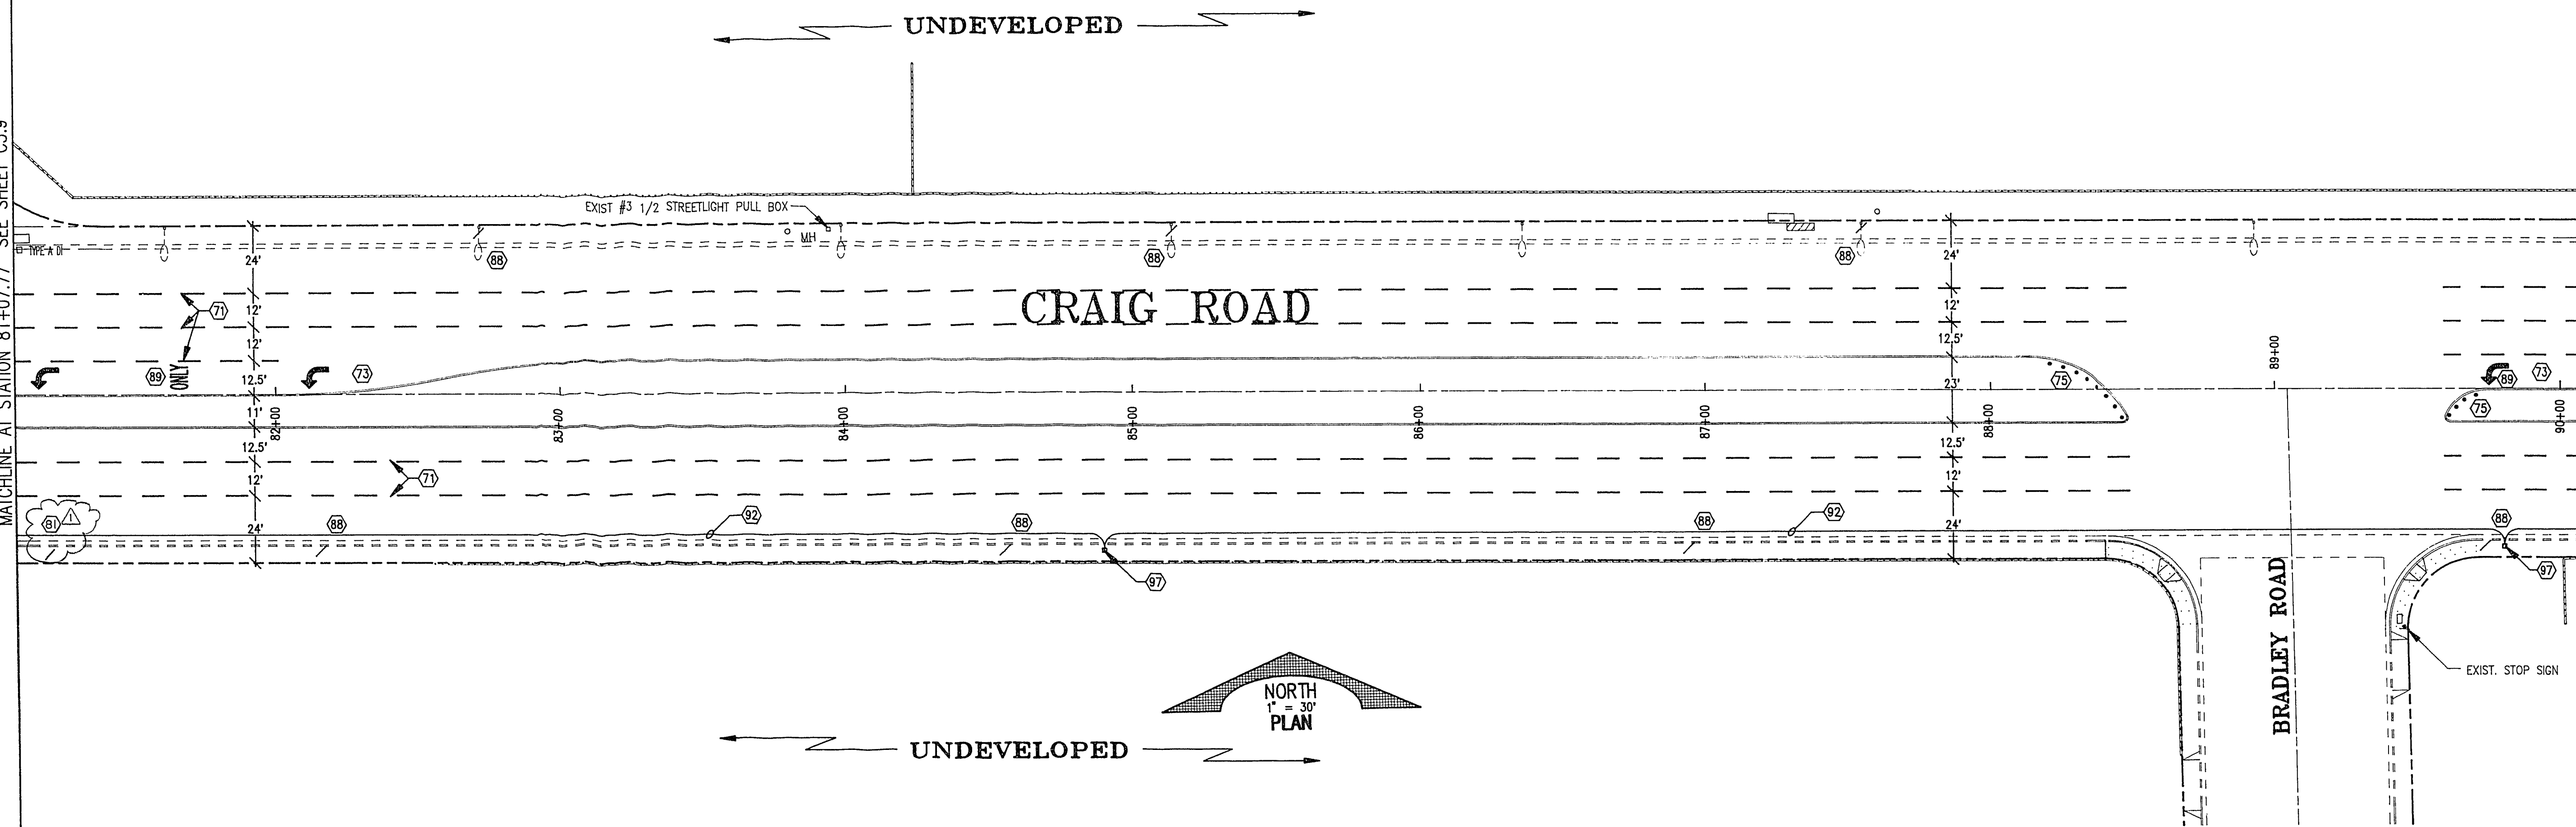

MATCHLINE AT STATION 90+07.77 SEE SHEET C3.11


CRAIG ROAD
TRAFFIC AND STREETLIGHT PLAN
STATION 81+07.77 TO STATION 90+07.77

SHEET NO.

C3.10

107-V1804
38904923 DATE: 11/11/21
SHT. 35/66

HEENER
ENGINEERING
CIVIL ENGINEERING • DESIGN
LAND PLANNING & DEVELOPMENT
4441 South Polaris Avenue
Phone: (702) 788-1800

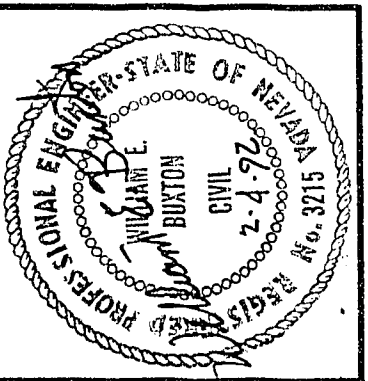

DATE	REVISION
10/22	1. MOVE SPEED LIMIT SIGN

23-3-136