


MATCHLINE AT STA. 99+07.77 SEE SHEET C3.11

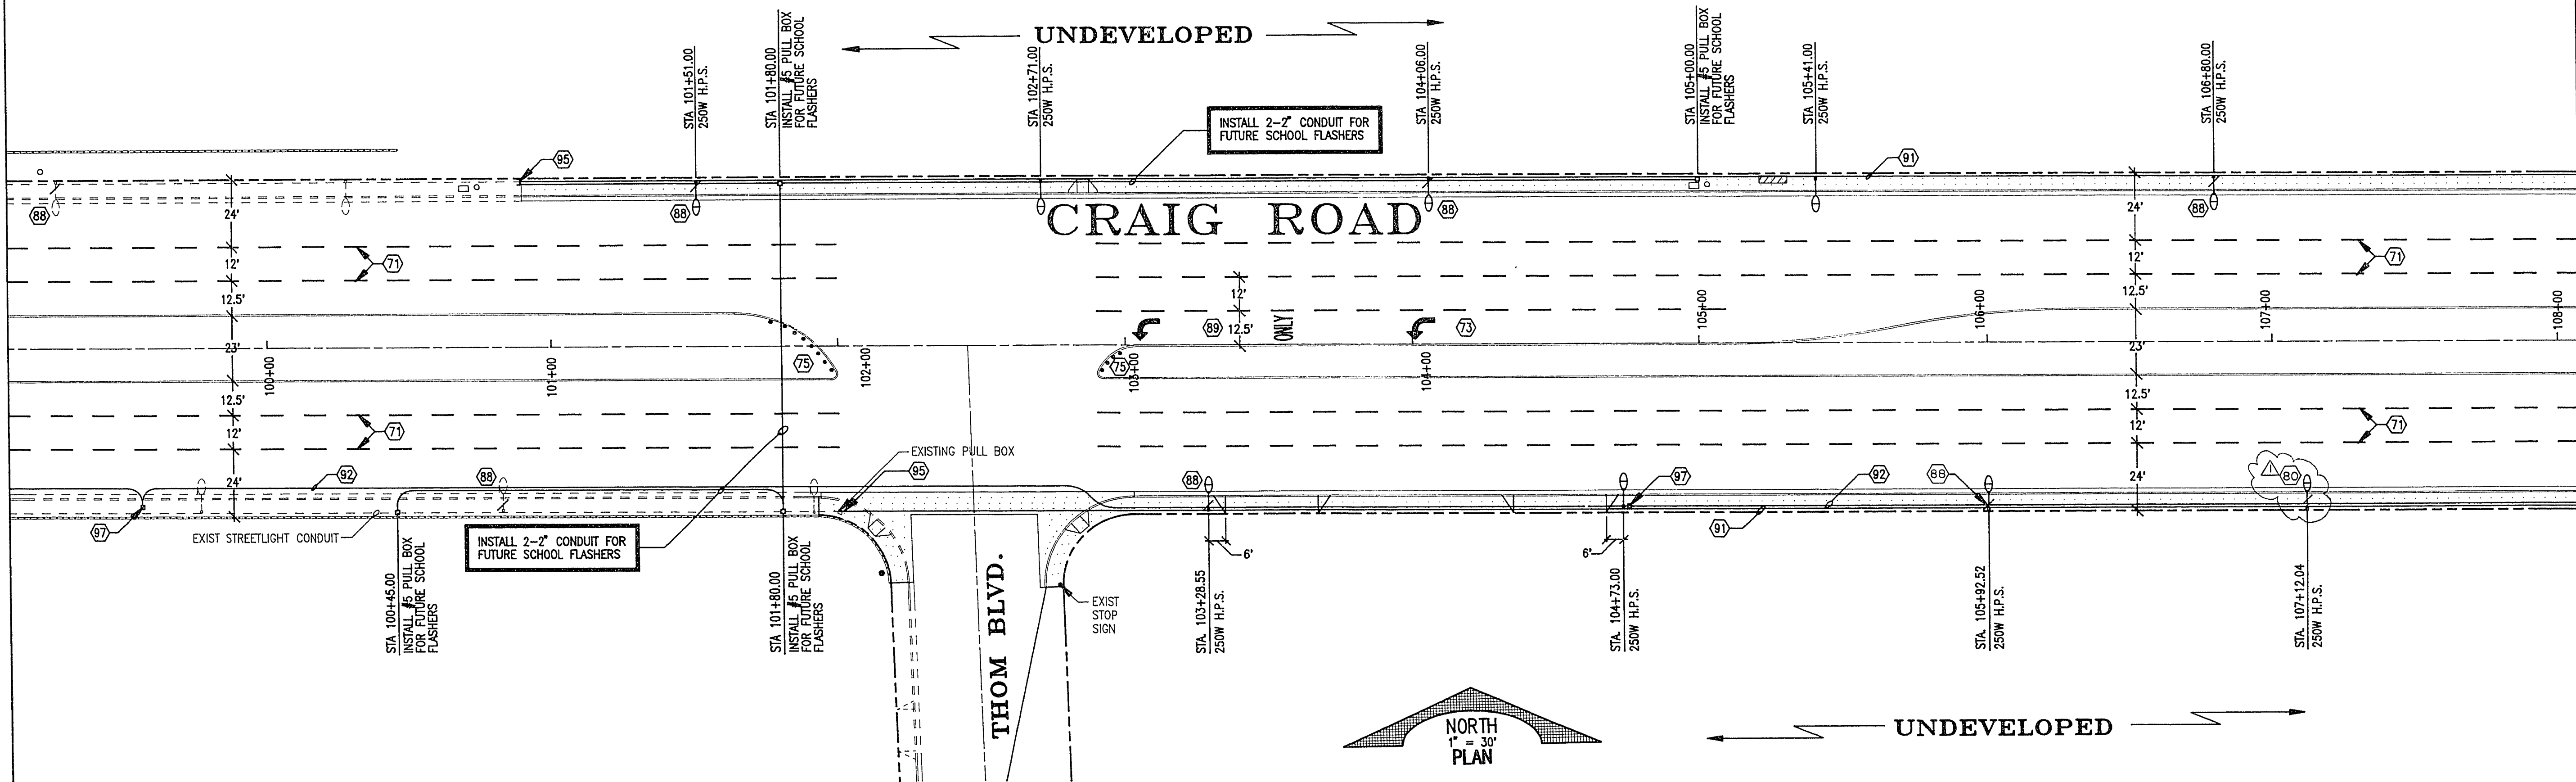

MATCHLINE AT STA. 108+07.77 SEE SHEET C3.13

CRAIG ROAD
TRAFFIC AND STREETLIGHT PLAN
STATION 99+07.77 TO STATION 108+07.77


SHEET NO.

C3.12

107-V1804
1890122P DATE: 11/25/91

SHT. 37/66

HEFFNER
ENGINEERING
CIVIL ENGINEERING • DESIGN
LAND PLANNING & DEVELOPMENT
4441 South Polaris Avenue, Las Vegas, Nevada 89103
Phone: (702) 798-1900

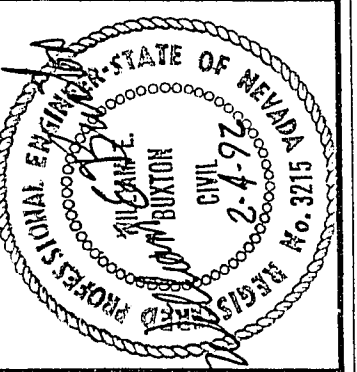

DATE	REVISION
	1. MOVE SIGN TO CENTERLINE POLE

03-3-38