


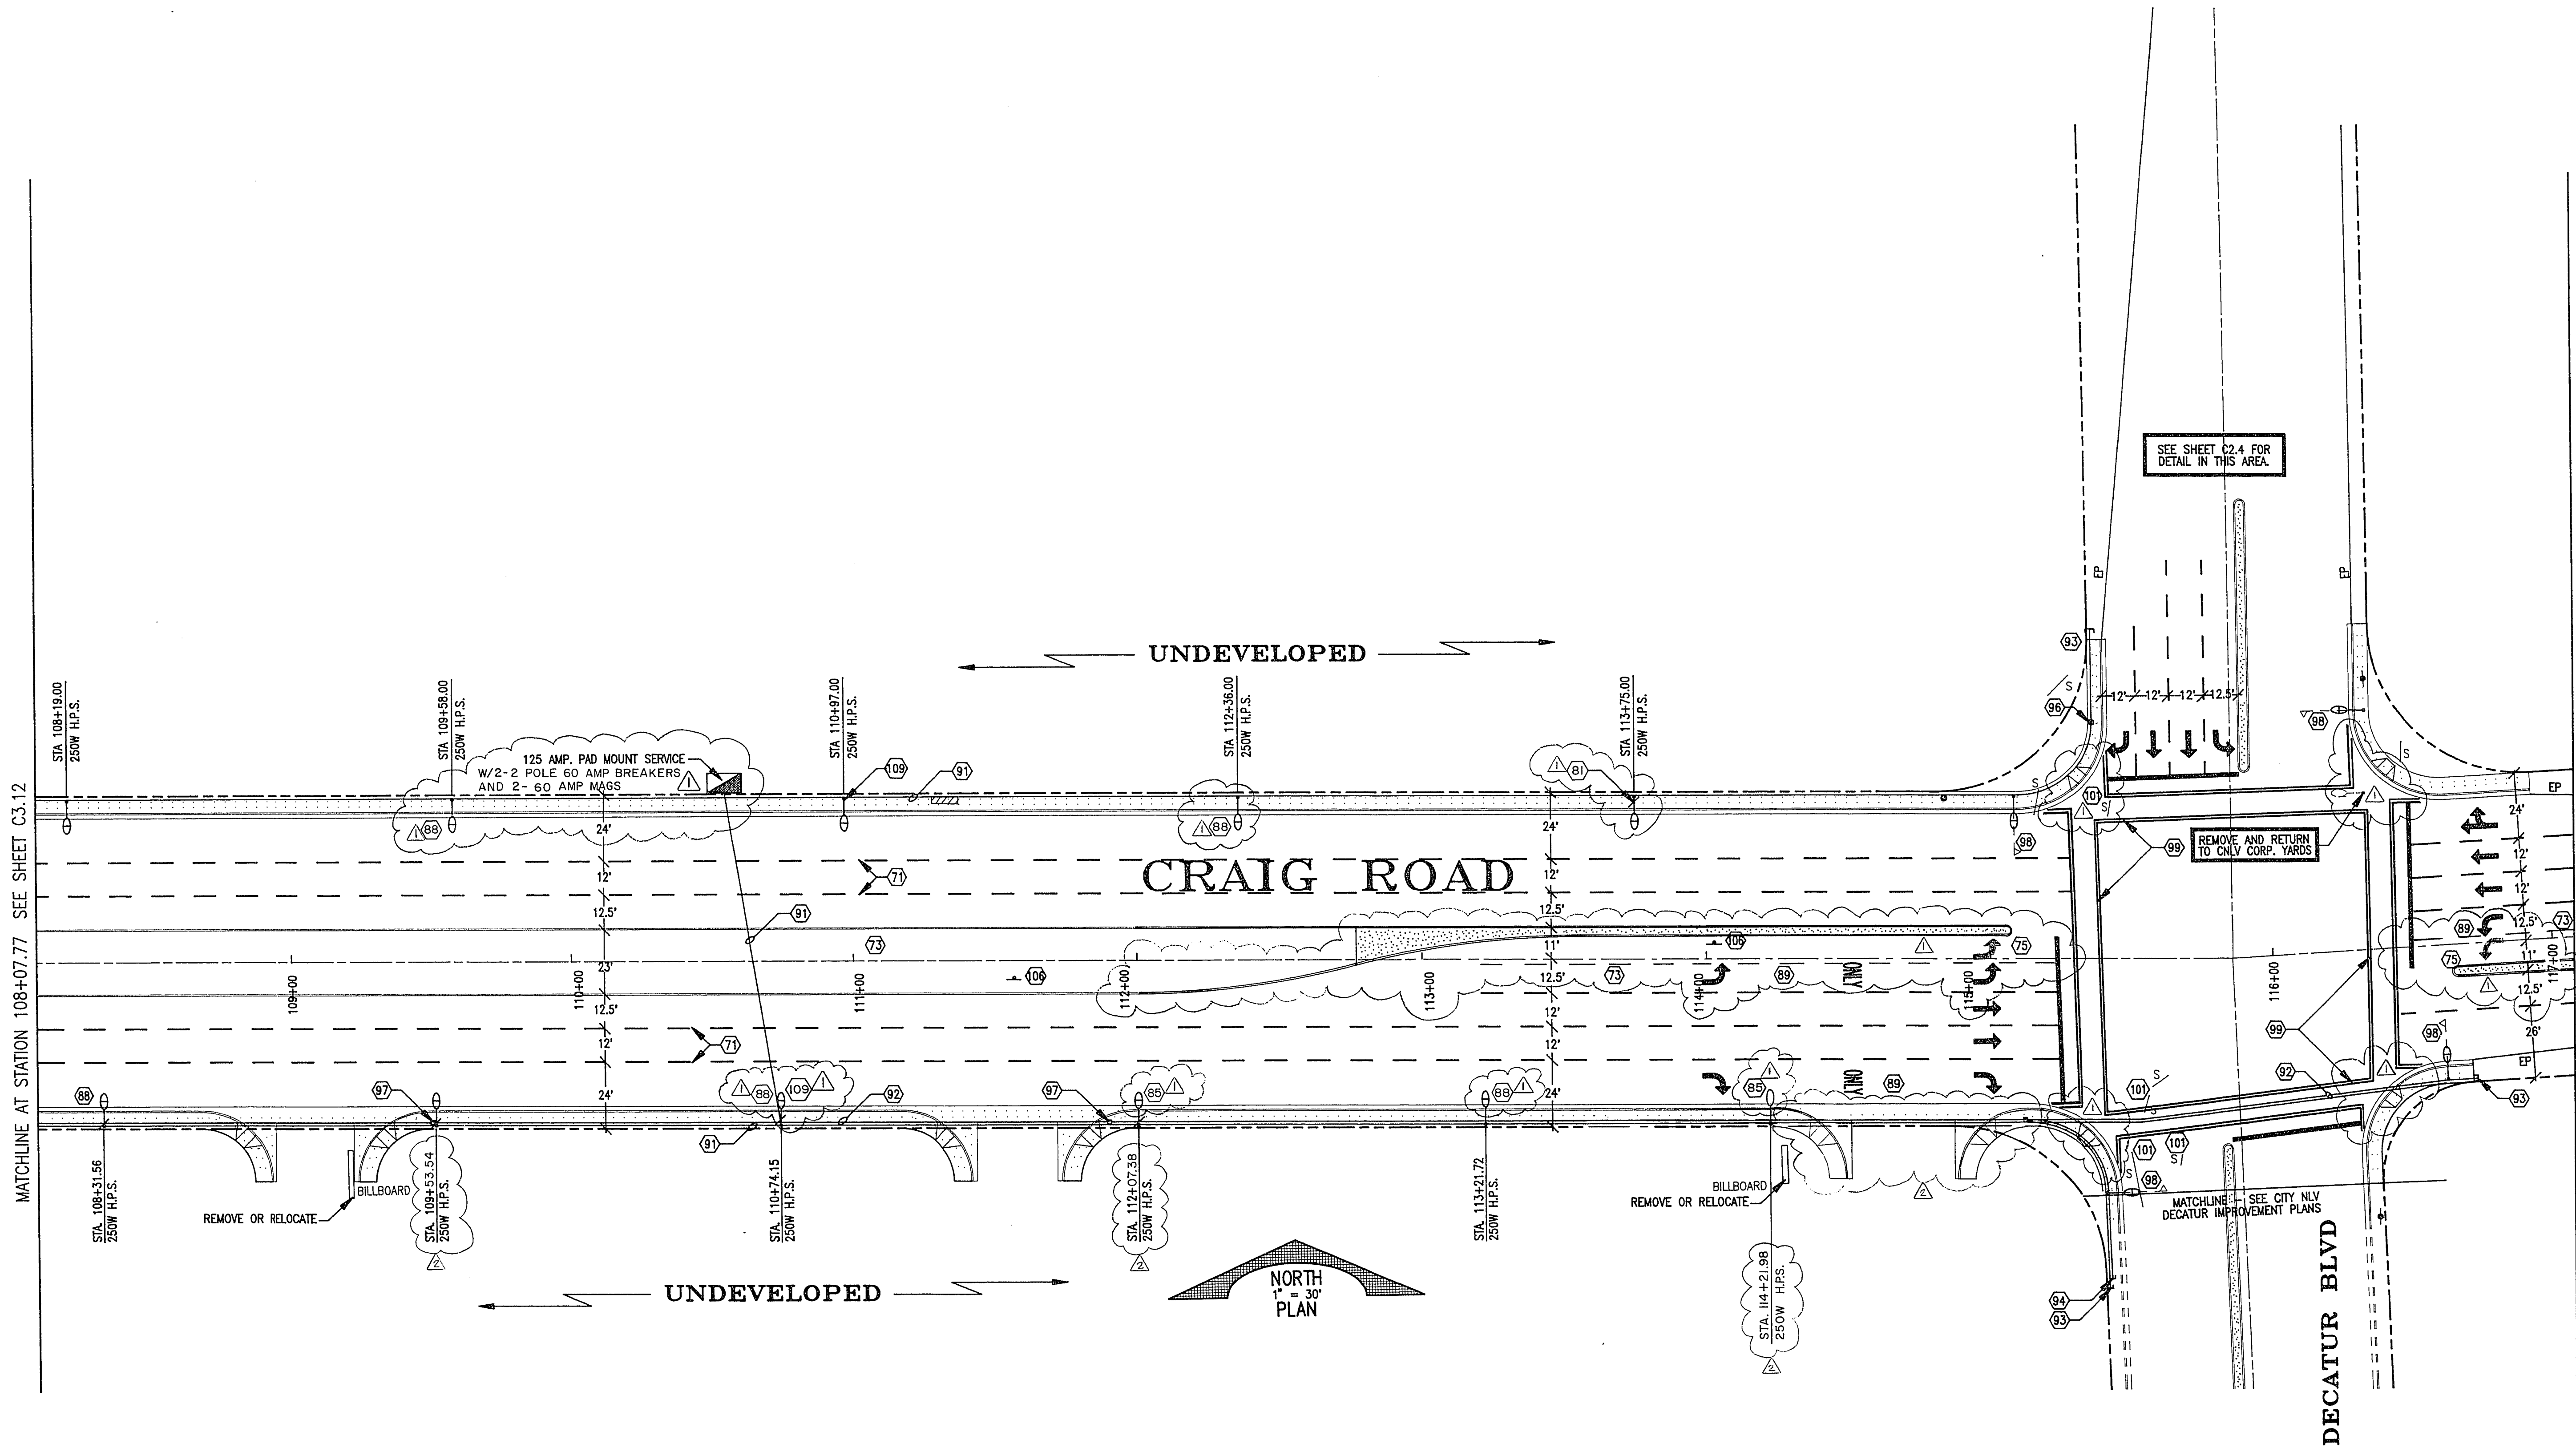

DATE	REVISION
11/25/91	
HEFFNER ENGINEERING CIVIL ENGINEERS • DESIGN LAND PLANNING • DEVELOPMENT 4441 South Polaris Avenue, Las Vegas, Nevada 89103 Phone: (702) 798-1800	
CRAIG ROAD TRAFFIC AND STREETLIGHT PLAN STATION 108+07.77 TO STATION 117+07.77	
SHEET NO. C3.13 107-VI804 1089/1224 DATE 11/25/91	

33-3-139