
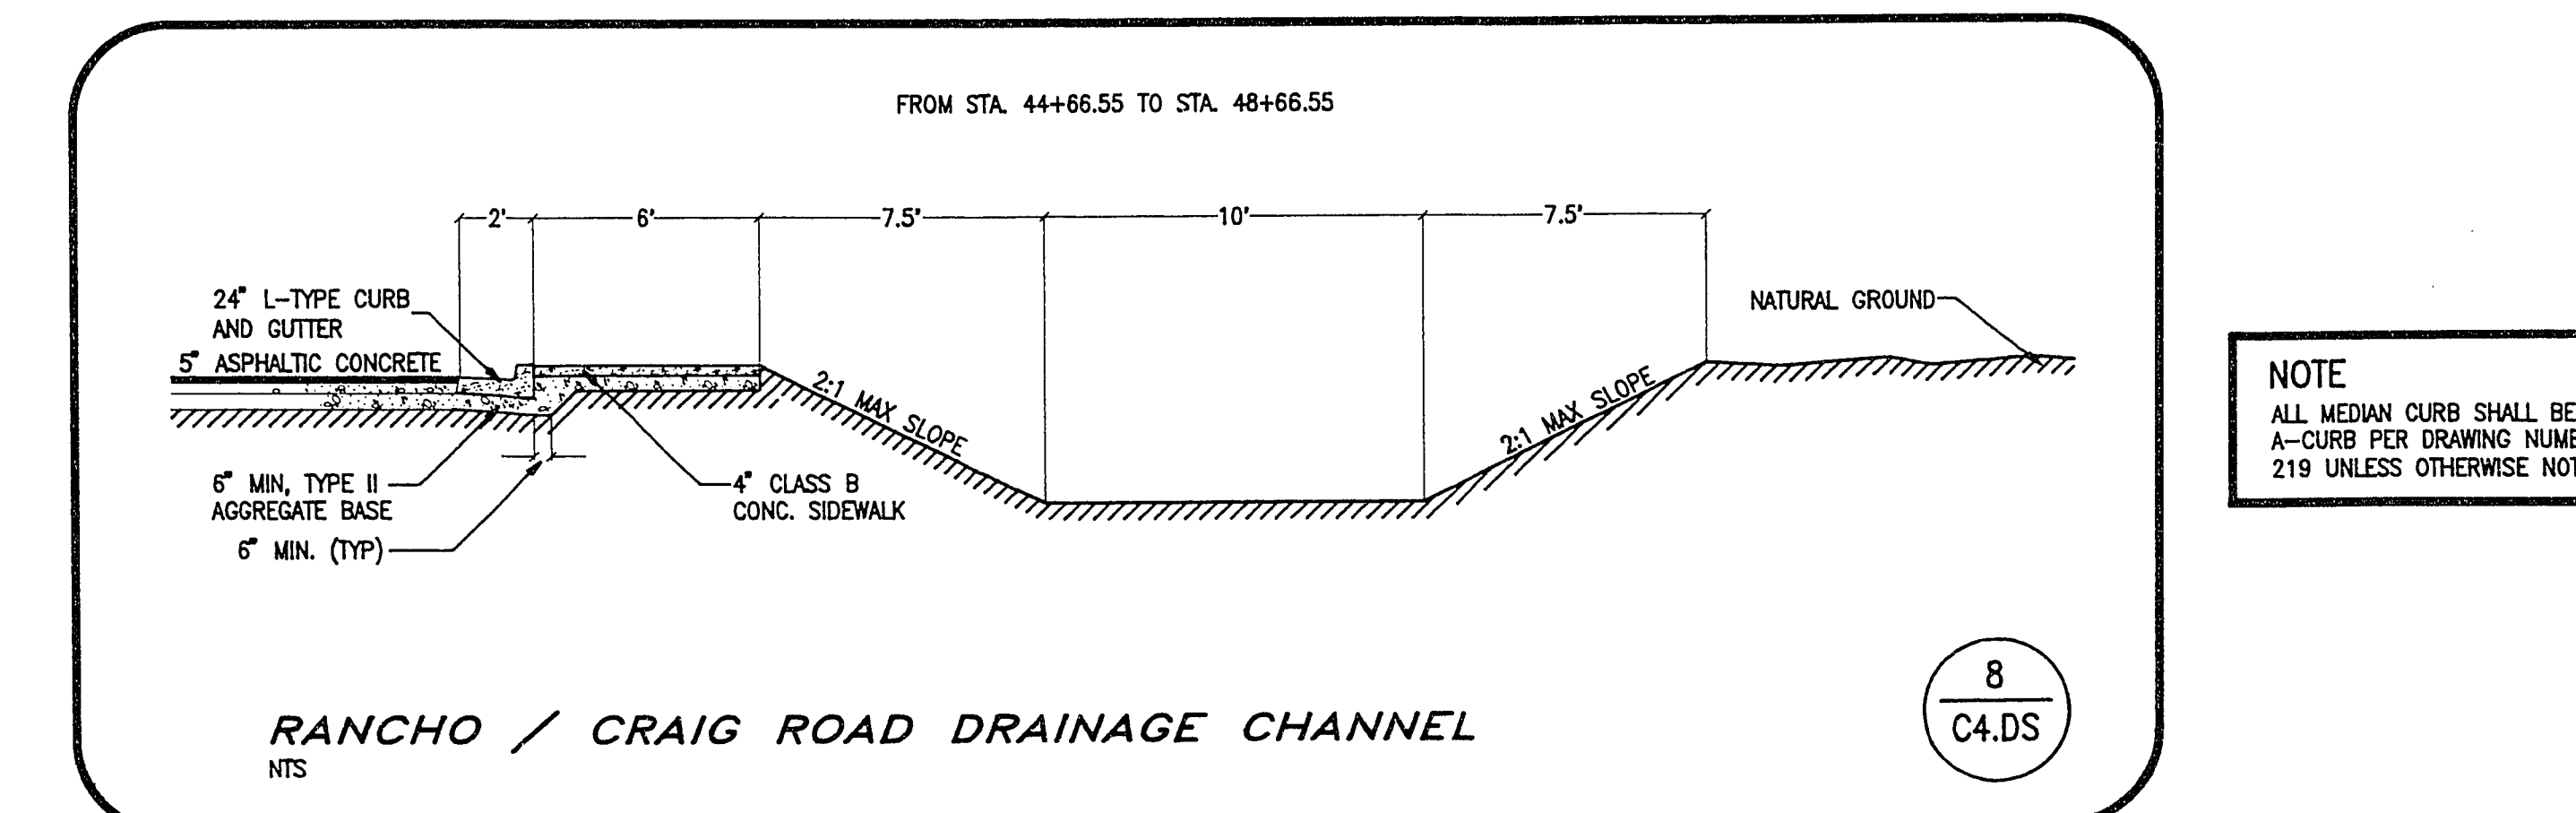
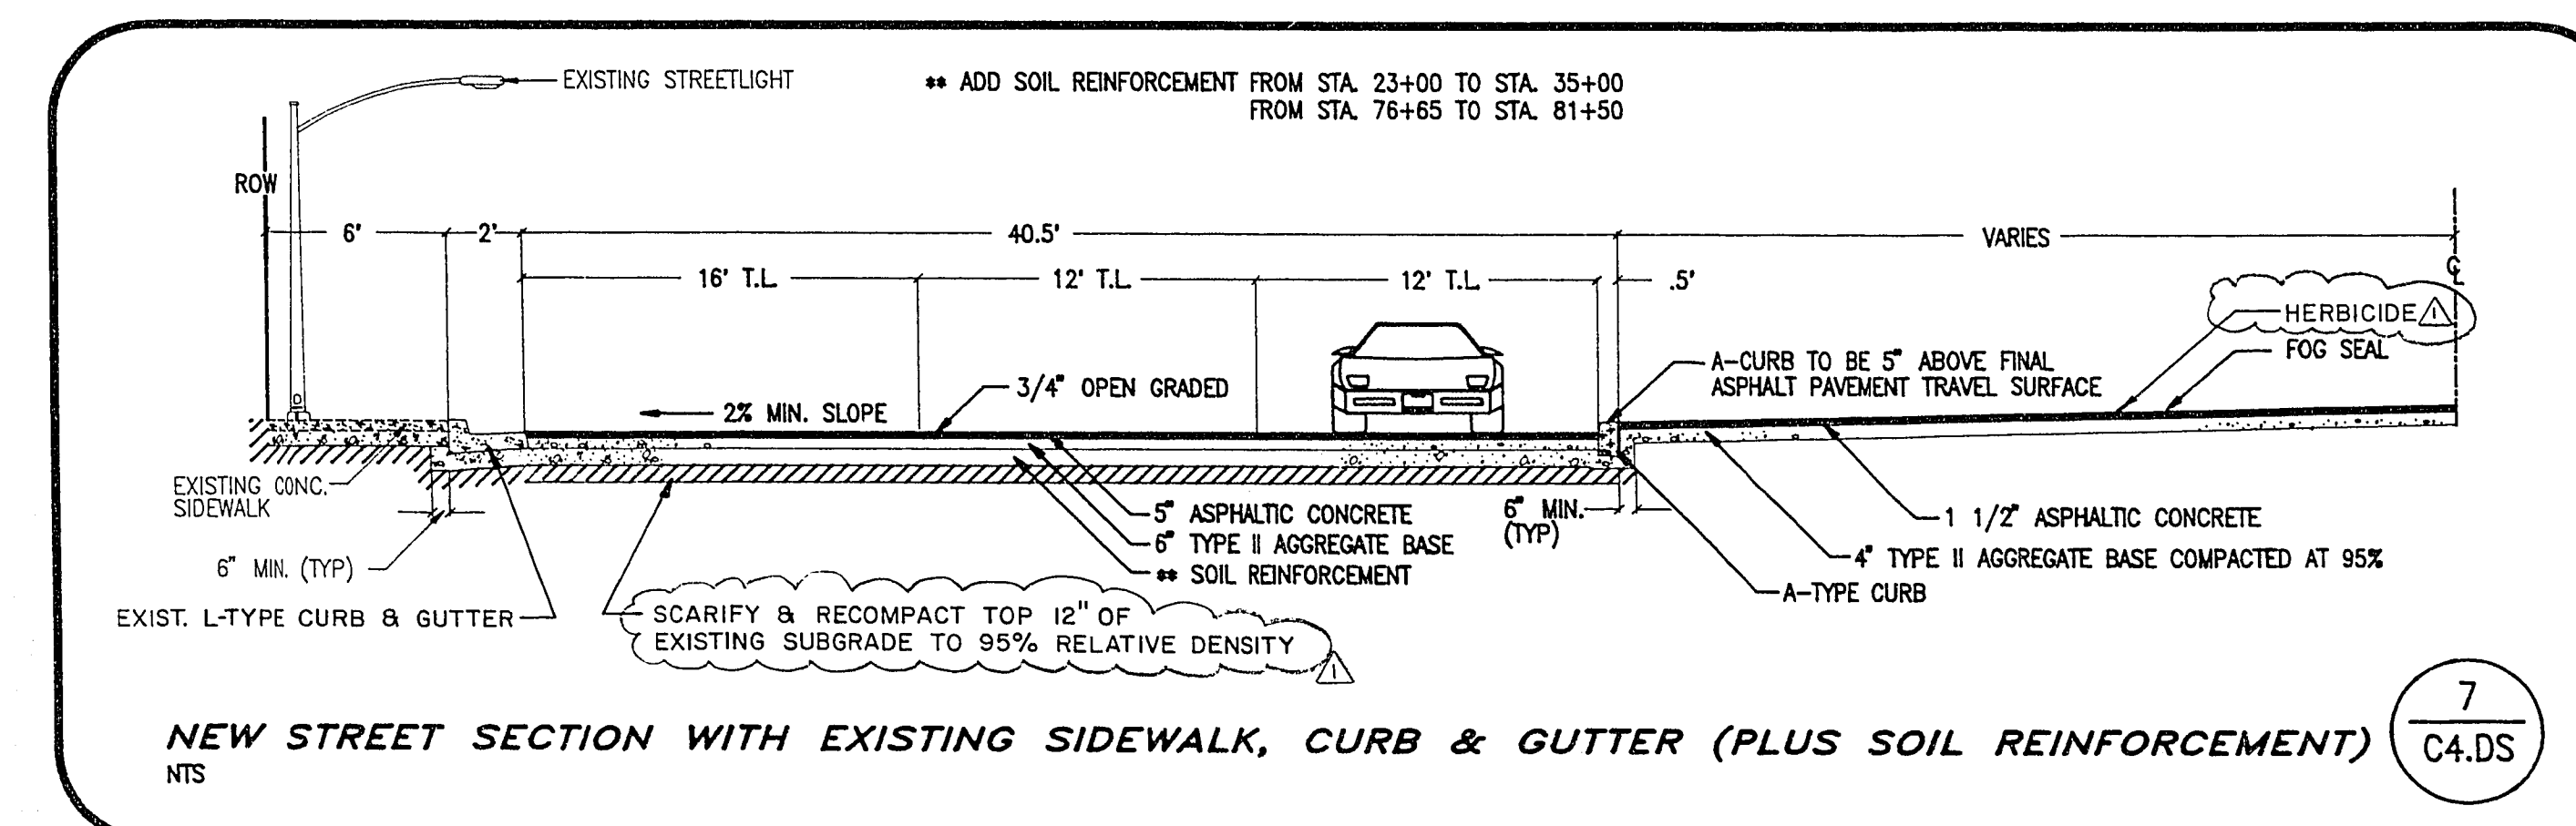
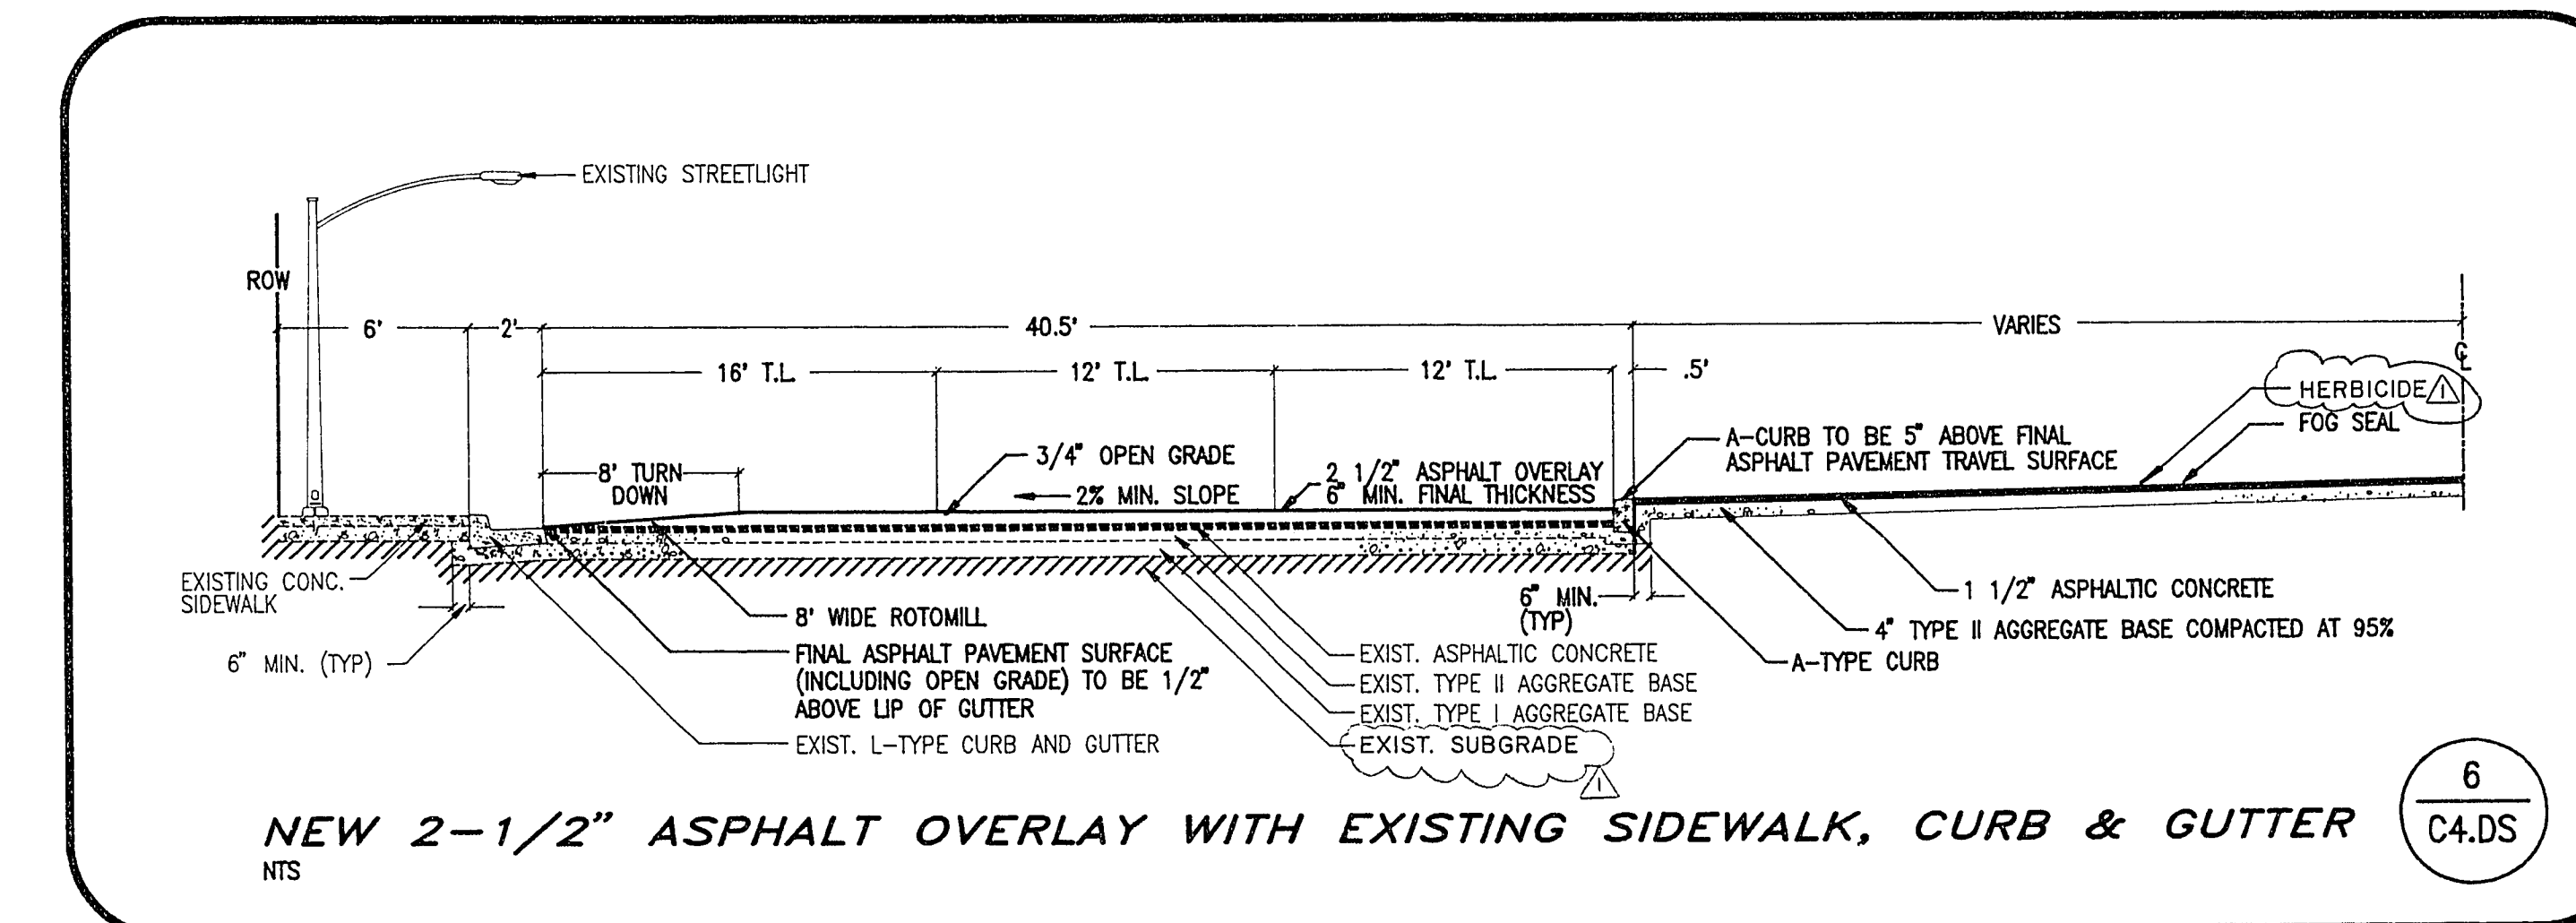
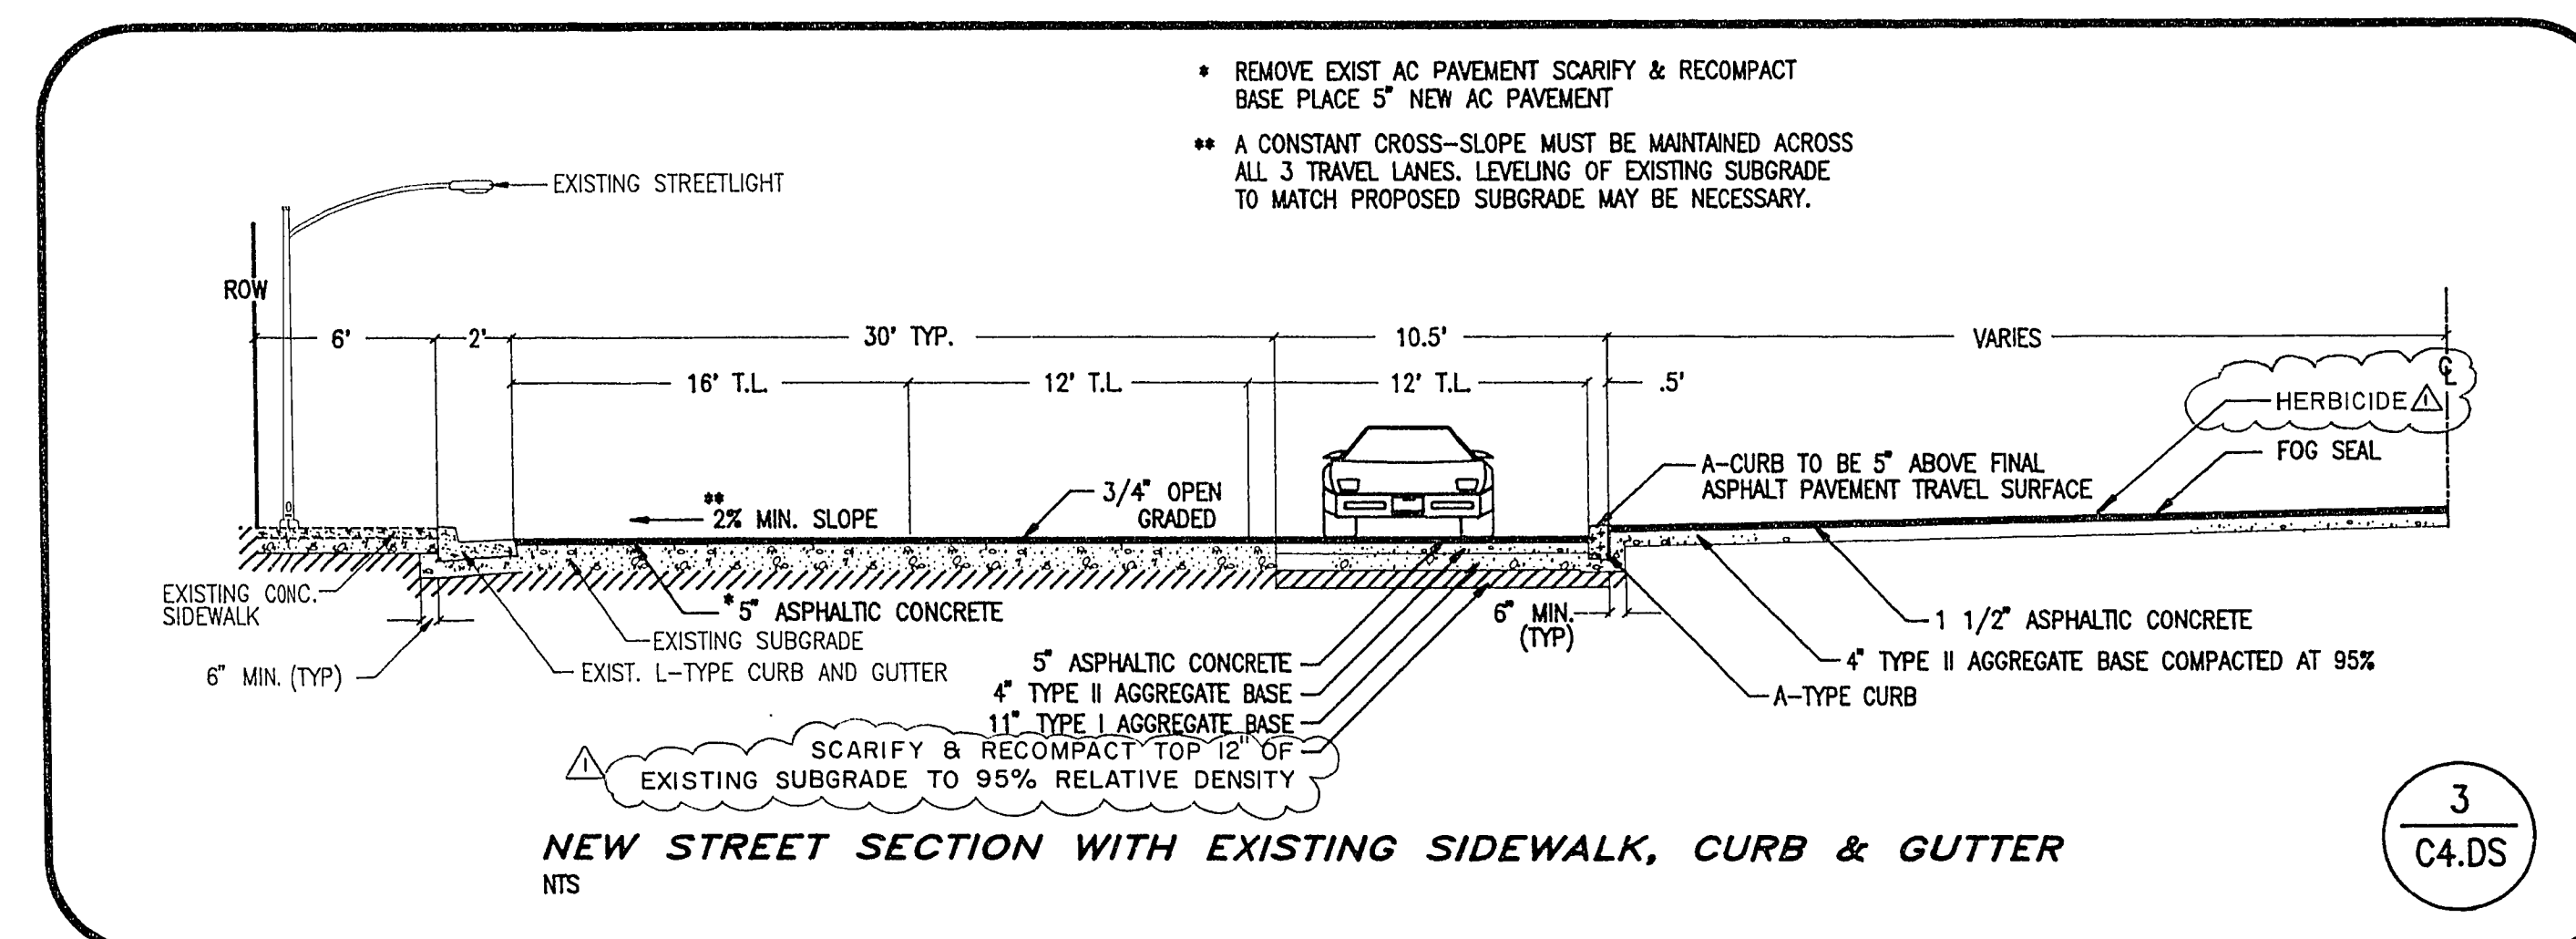
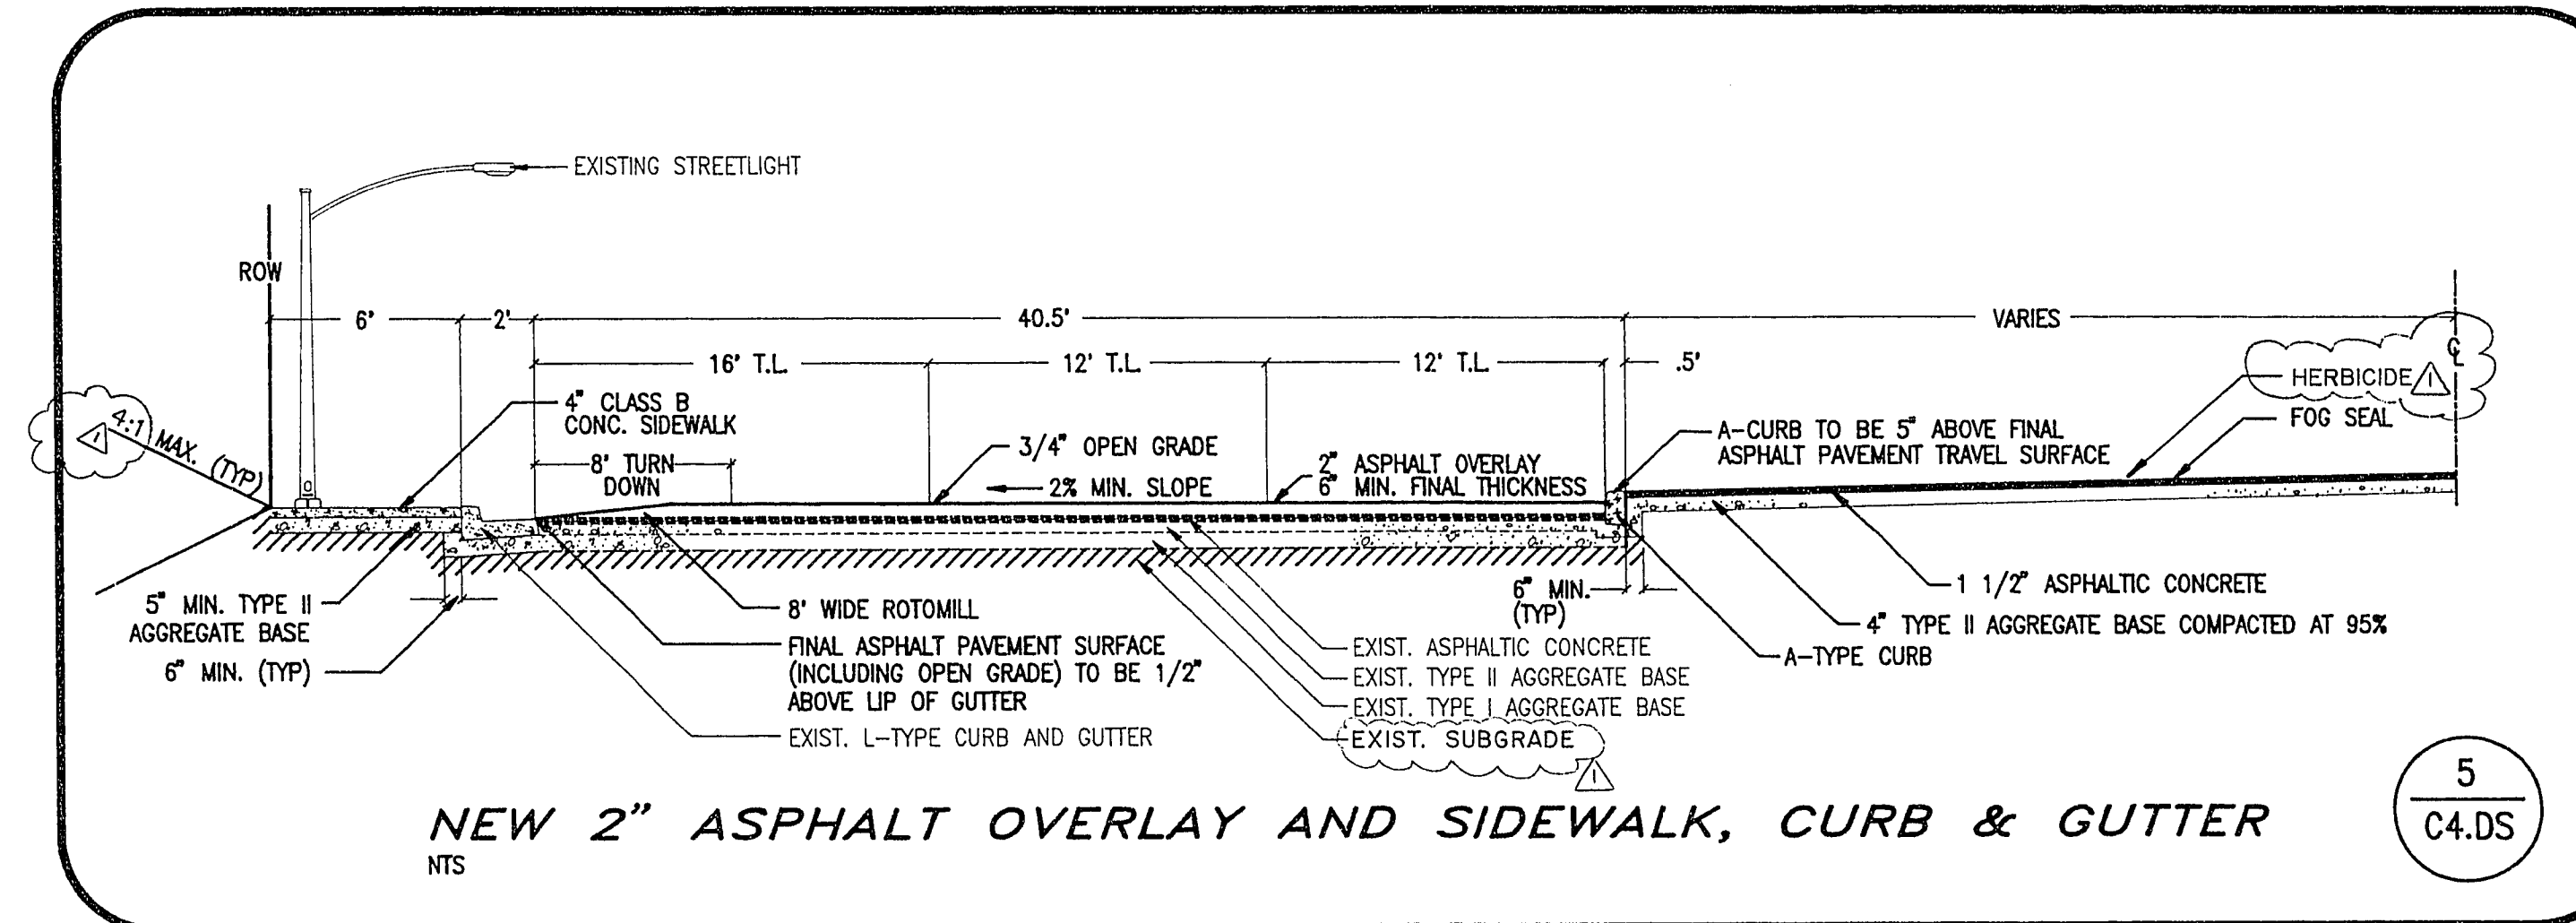
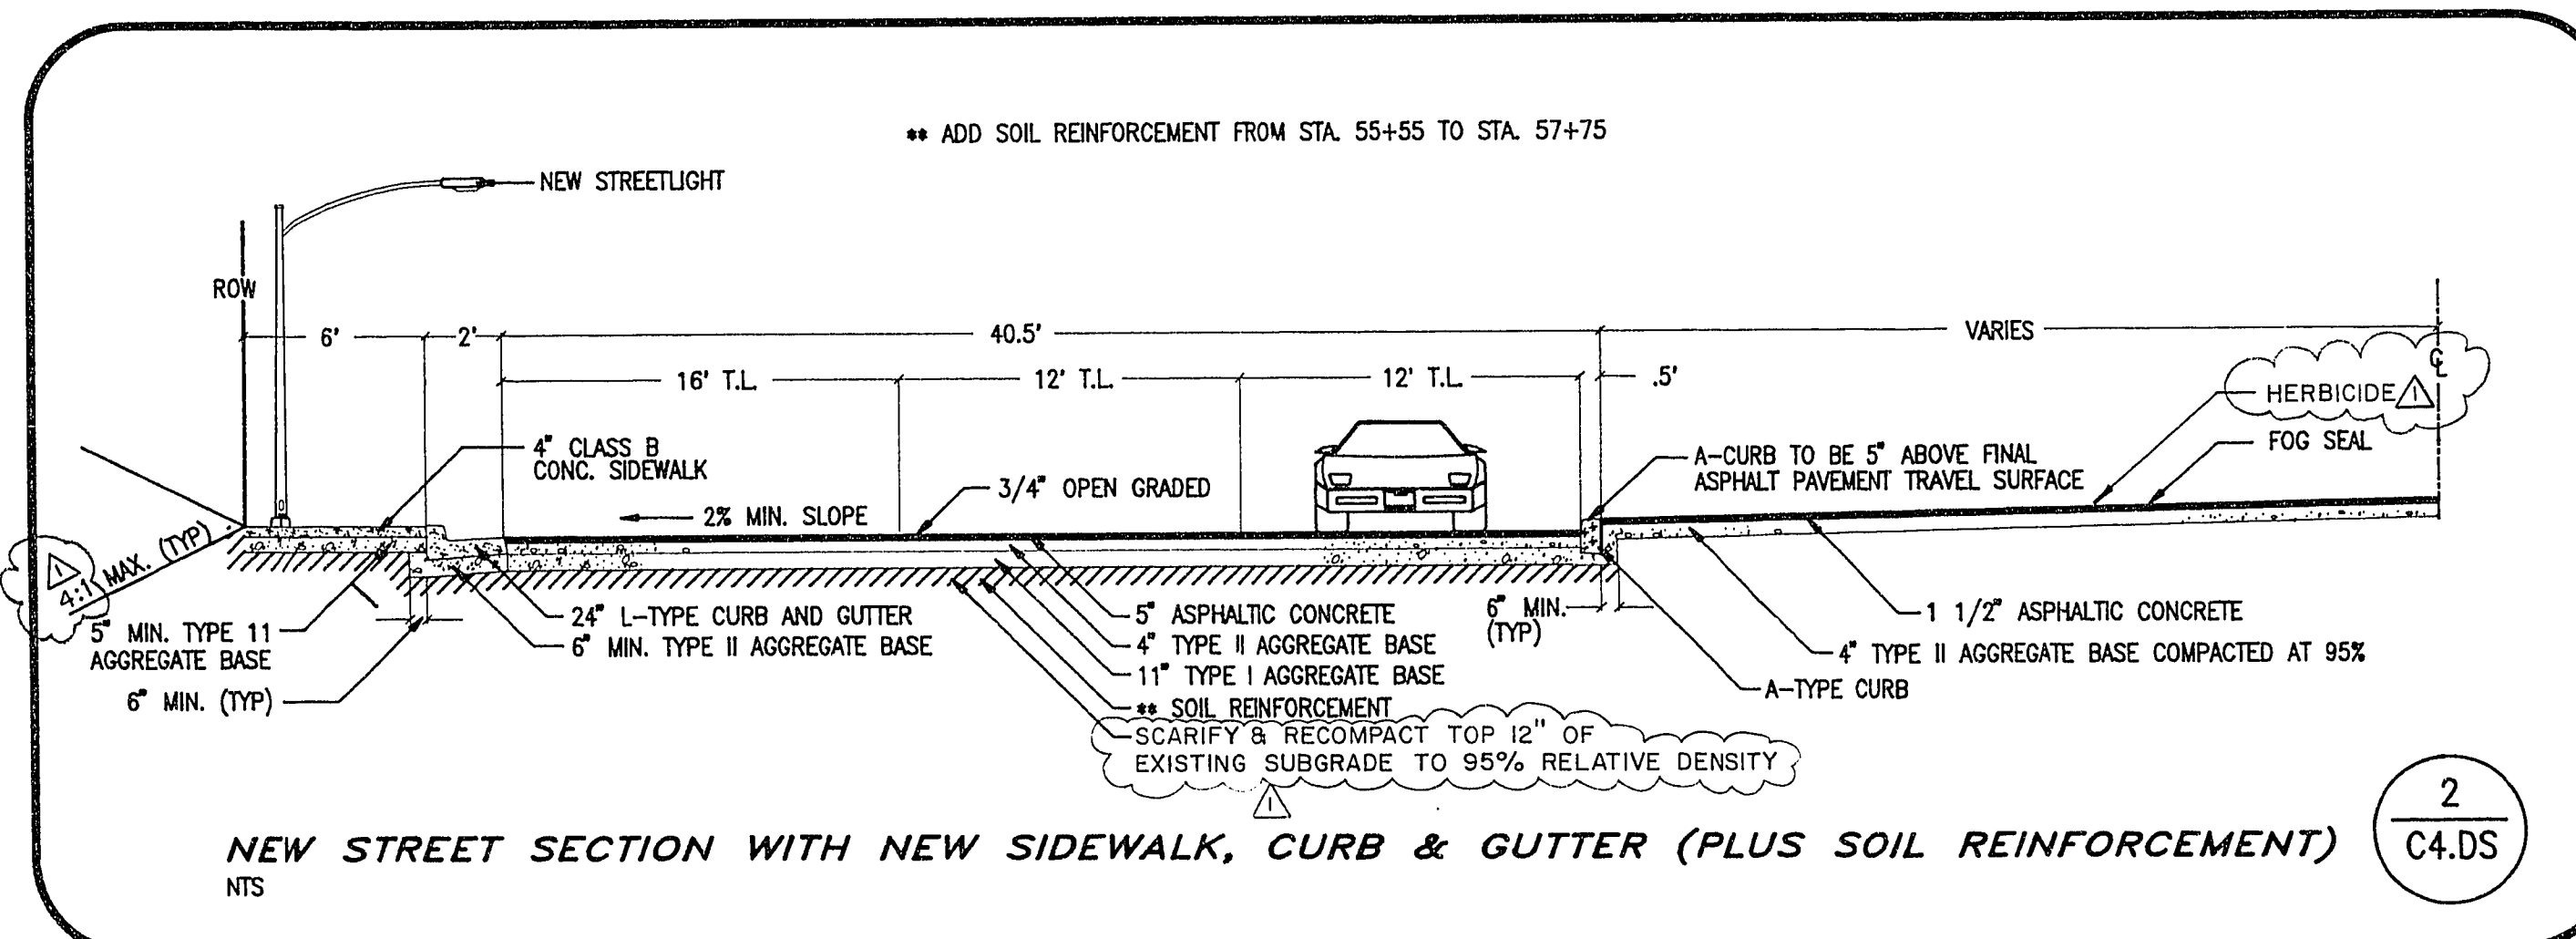
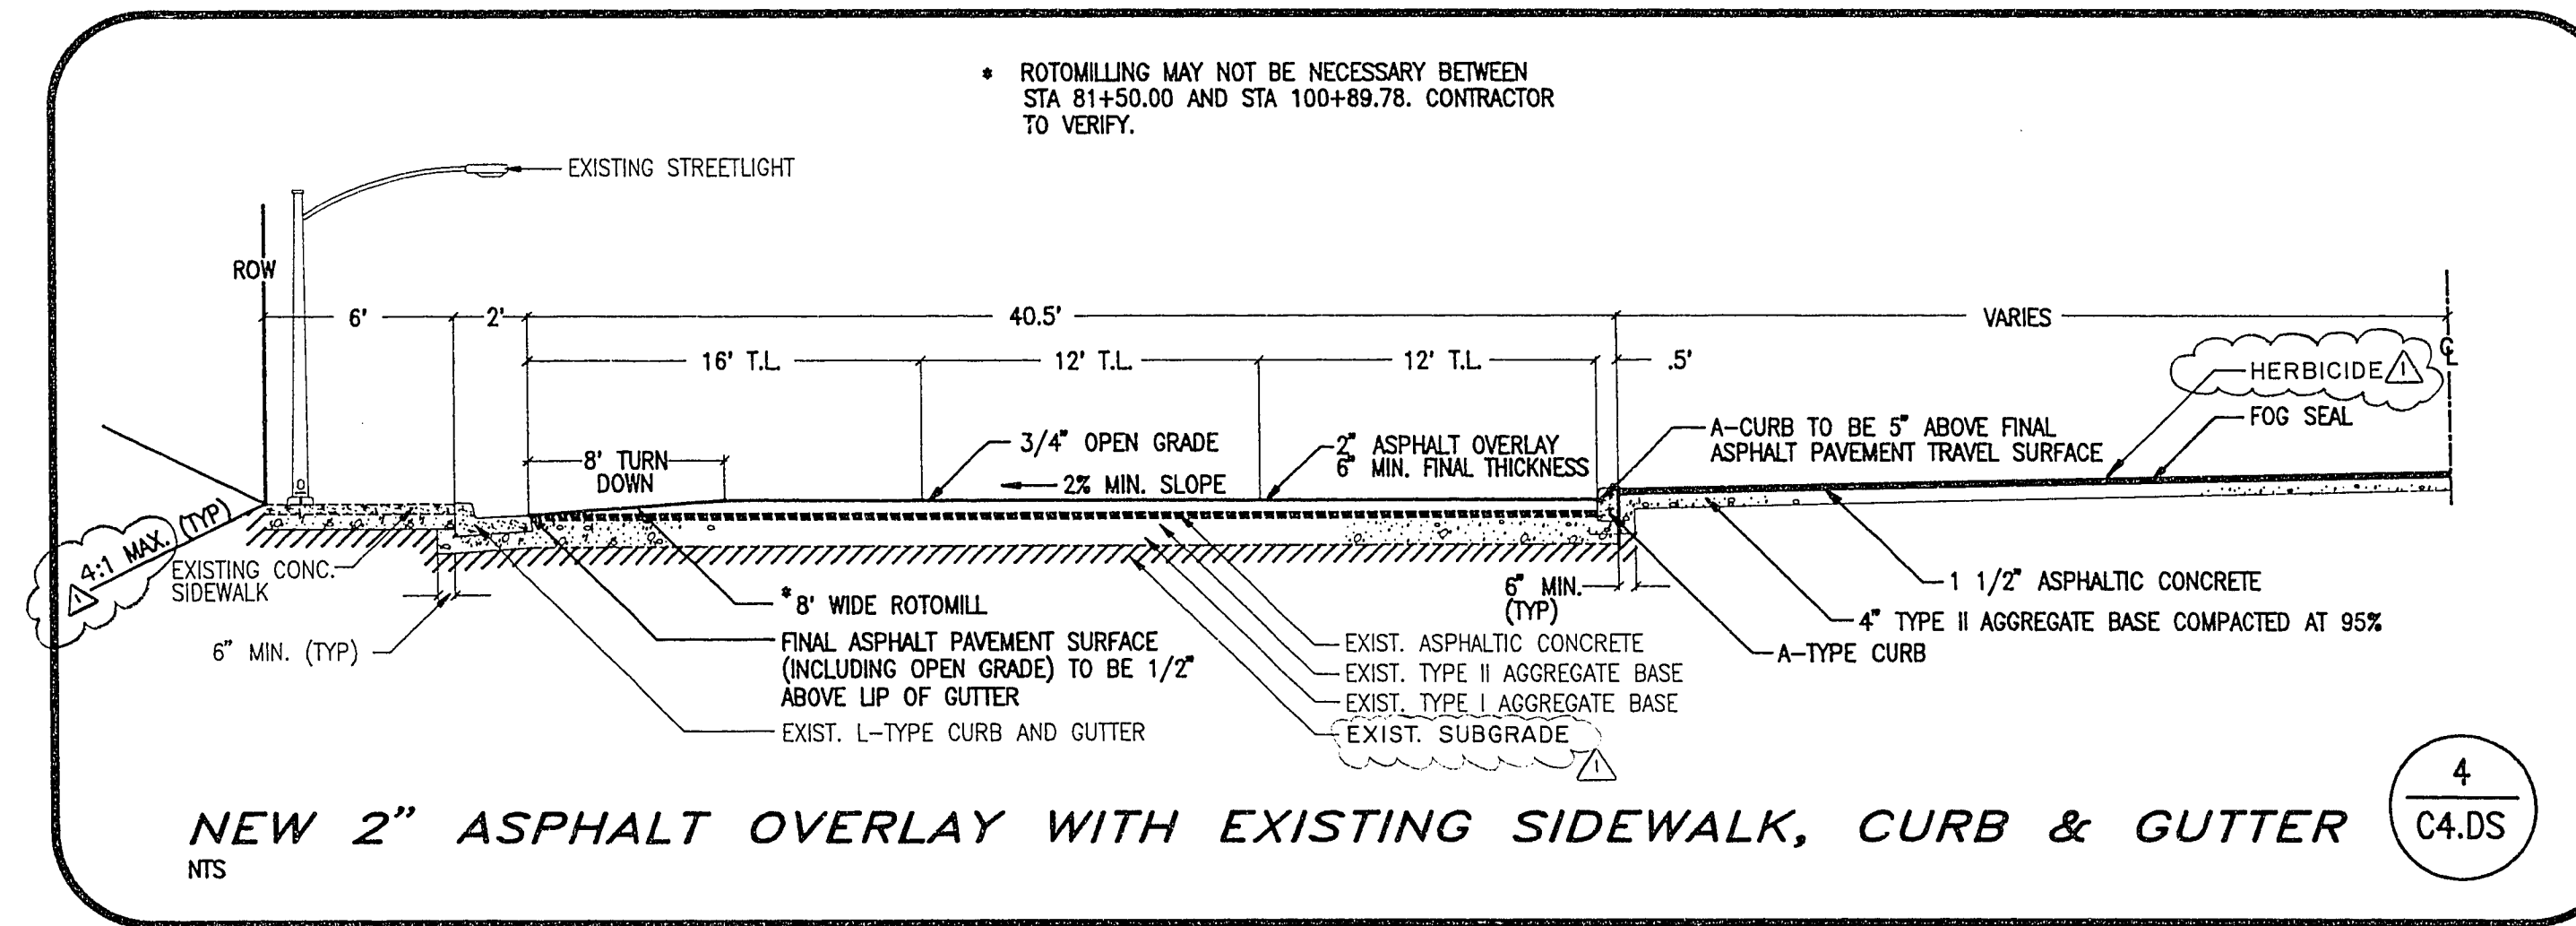


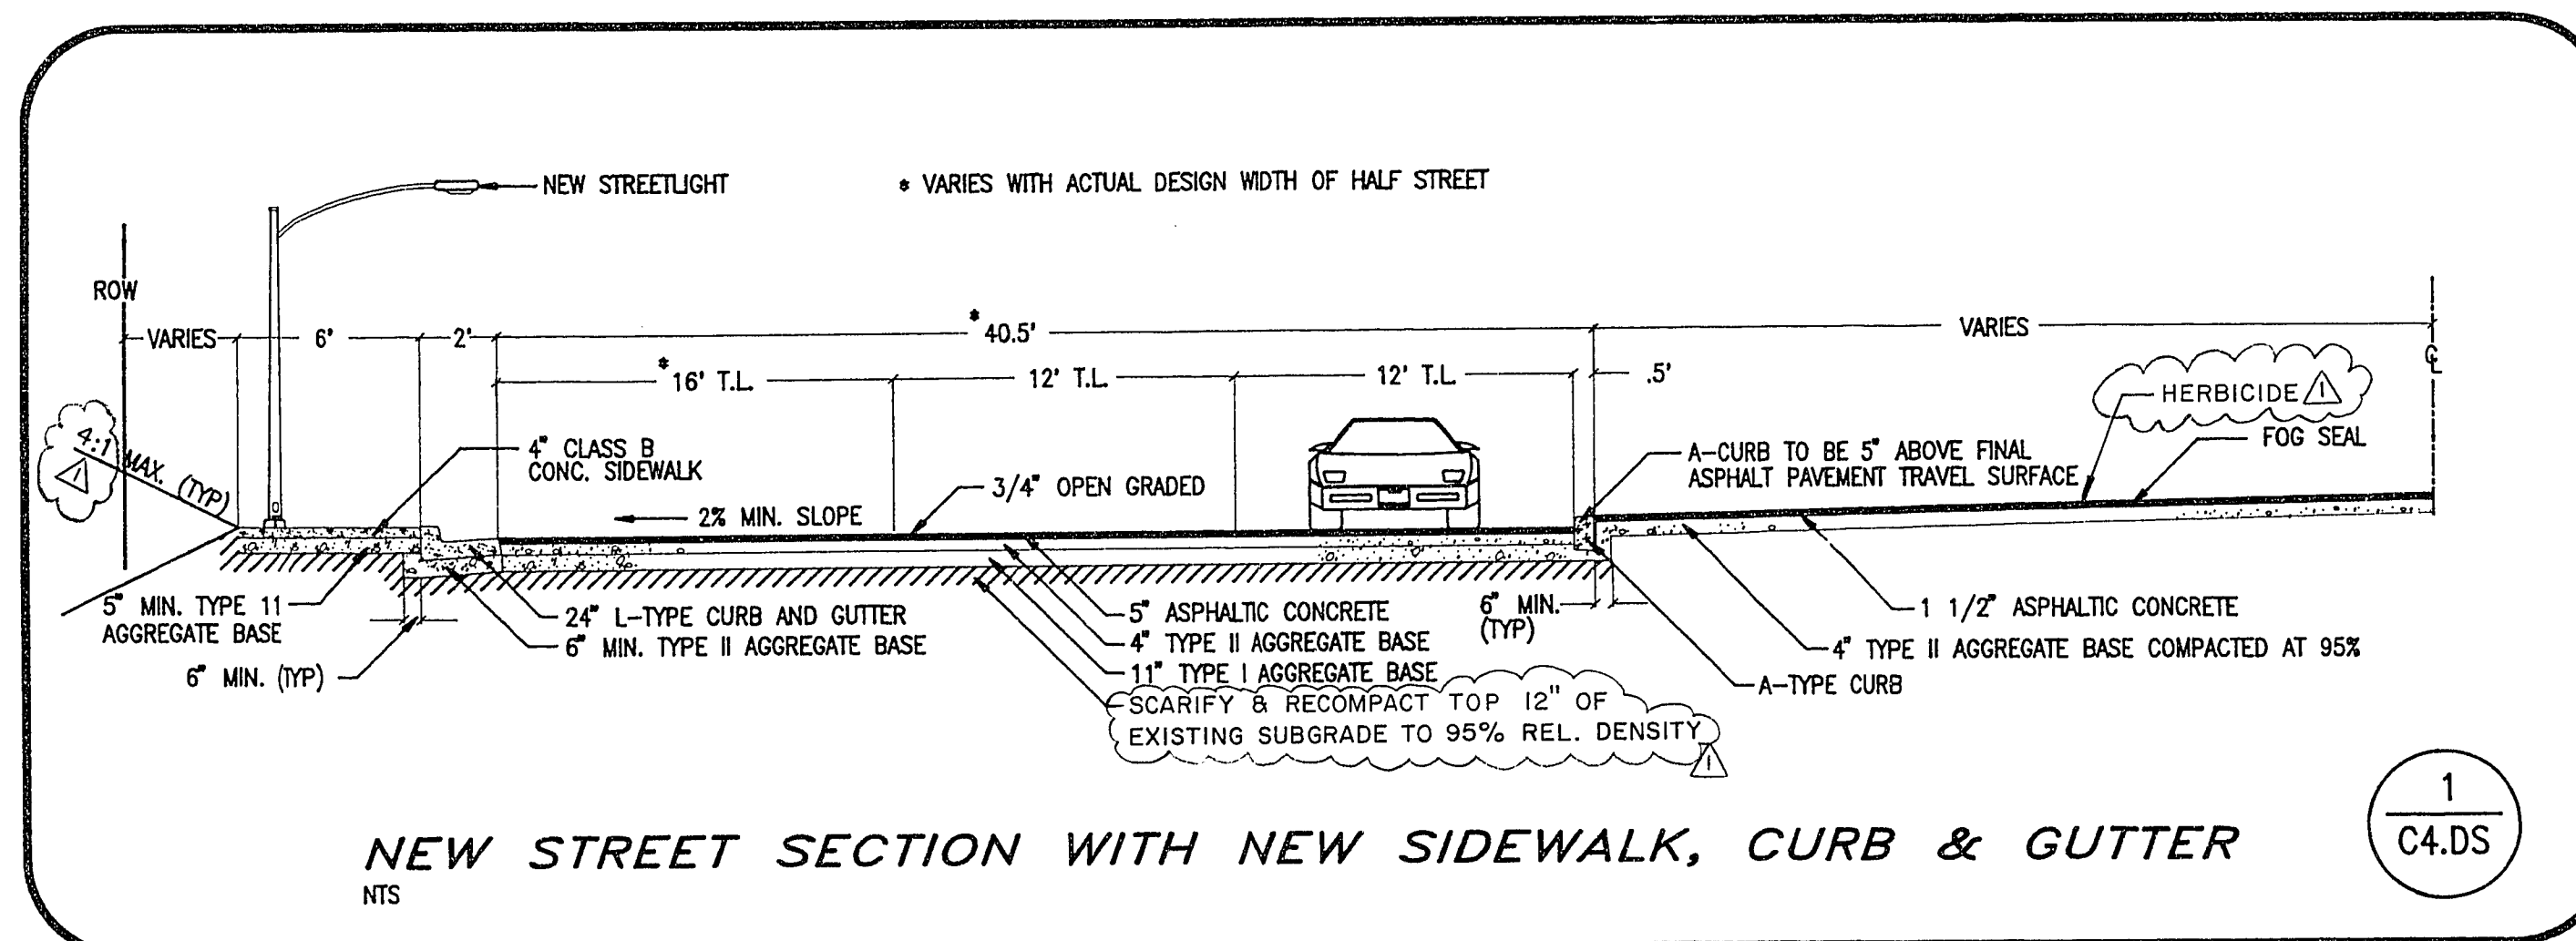

NOTE
ALL MEDIAN CURB SHALL BE
A-CURB PER DRAWING NUMBER
219 UNLESS OTHERWISE NOTED.