


DATE	REVISION
	CITY OF LAS VEGAS ENGINEERING DESIGN
9/92	1/ DRAWING DESIGN REVISED ALONG WITH VARIOUS OTHER MINOR REVISIONS
5/93	2/ ADD WATER CROSSING DETAIL
NOV 10 1992	3/ RELOCATE WATER LINE, MOVE ARROW, REVISIONS, NOTE

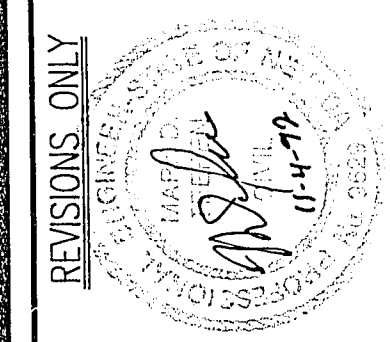

**HEFNER
ENGINEERING**

CIVIL ENGINEERING DESIGN
LAND PLANNING & DEVELOPMENT

4441 South Polaris Avenue, Las Vegas, Nevada 89103
Phone: (702) 798-1900

CRAIG ROAD
UTILITY PLAN AND PROFILE
STATION 58+48.79 TO STATION 63+07.77

SHEET NO.

C5.7.1

107-V1804
G89042PG DATE: 11/25/91