


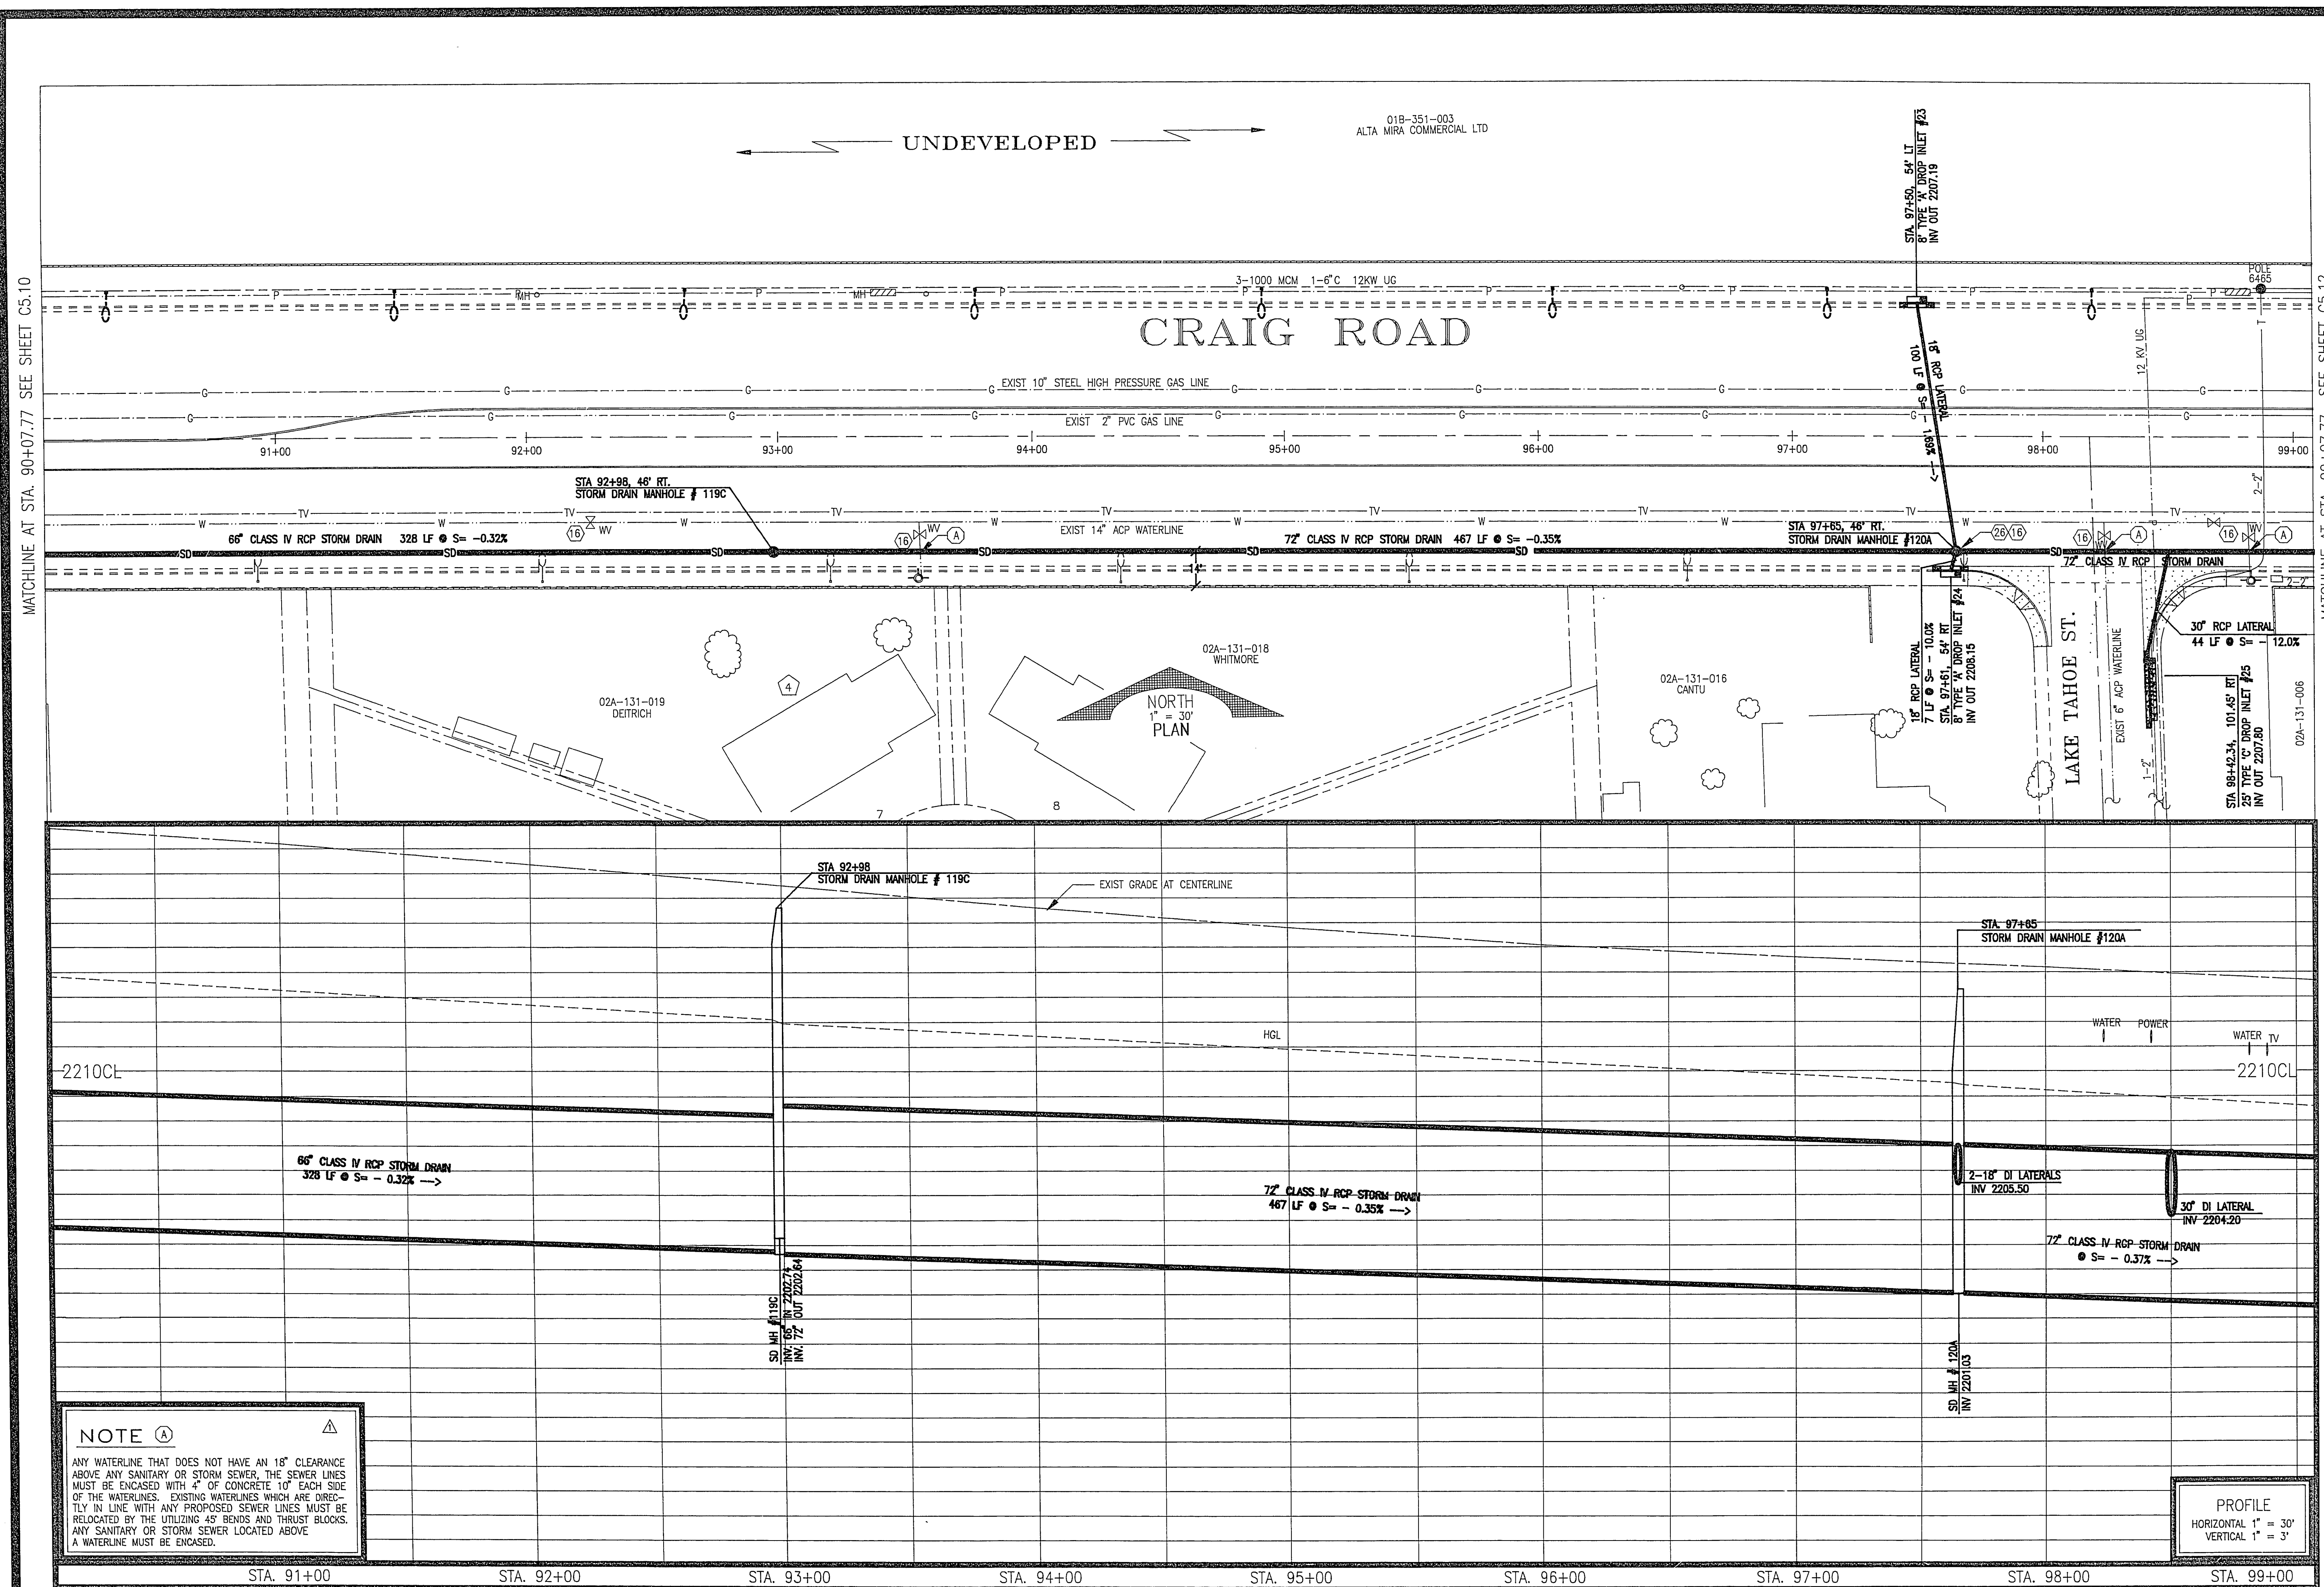

DATE	REVISION
	CITY OF LAS VEGAS ENGINEERING DESIGN
9/92	△ DRAINAGE DESIGN REVISED ALONG WITH VARIOUS OTHER MINOR REVISIONS
TO JUNE 1992	△ ADD MH # 119B, SLOPE CORRECTION, ENGAGEMENT NOTE

REVISIONS: ONLY



HEFFNER
ENGINEERING

CIVIL ENGINEERING DESIGN
LAND PLANNING & DEVELOPMENT

4441 South Pointe Avenue, East Village, Nevada 89103
Phone: (702) 798-1900

REVISIONS PERFORMED TO EXISTING DRAWINGS BY THE CITY OF LAS VEGAS ENGINEERING DIVISION
ORIGINAL HEFNER ENGINEERING DESIGN DRAWINGS ON FILE AT THE CITY OF LAS VEGAS