



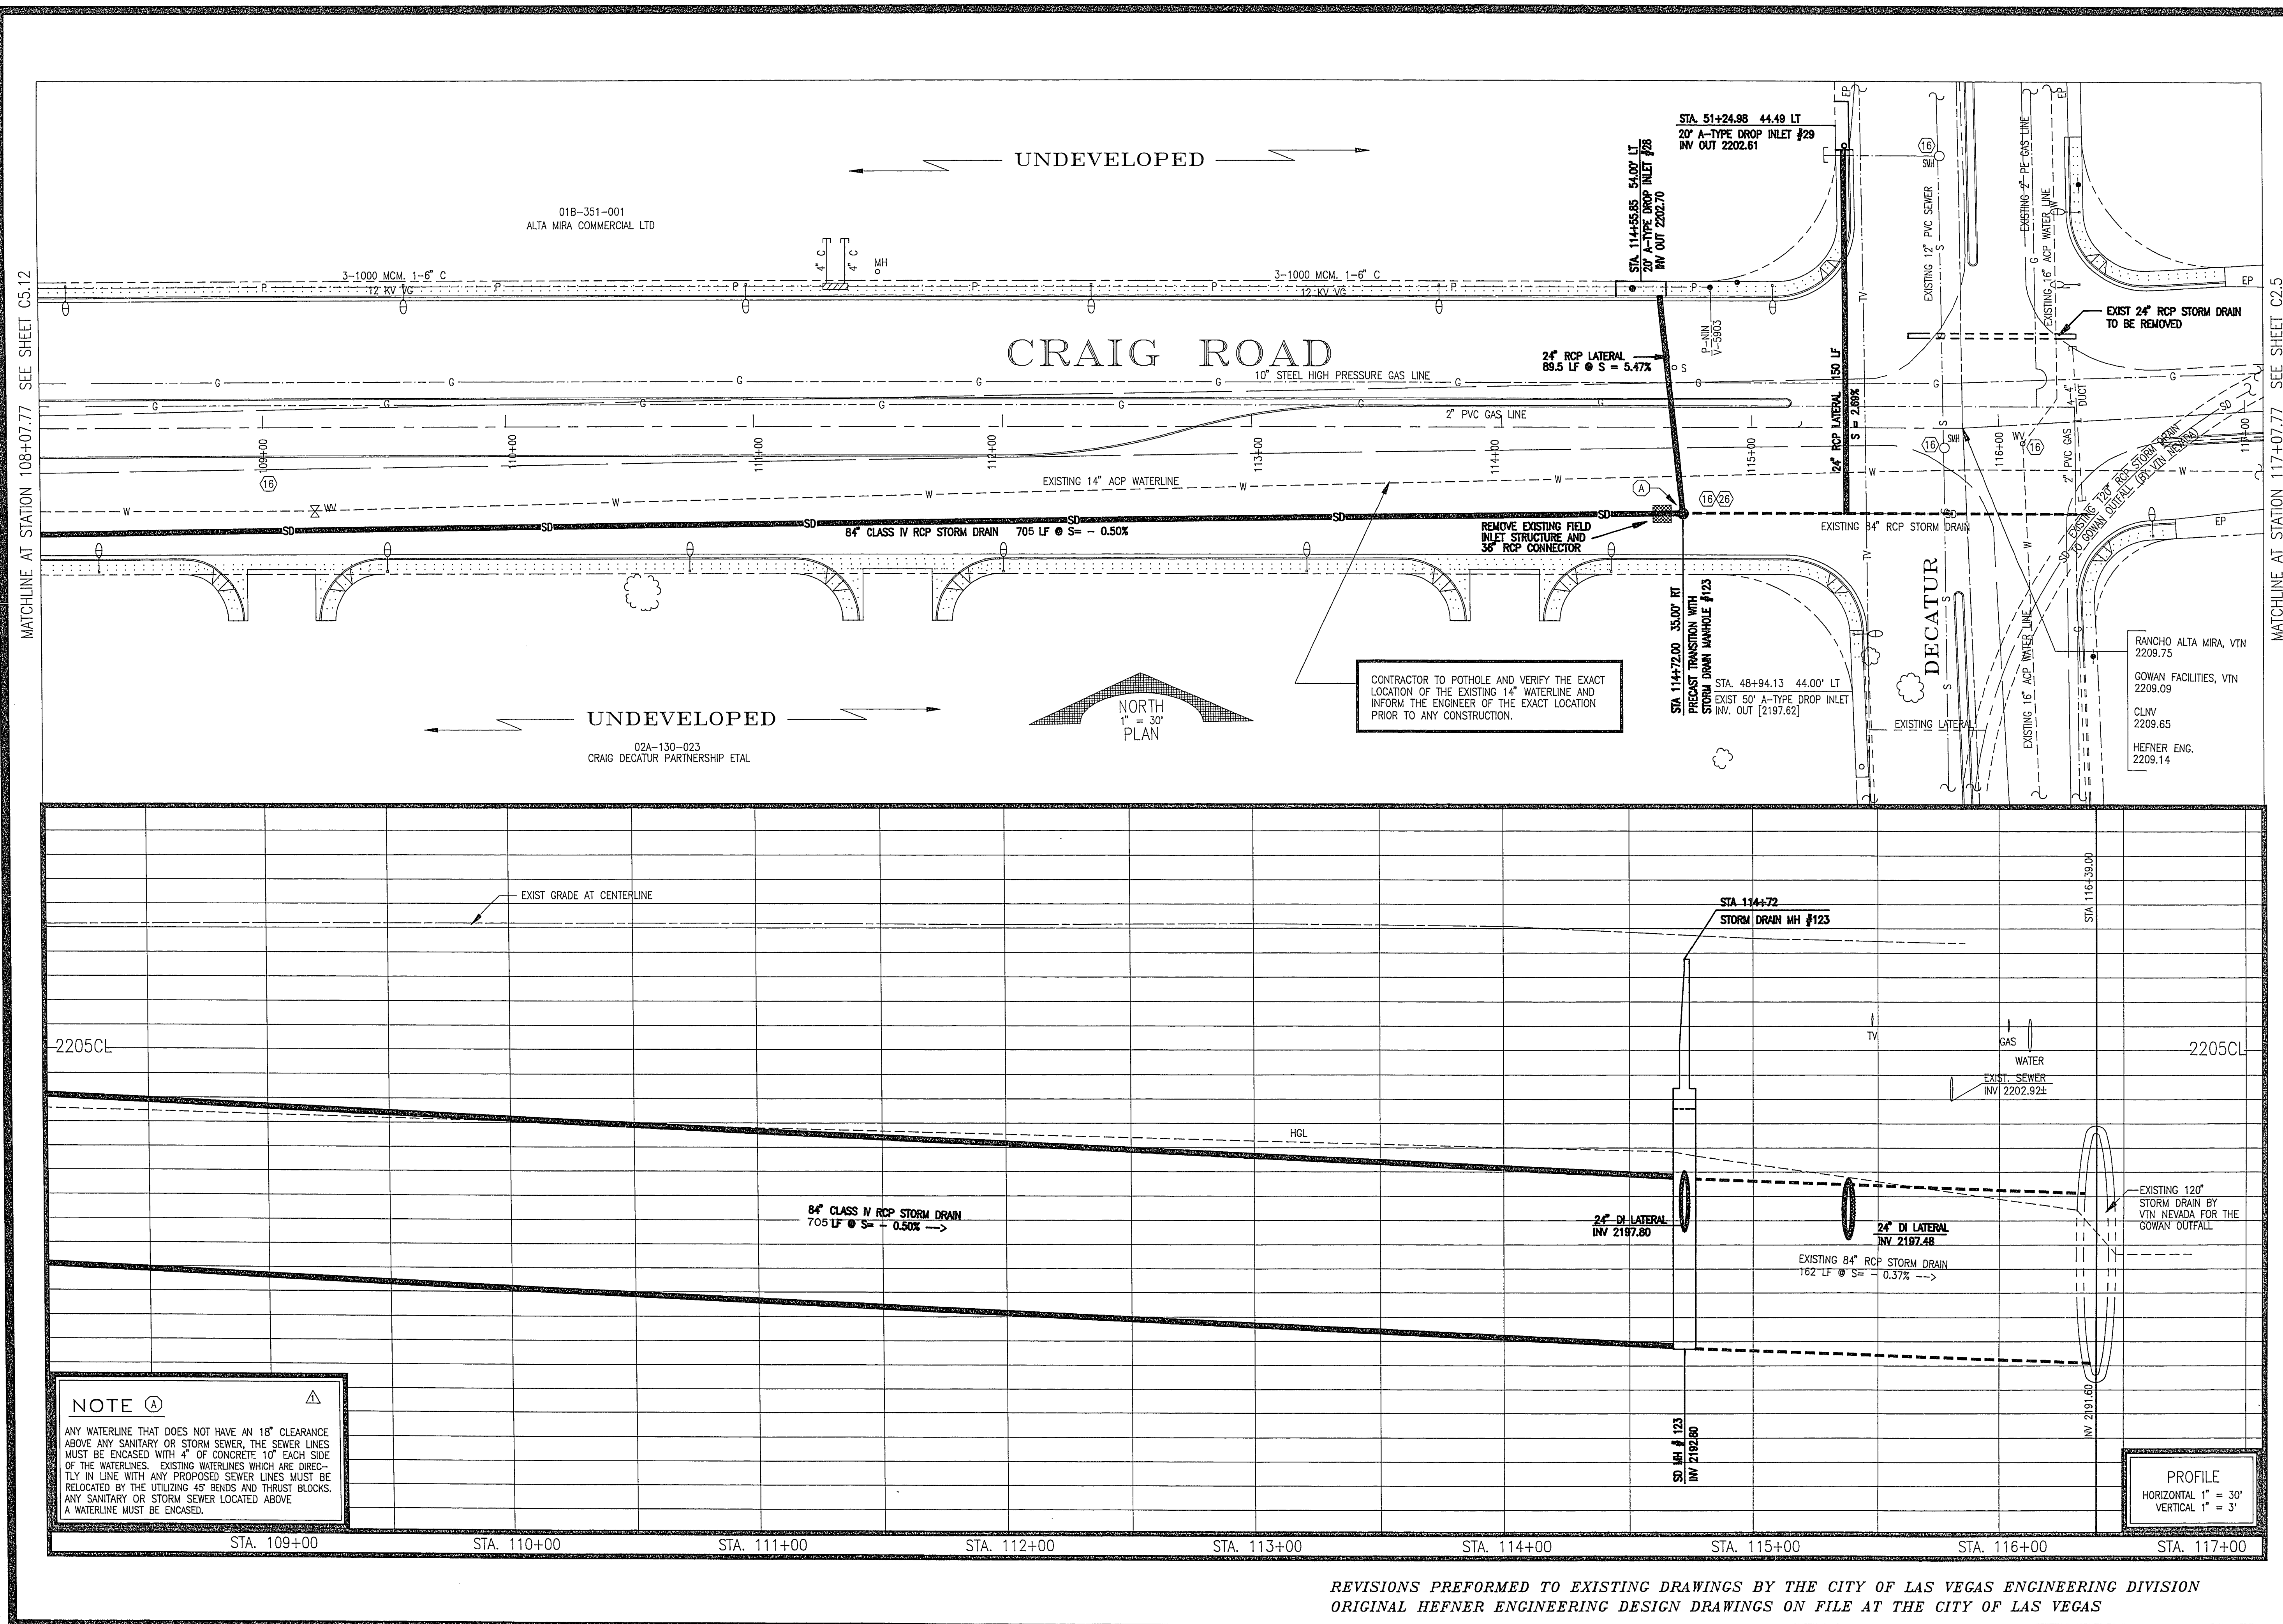

DATE	REVISION
	CITY OF LAS VEGAS ENGINEERING DESIGN
9/92	△ DRAINAGE DESIGN REVISED ALONG WITH
	VARIOUS OTHER MINOR REVISIONS
23 JUL 1992	△ NARROW MEDIAN FOR DUAL LEFT TURNS. REMOVE INLET STRUCTURE. ENCASEMENT NOTE
5 MAY 1992	△ RELOCATE EXIST. W/DR. LINE. NOTE: 5' W/DR. LINE. EXIST. W/DR. LINE. REMOVED.

REVISIONS ONLY

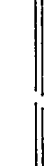

HEFFNER
ENGINEERING

CIVIL ENGINEERING DESIGN
LAND PLANNING & DEVELOPMENT

4441 South Polaris Avenue, Las Vegas, Nevada 89103
Phone: (702) 798-1900

CRAIG ROAD
UTILITY PLAN AND PROFILE
STATION 108+07.77 TO STATION 117+07.77

SHEET NO.

C5.13.1

107-V1804

REVISIONS PERFORMED TO EXISTING DRAWINGS BY THE CITY OF LAS VEGAS ENGINEERING DIVISION
ORIGINAL HEFNER ENGINEERING DESIGN DRAWINGS ON FILE AT THE CITY OF LAS VEGAS