
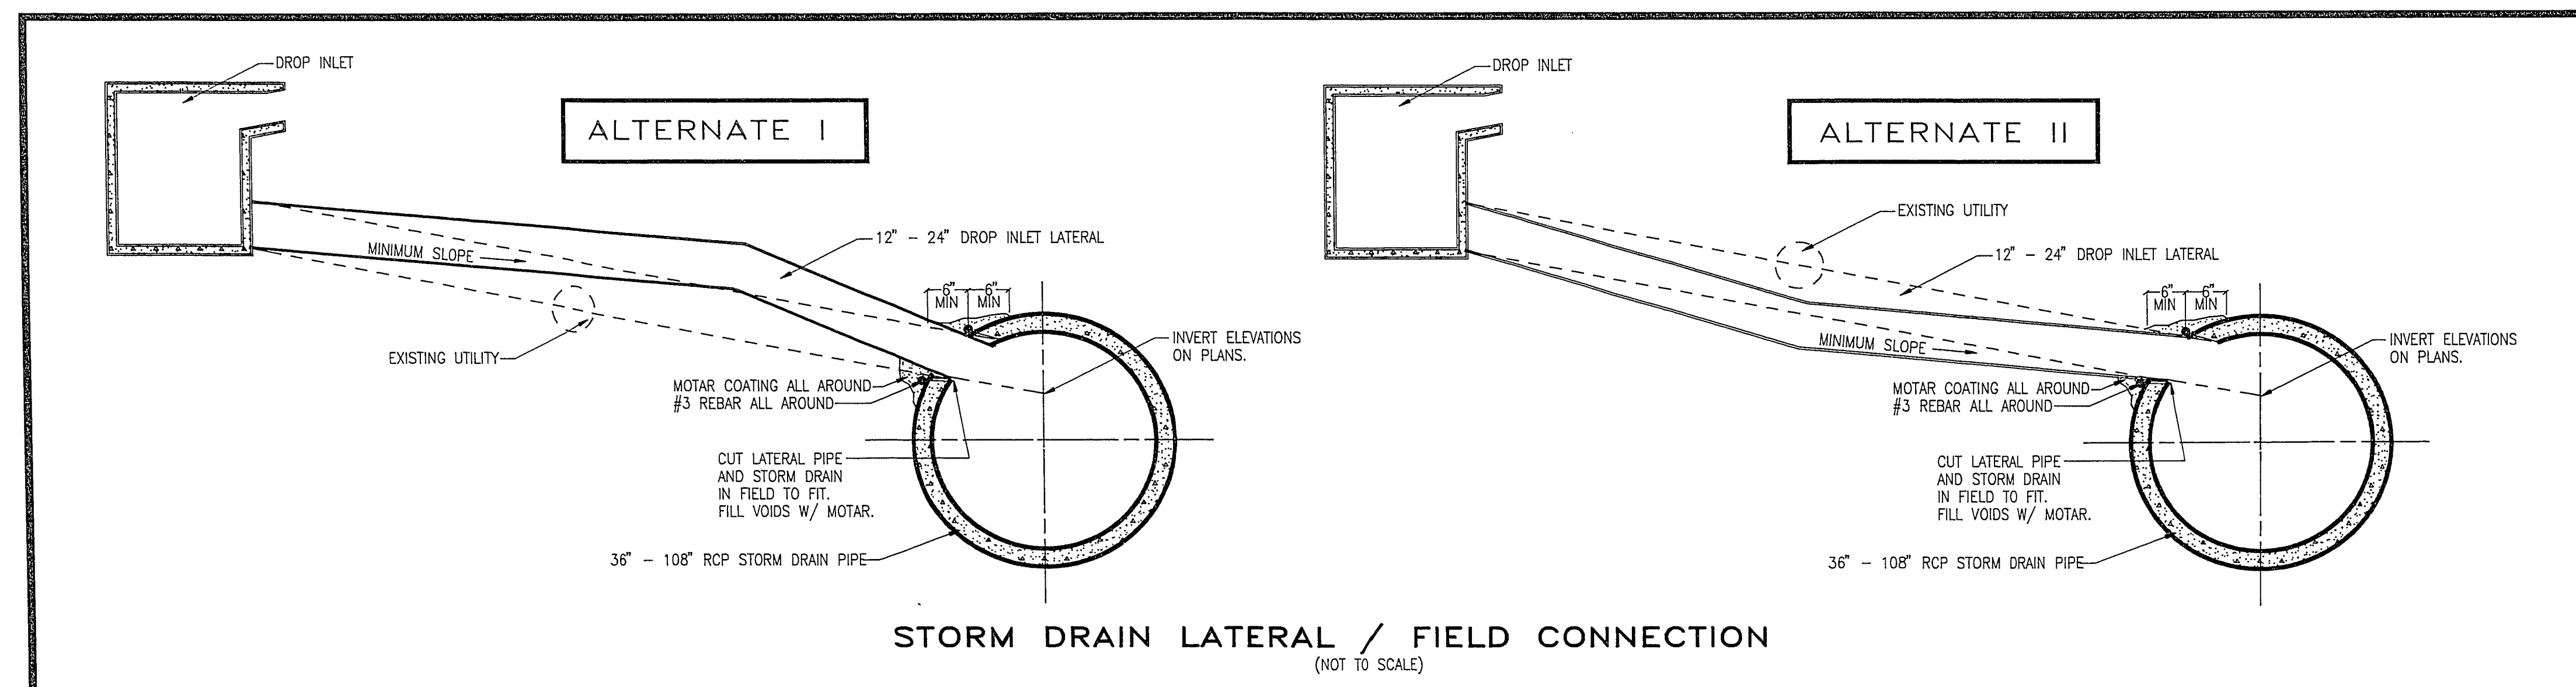
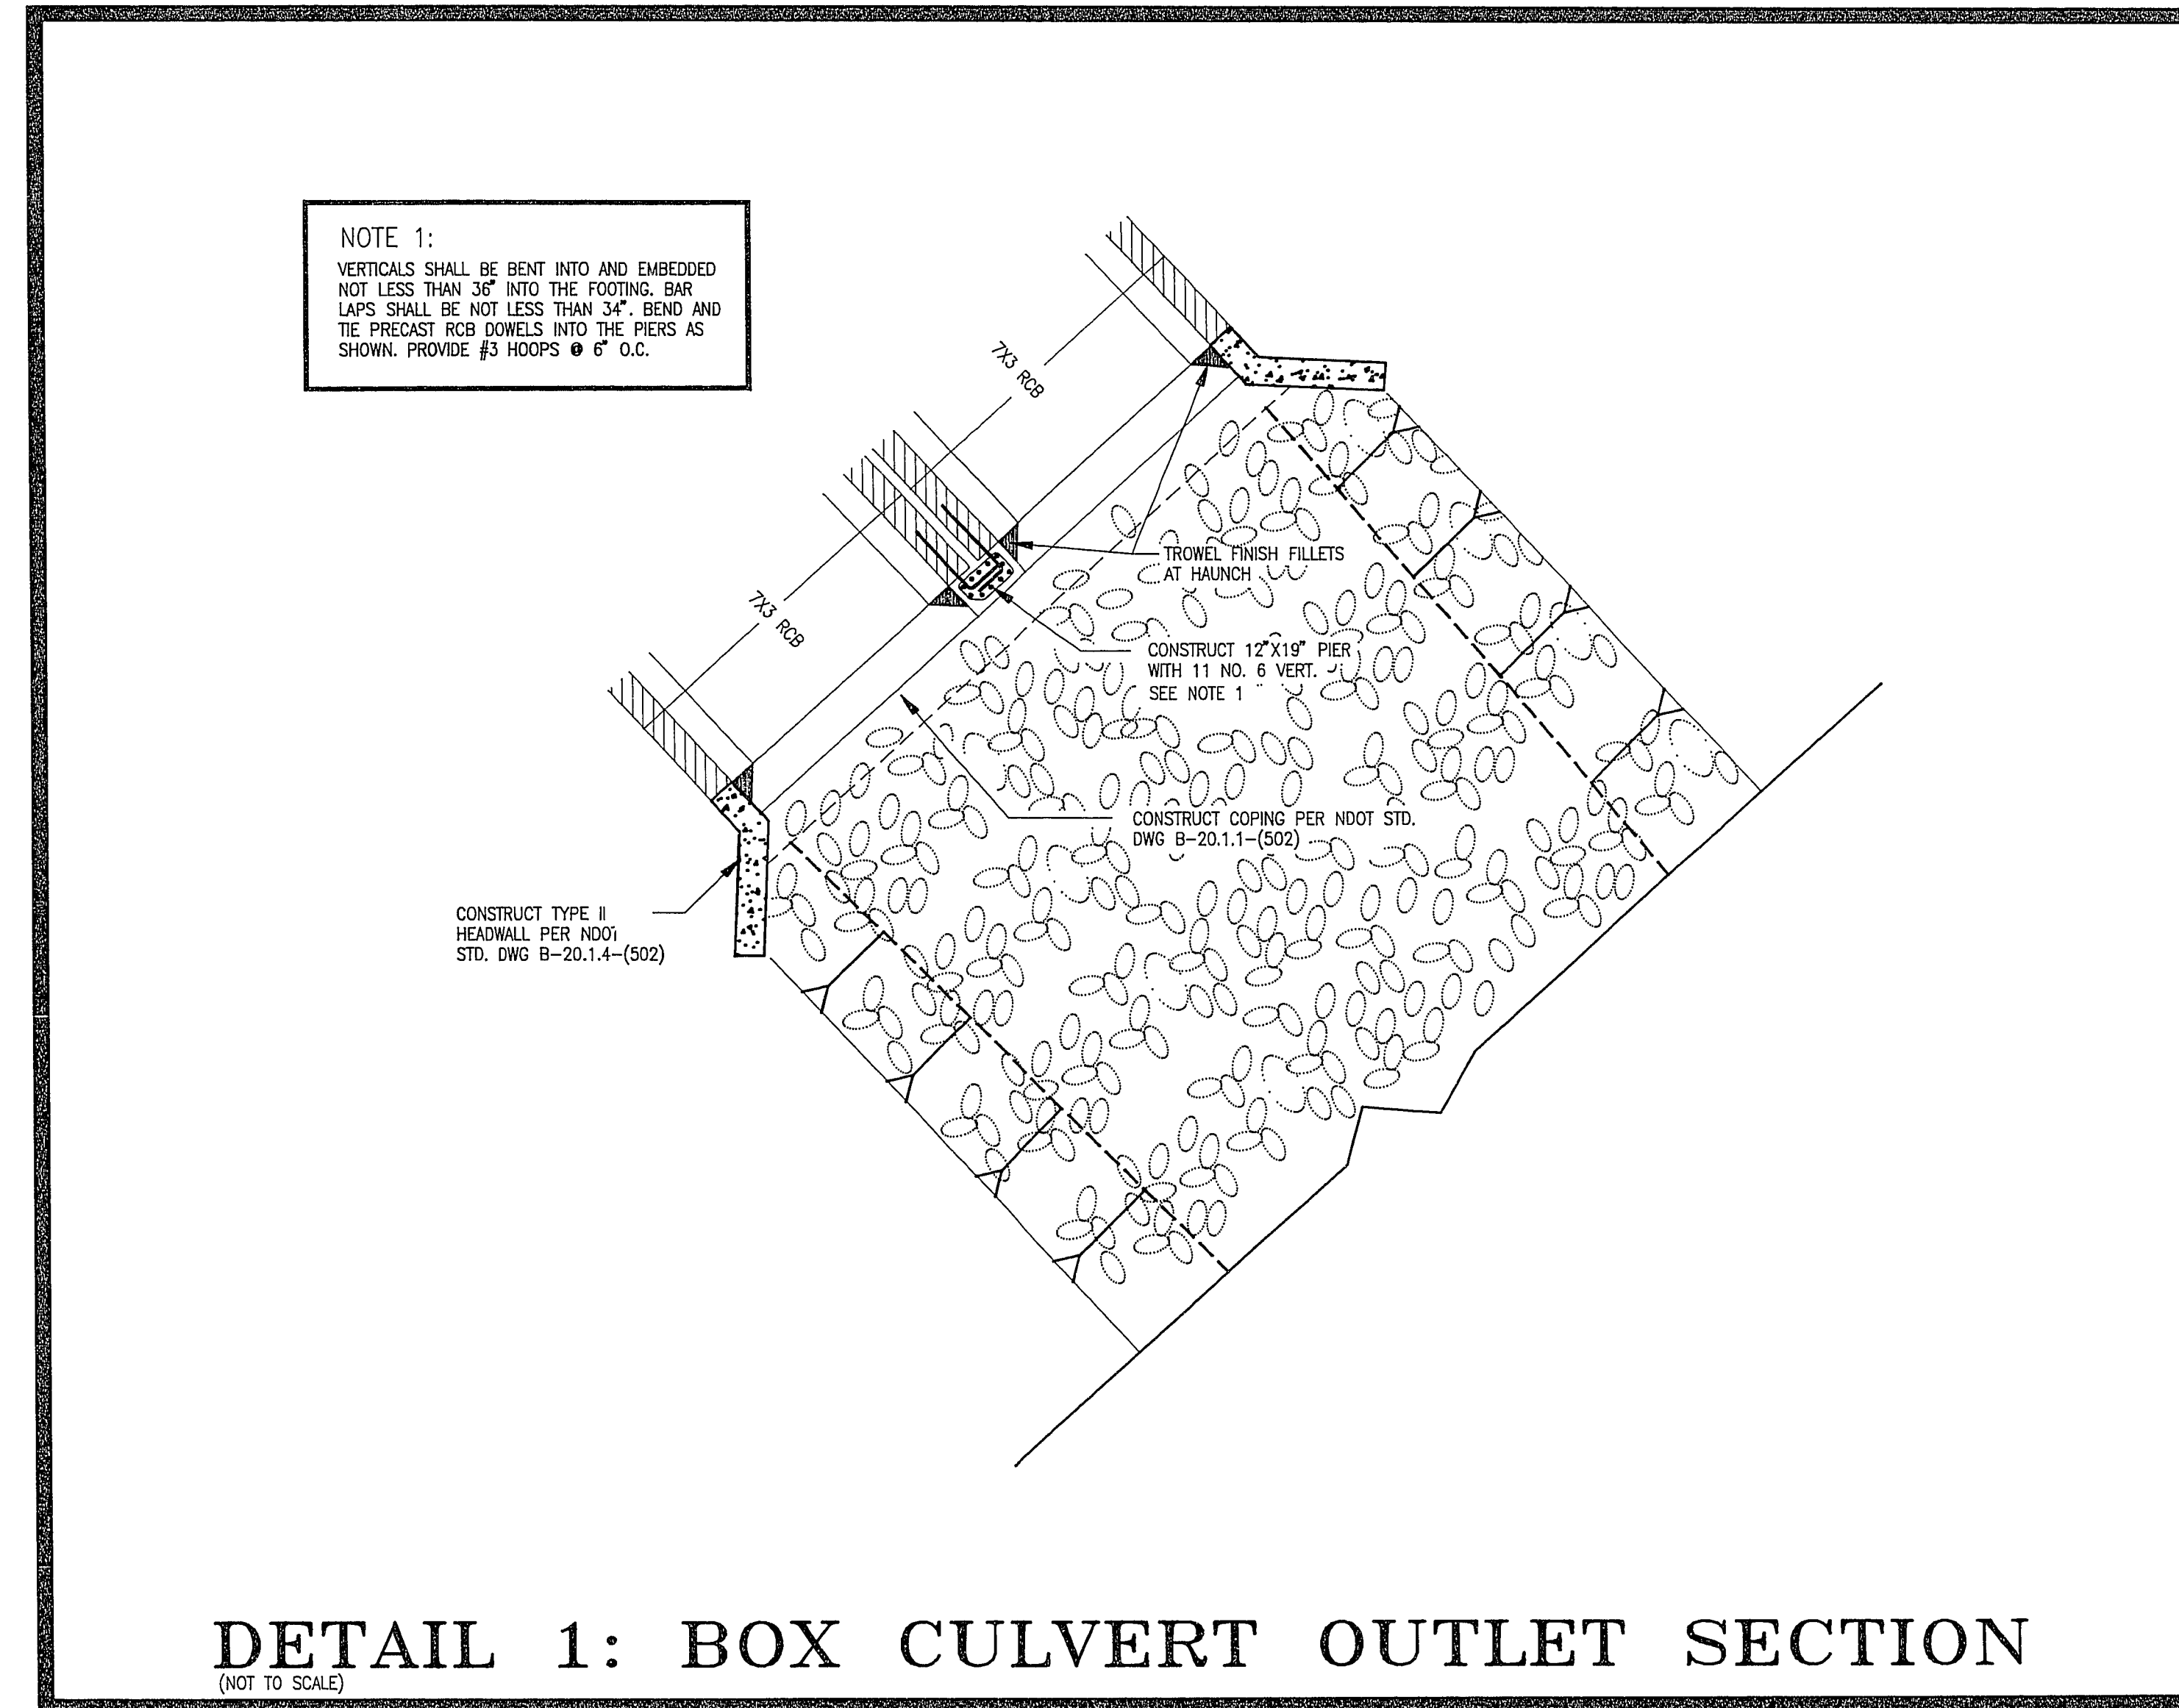
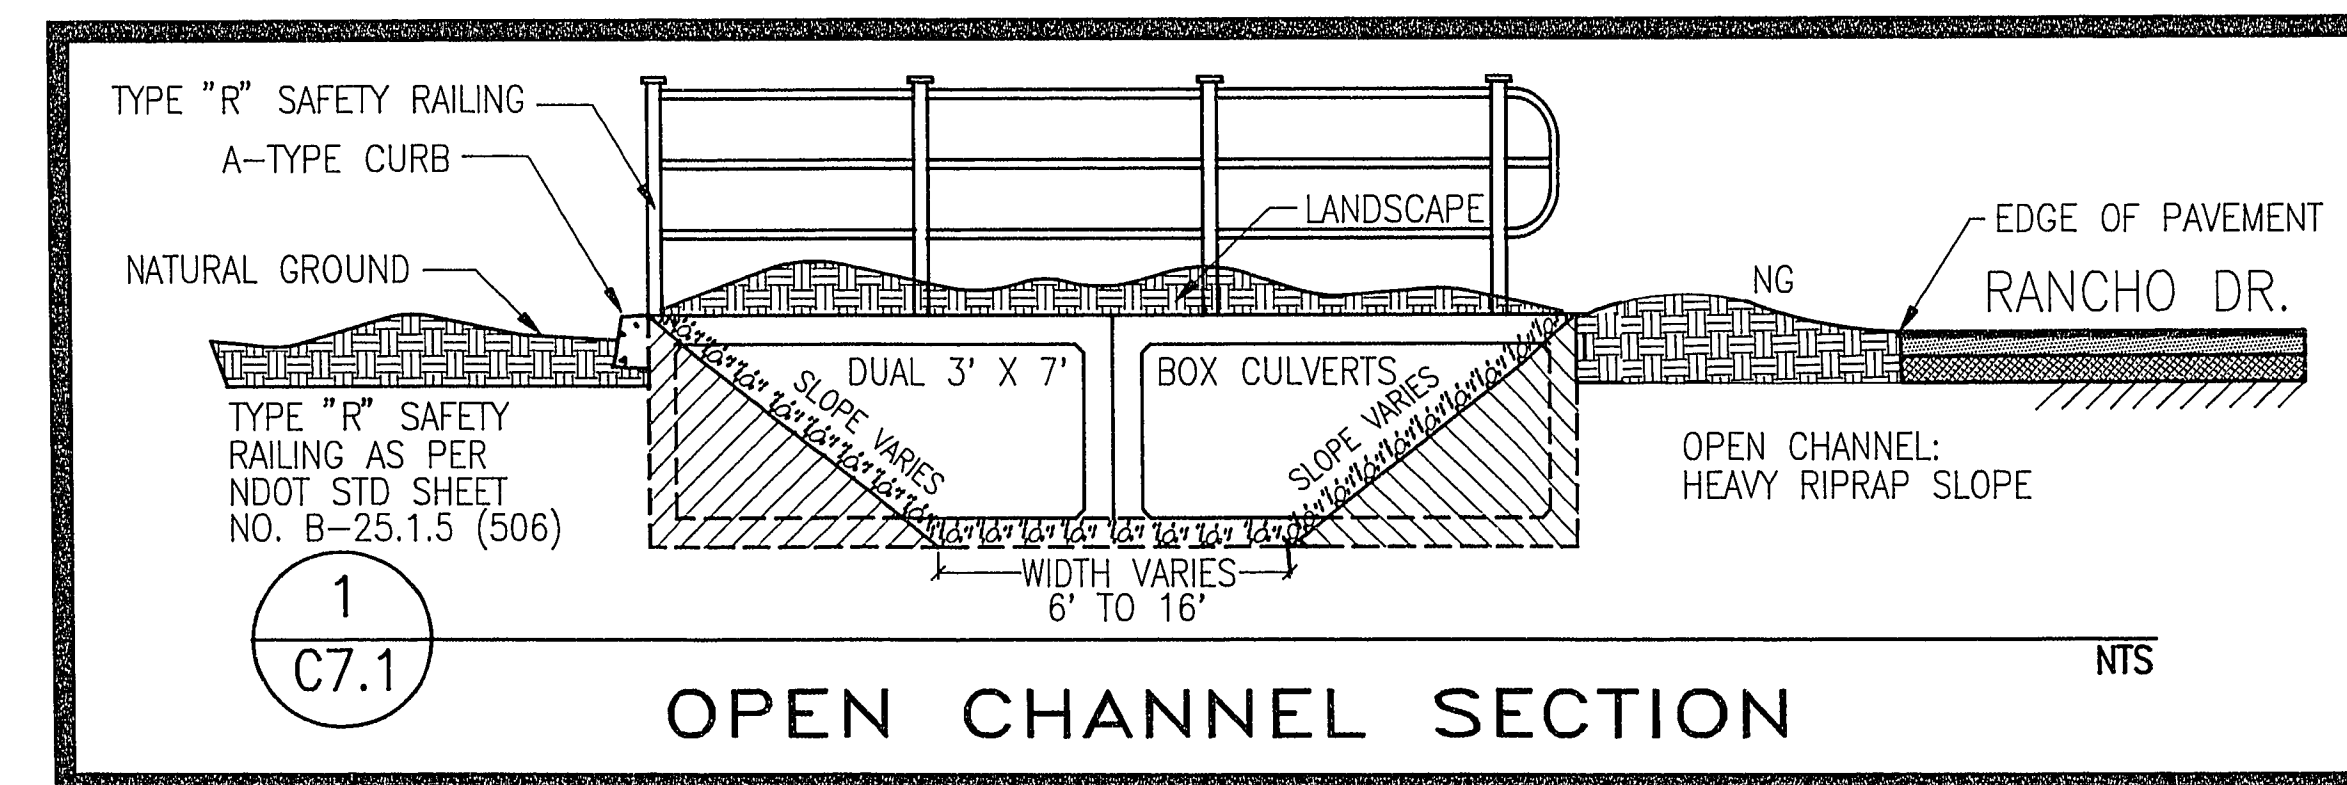


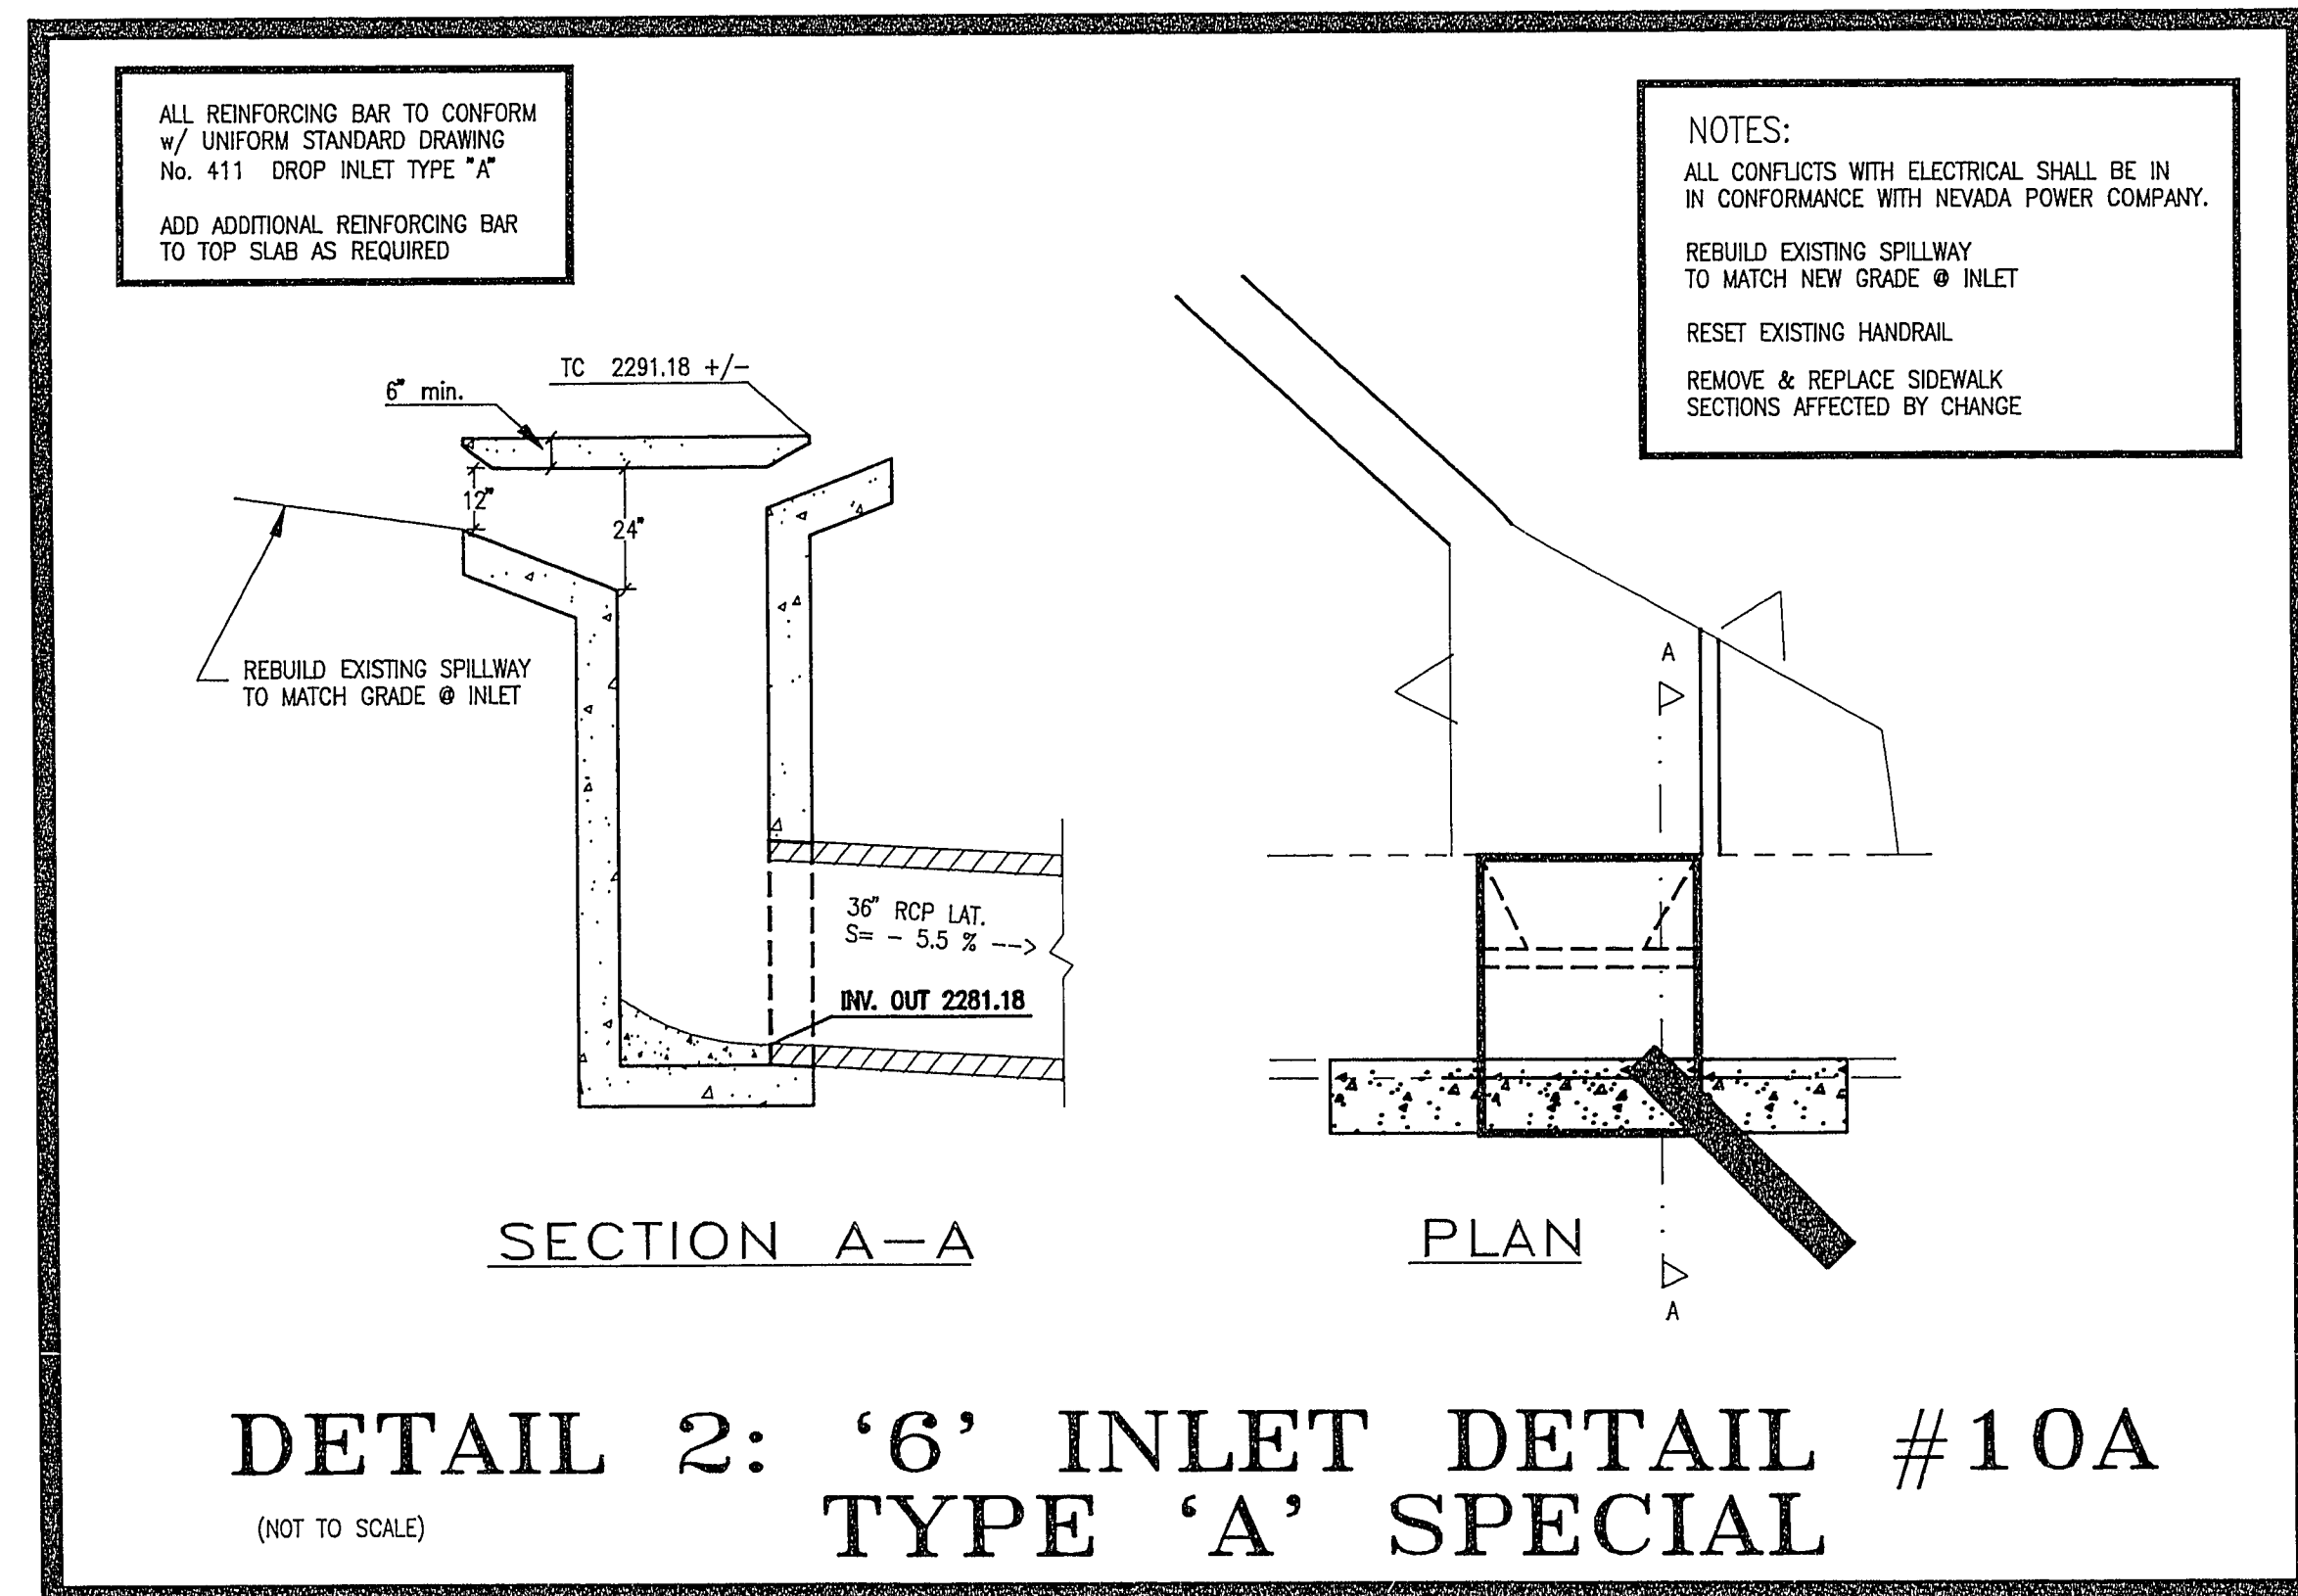

REVISIONS PERFORMED TO EXISTING DRAWINGS BY THE CITY OF LAS VEGAS ENGINEERING DIVISION
ORIGINAL HEFNER ENGINEERING DESIGN DRAWINGS ON FILE AT THE CITY OF LAS VEGAS

REVISION	DATE
CITY OF LAS VEGAS ENGINEERING DESIGN	9/92
DRAINAGE DESIGN REVISED ALONG WITH	
VARIOUS OTHER MINOR REVISIONS	

REVISIONS ONLY

10/14/92

HEFNER ENGINEERING

CIVIL ENGINEERING DESIGN
LAND PLANNING & DEVELOPMENT
4441 South Polaris Avenue, Las Vegas, Nevada 89103
Phone: (702) 798-1900

CRAIG ROAD

DETAIL SHEET

SHEET NO.

C7.1

107-V1804
788042R1 DATE: 11/07/91

SHT. 54/66