


NOTE:
ALL WORK TO MEET NDOT B-20.1.2
FOR WALLS & REINFORCING

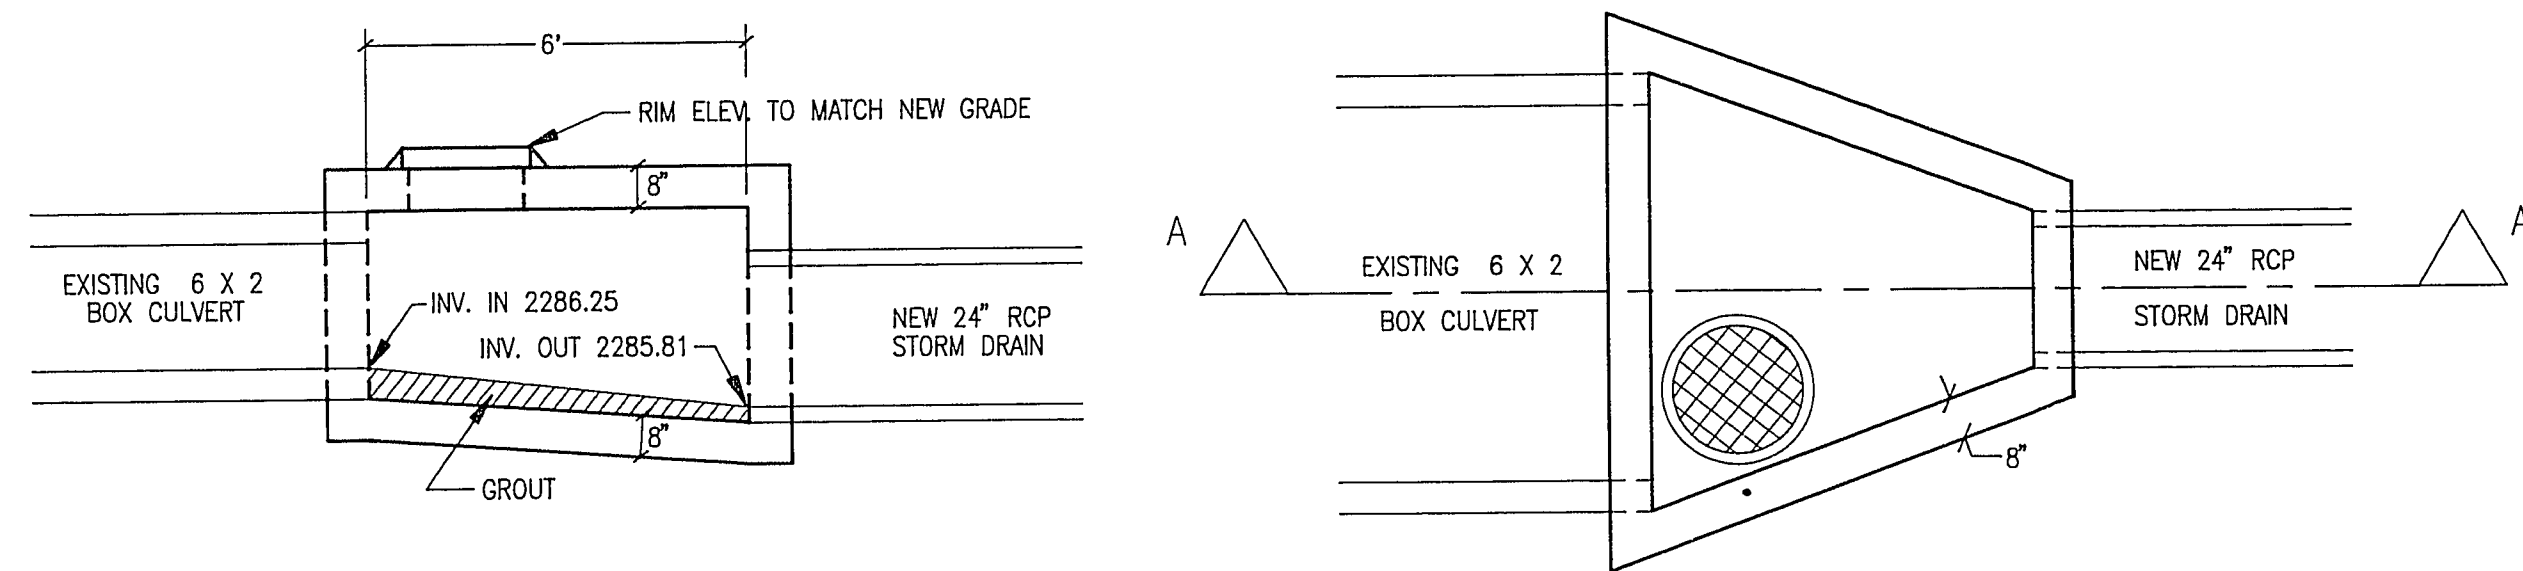


SECTION A-A

PLAN

DETAIL 2: JUNCTION BOX
(NOT TO SCALE)
6 X 2 BOX CULVERT TO 24" RCP


NOTE:
GABIONS TO BE LETTER CODE "C"
L= 12', W= 3', H= 3', 4 CY, BLACK
AS MANUFACTURED BY MACCAFERRI
GABIONS, Inc., OR EQUAL.
TO MEET ALL MANUFACTURERS SPECIFICATIONS FOR
INSTALLATION, OR AS APPROVED BY THE ENGINEER

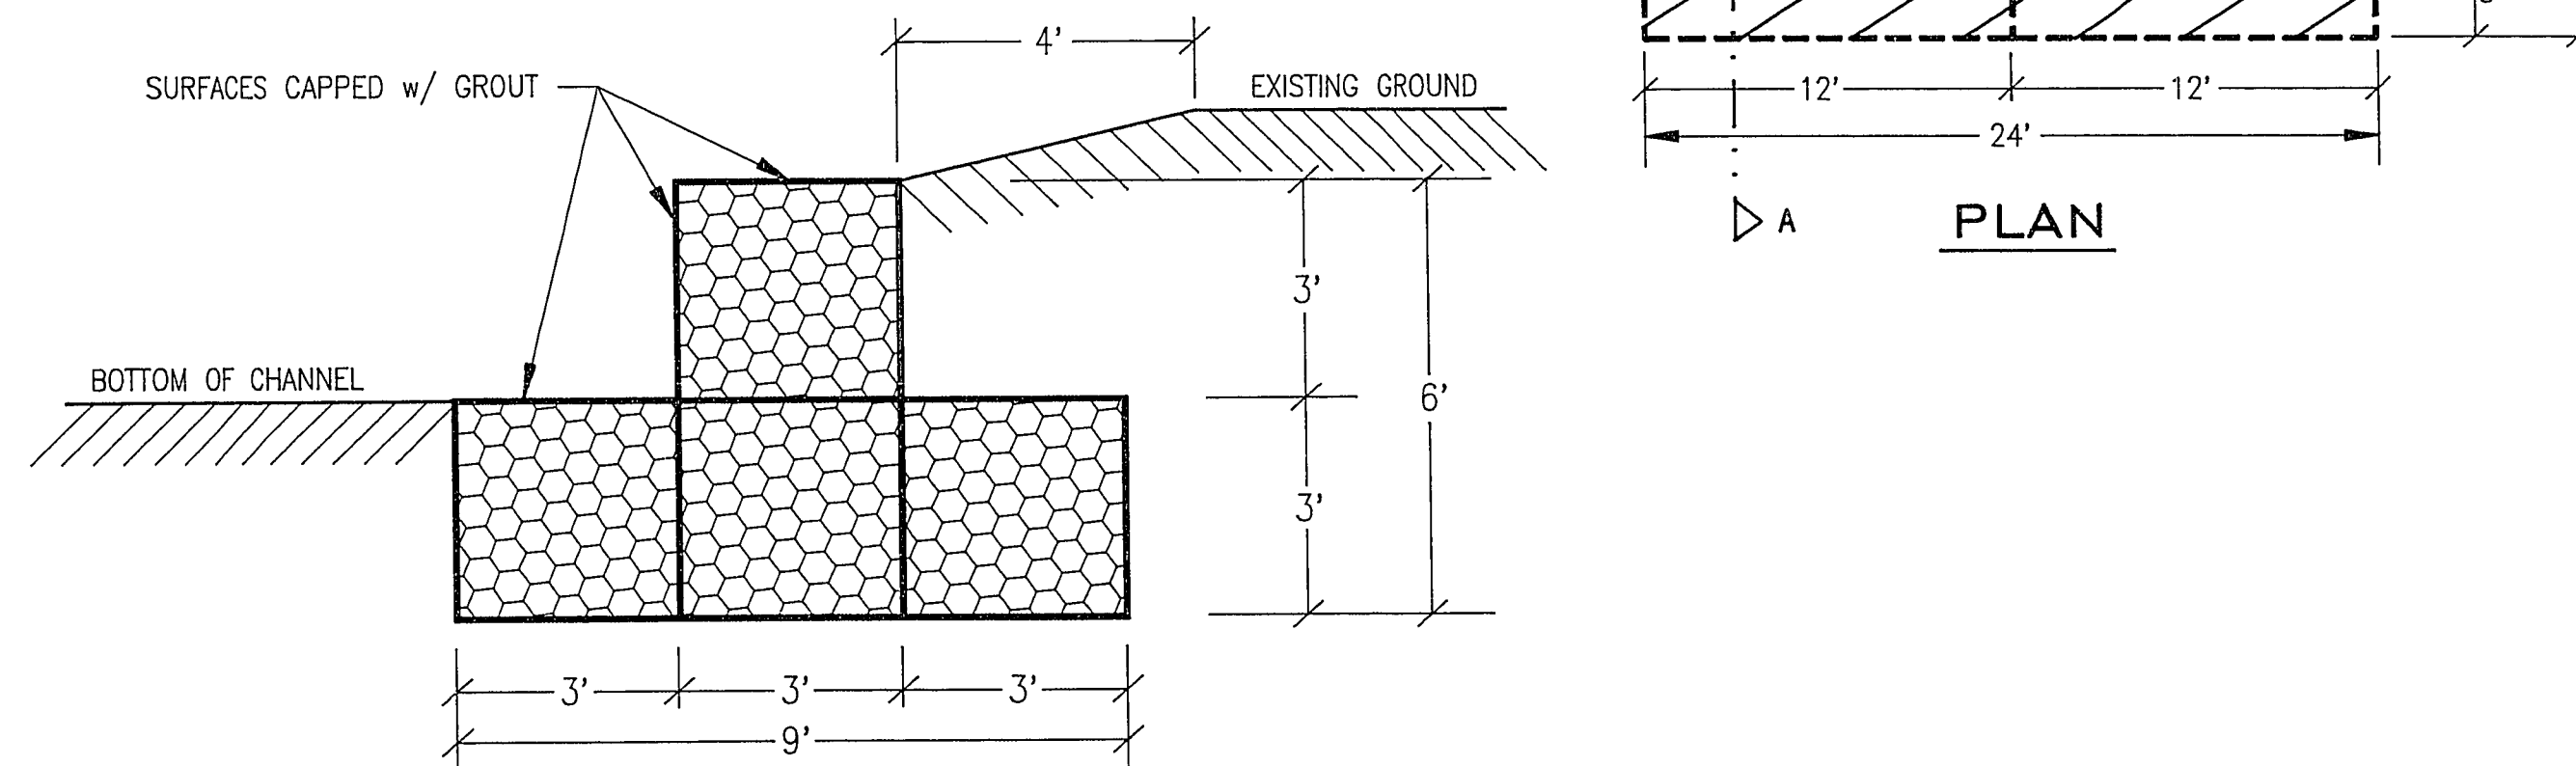

SECTION A-A


PLAN

DETAIL 3: GABIONS
(NOT TO SCALE)

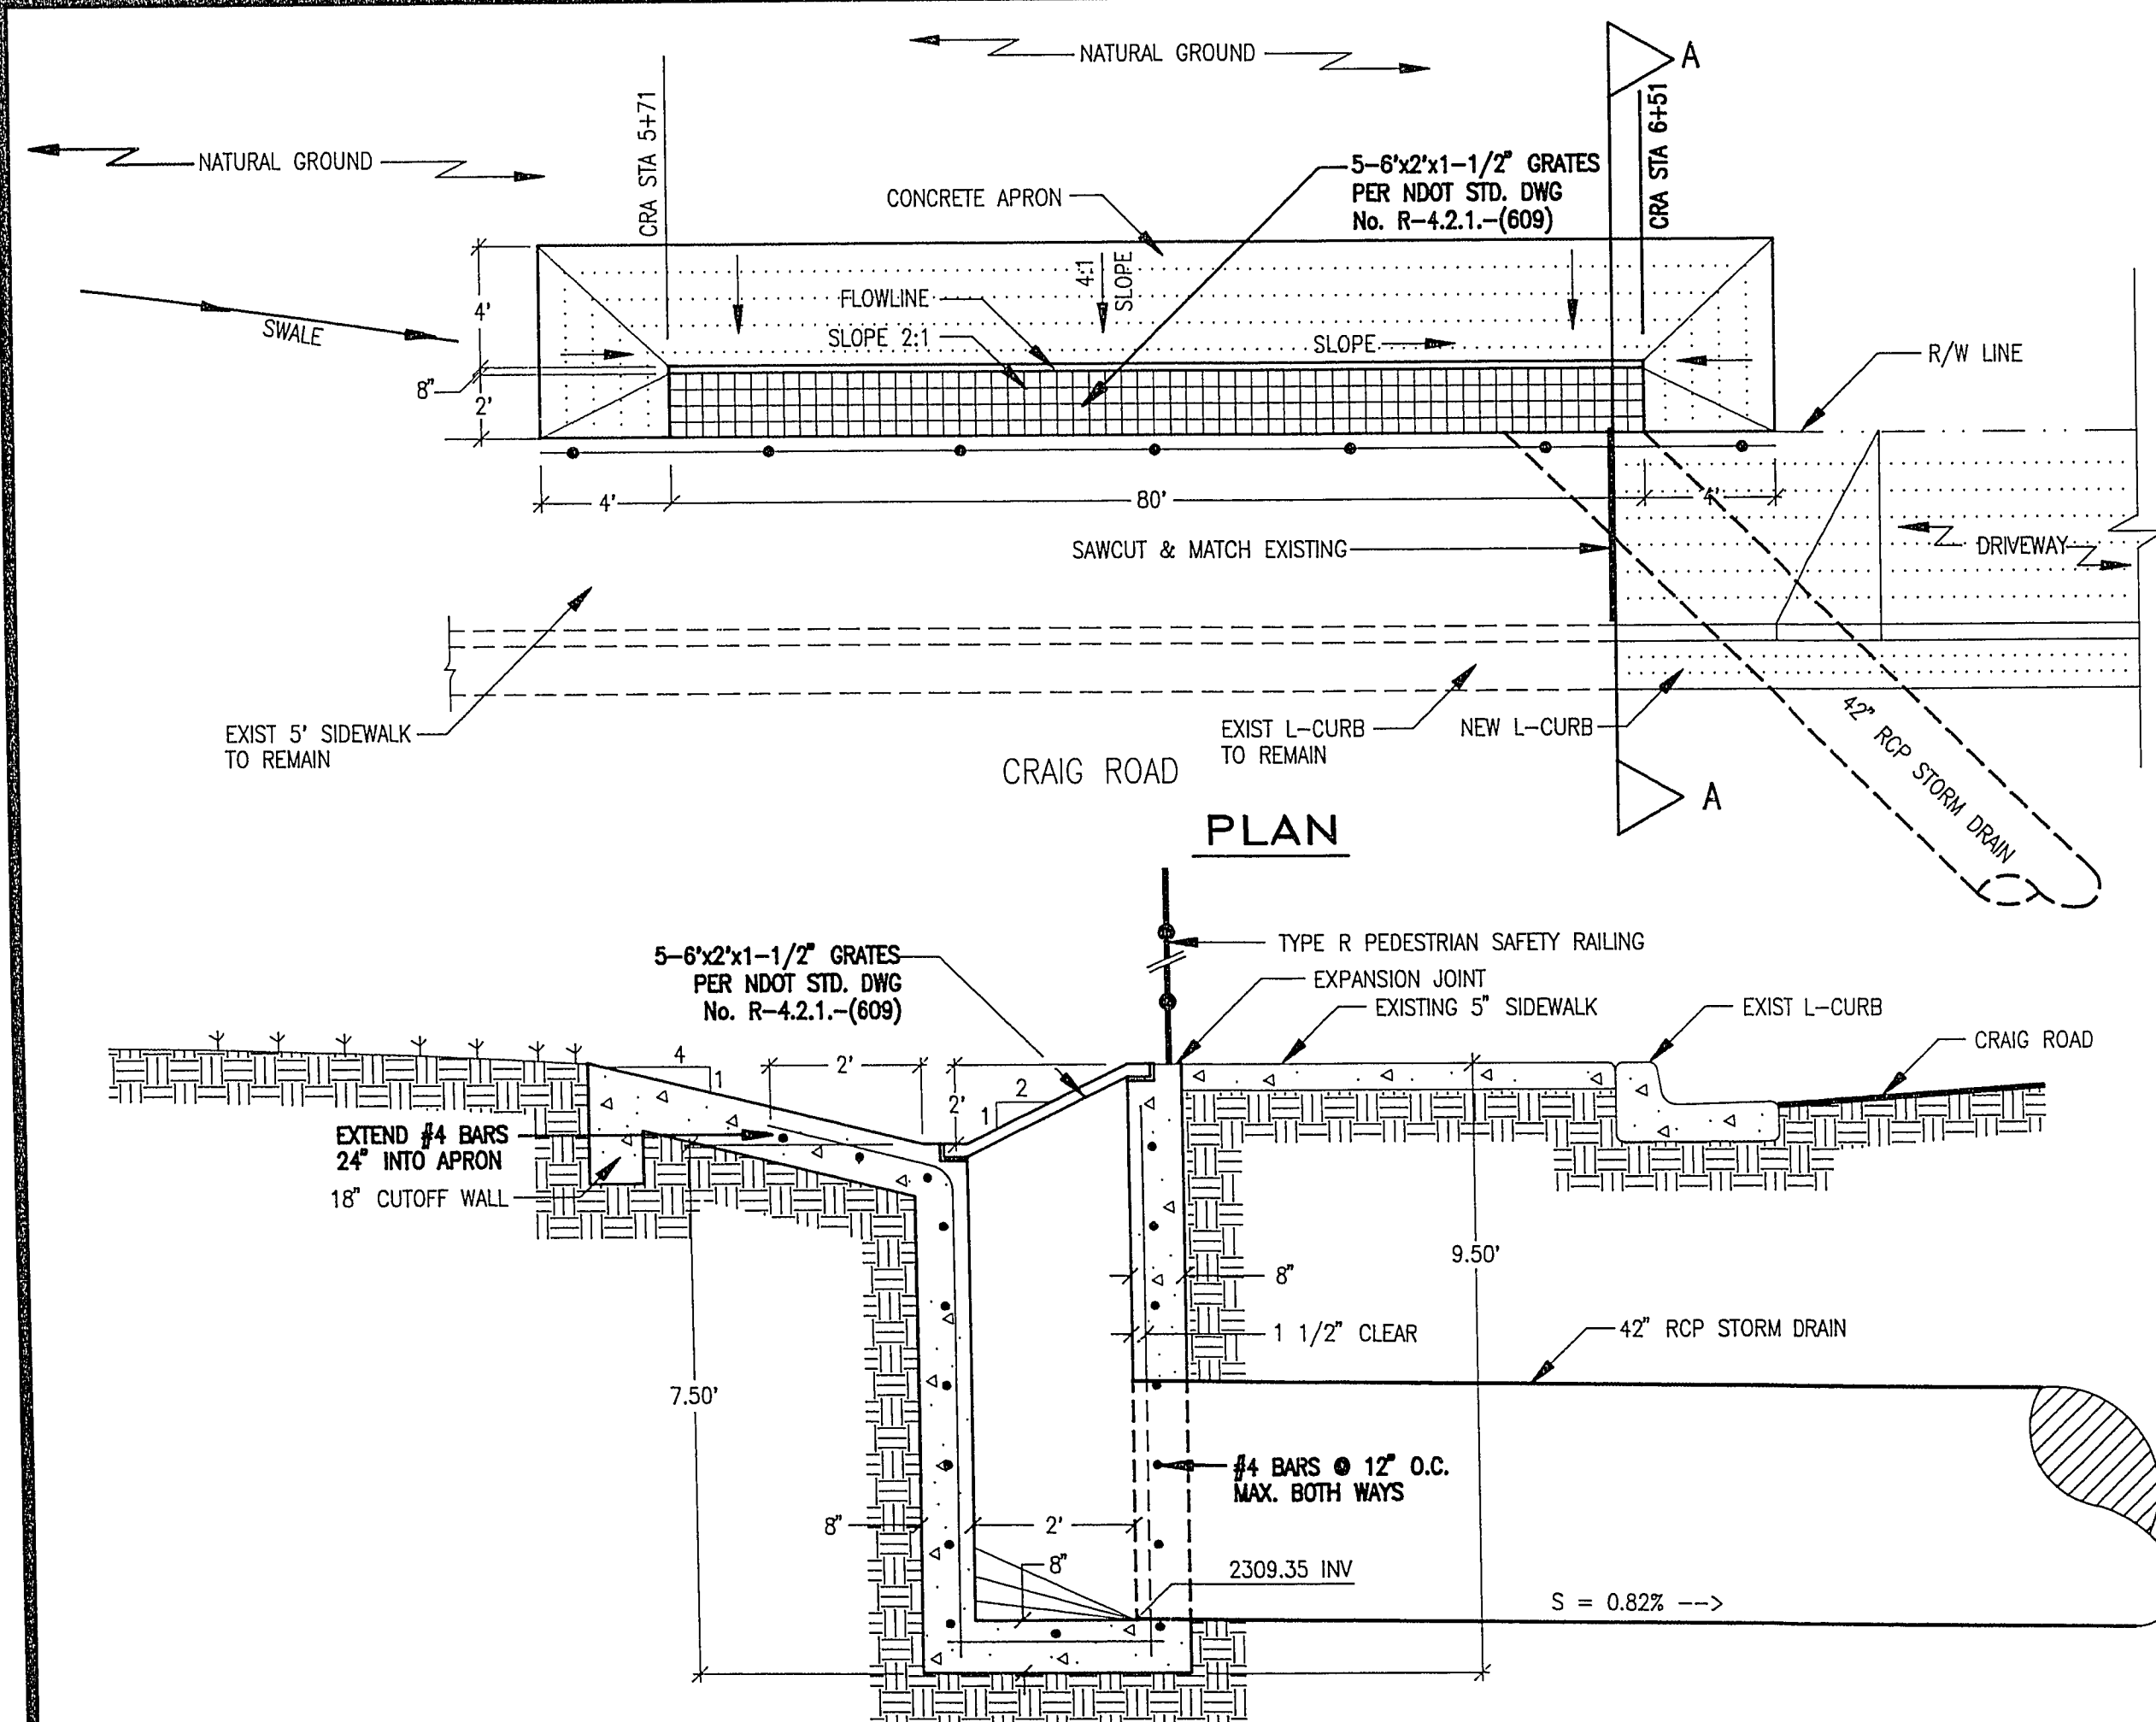

SECTION A - A

DETAIL 4 : 80' DROP INLET
(NOT TO SCALE)

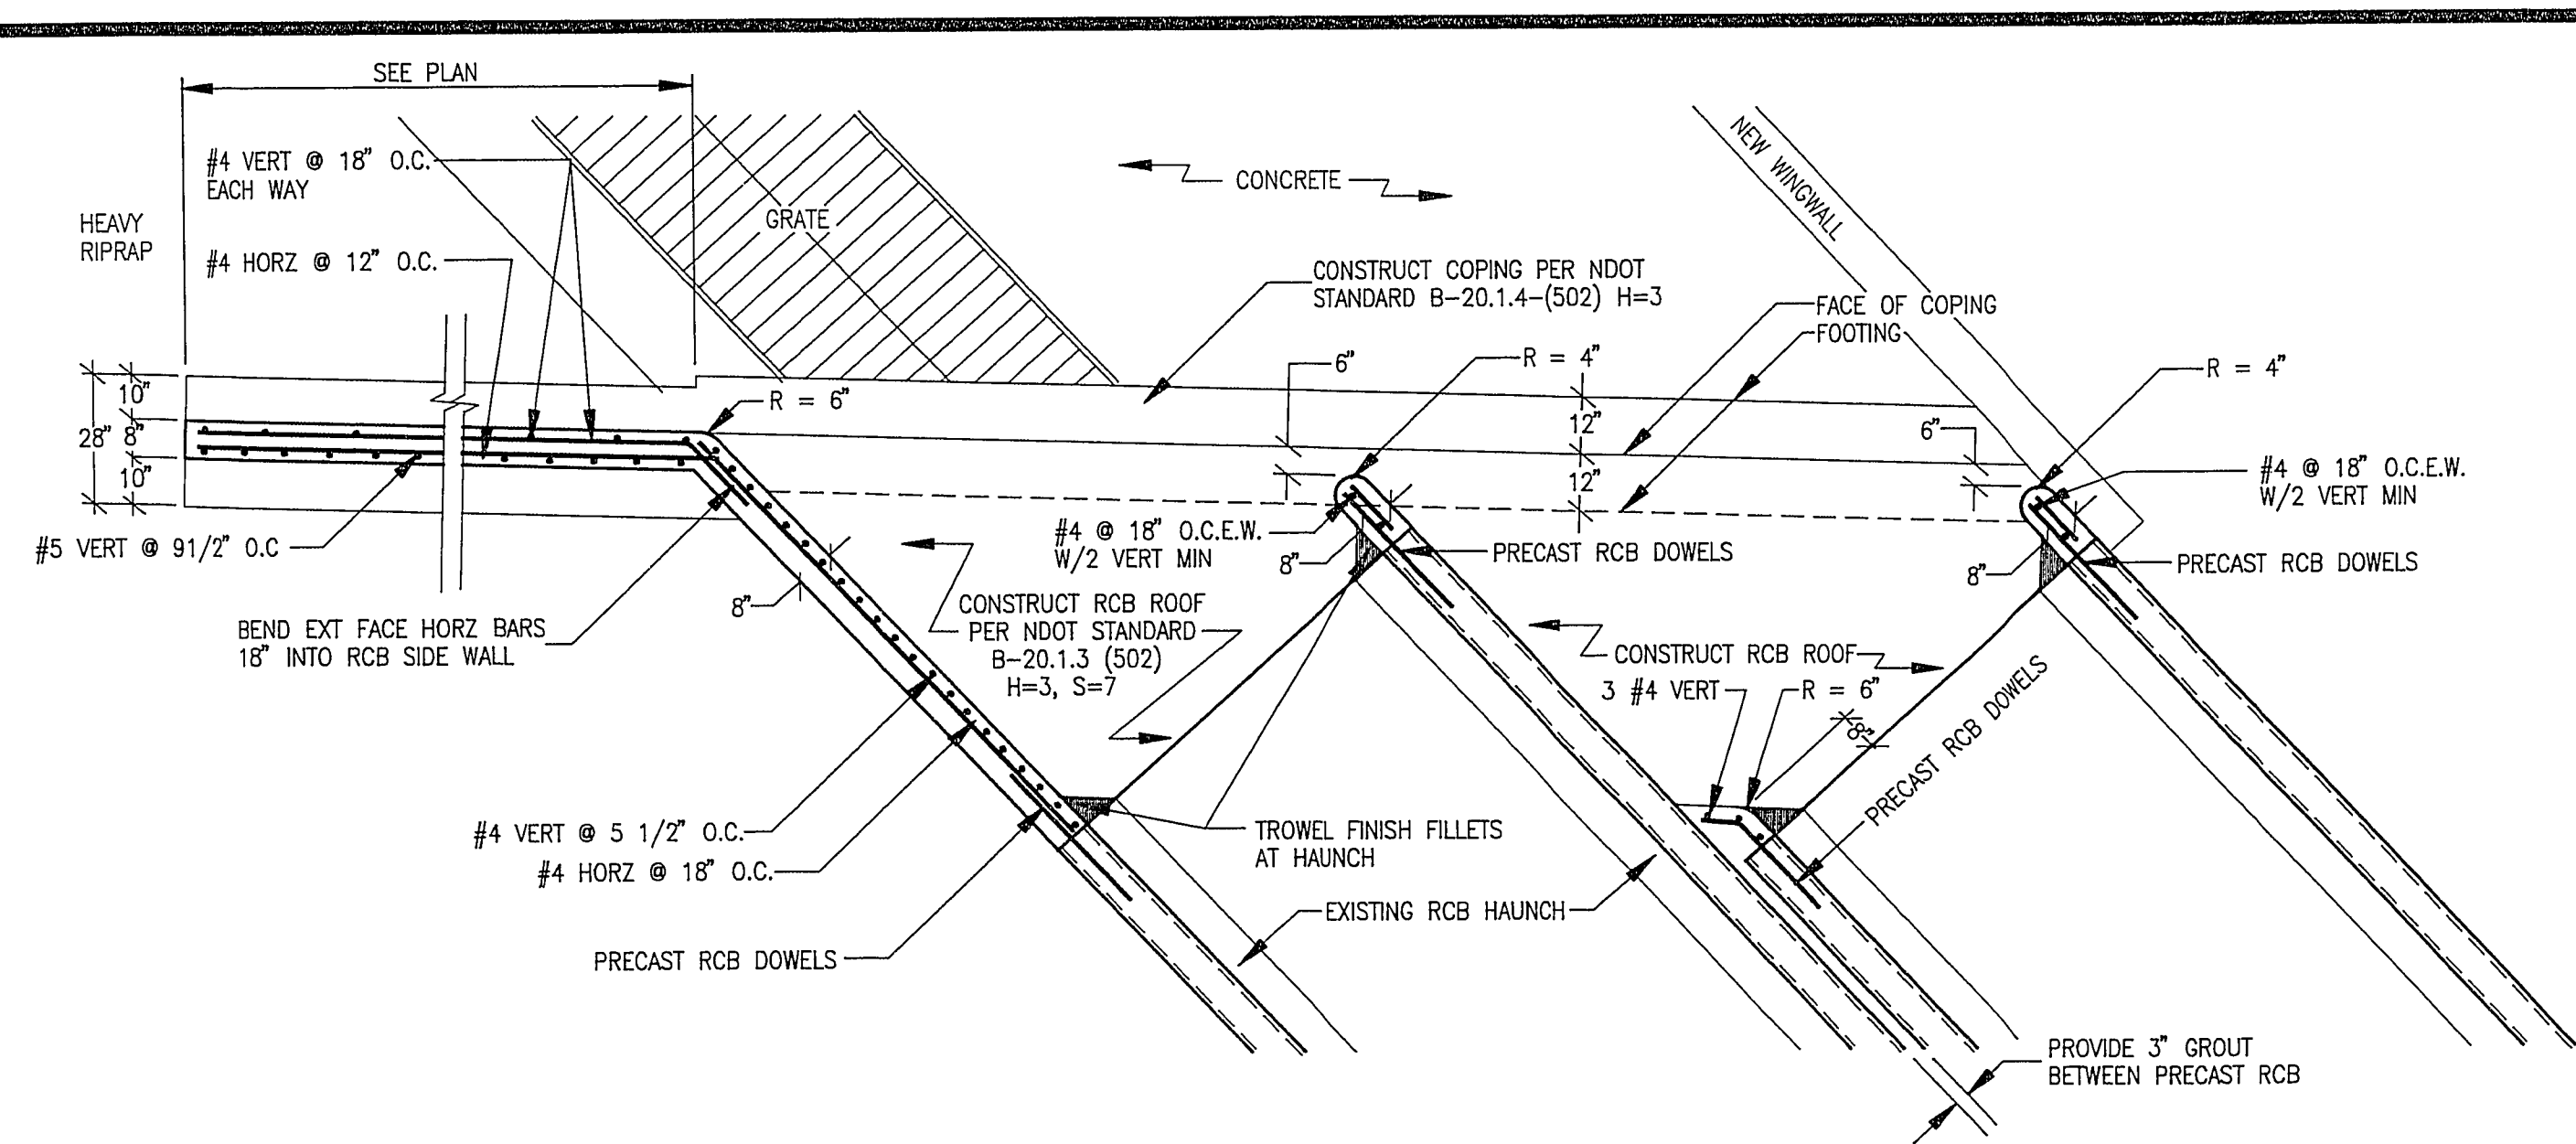

DETAIL 1: BOX CULVERT INLET SECTION
(NOT TO SCALE)

REVISION	CITY OF LAS VEGAS ENGINEERING DESIGN
DATE	9/92
REVISIONS ONLY	DRAINAGE DESIGN REVISED ALONG WITH VARIOUS OTHER MINOR REVISIONS

HEFNER ENGINEERING
DESIGN
CIVIL ENGINEERING & SURVEYING
LAND PLANNING & DEVELOPMENT
4441 South Pecos Road, Suite 100
Las Vegas, Nevada 89103
Phone: (702) 798-1900

CRAIG ROAD

DETAIL SHEET

SHEET NO.

C7.2

107-V1804
11/07/91

REVISIONS PERFORMED TO EXISTING DRAWINGS BY THE CITY OF LAS VEGAS ENGINEERING DIVISION
ORIGINAL HEFNER ENGINEERING DESIGN DRAWINGS ON FILE AT THE CITY OF LAS VEGAS