
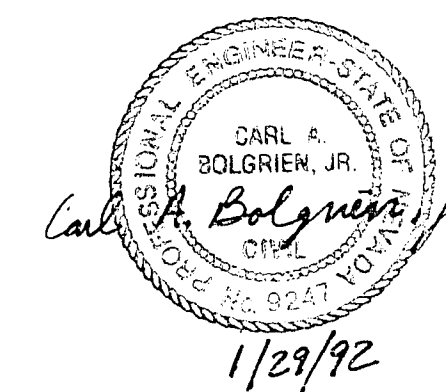
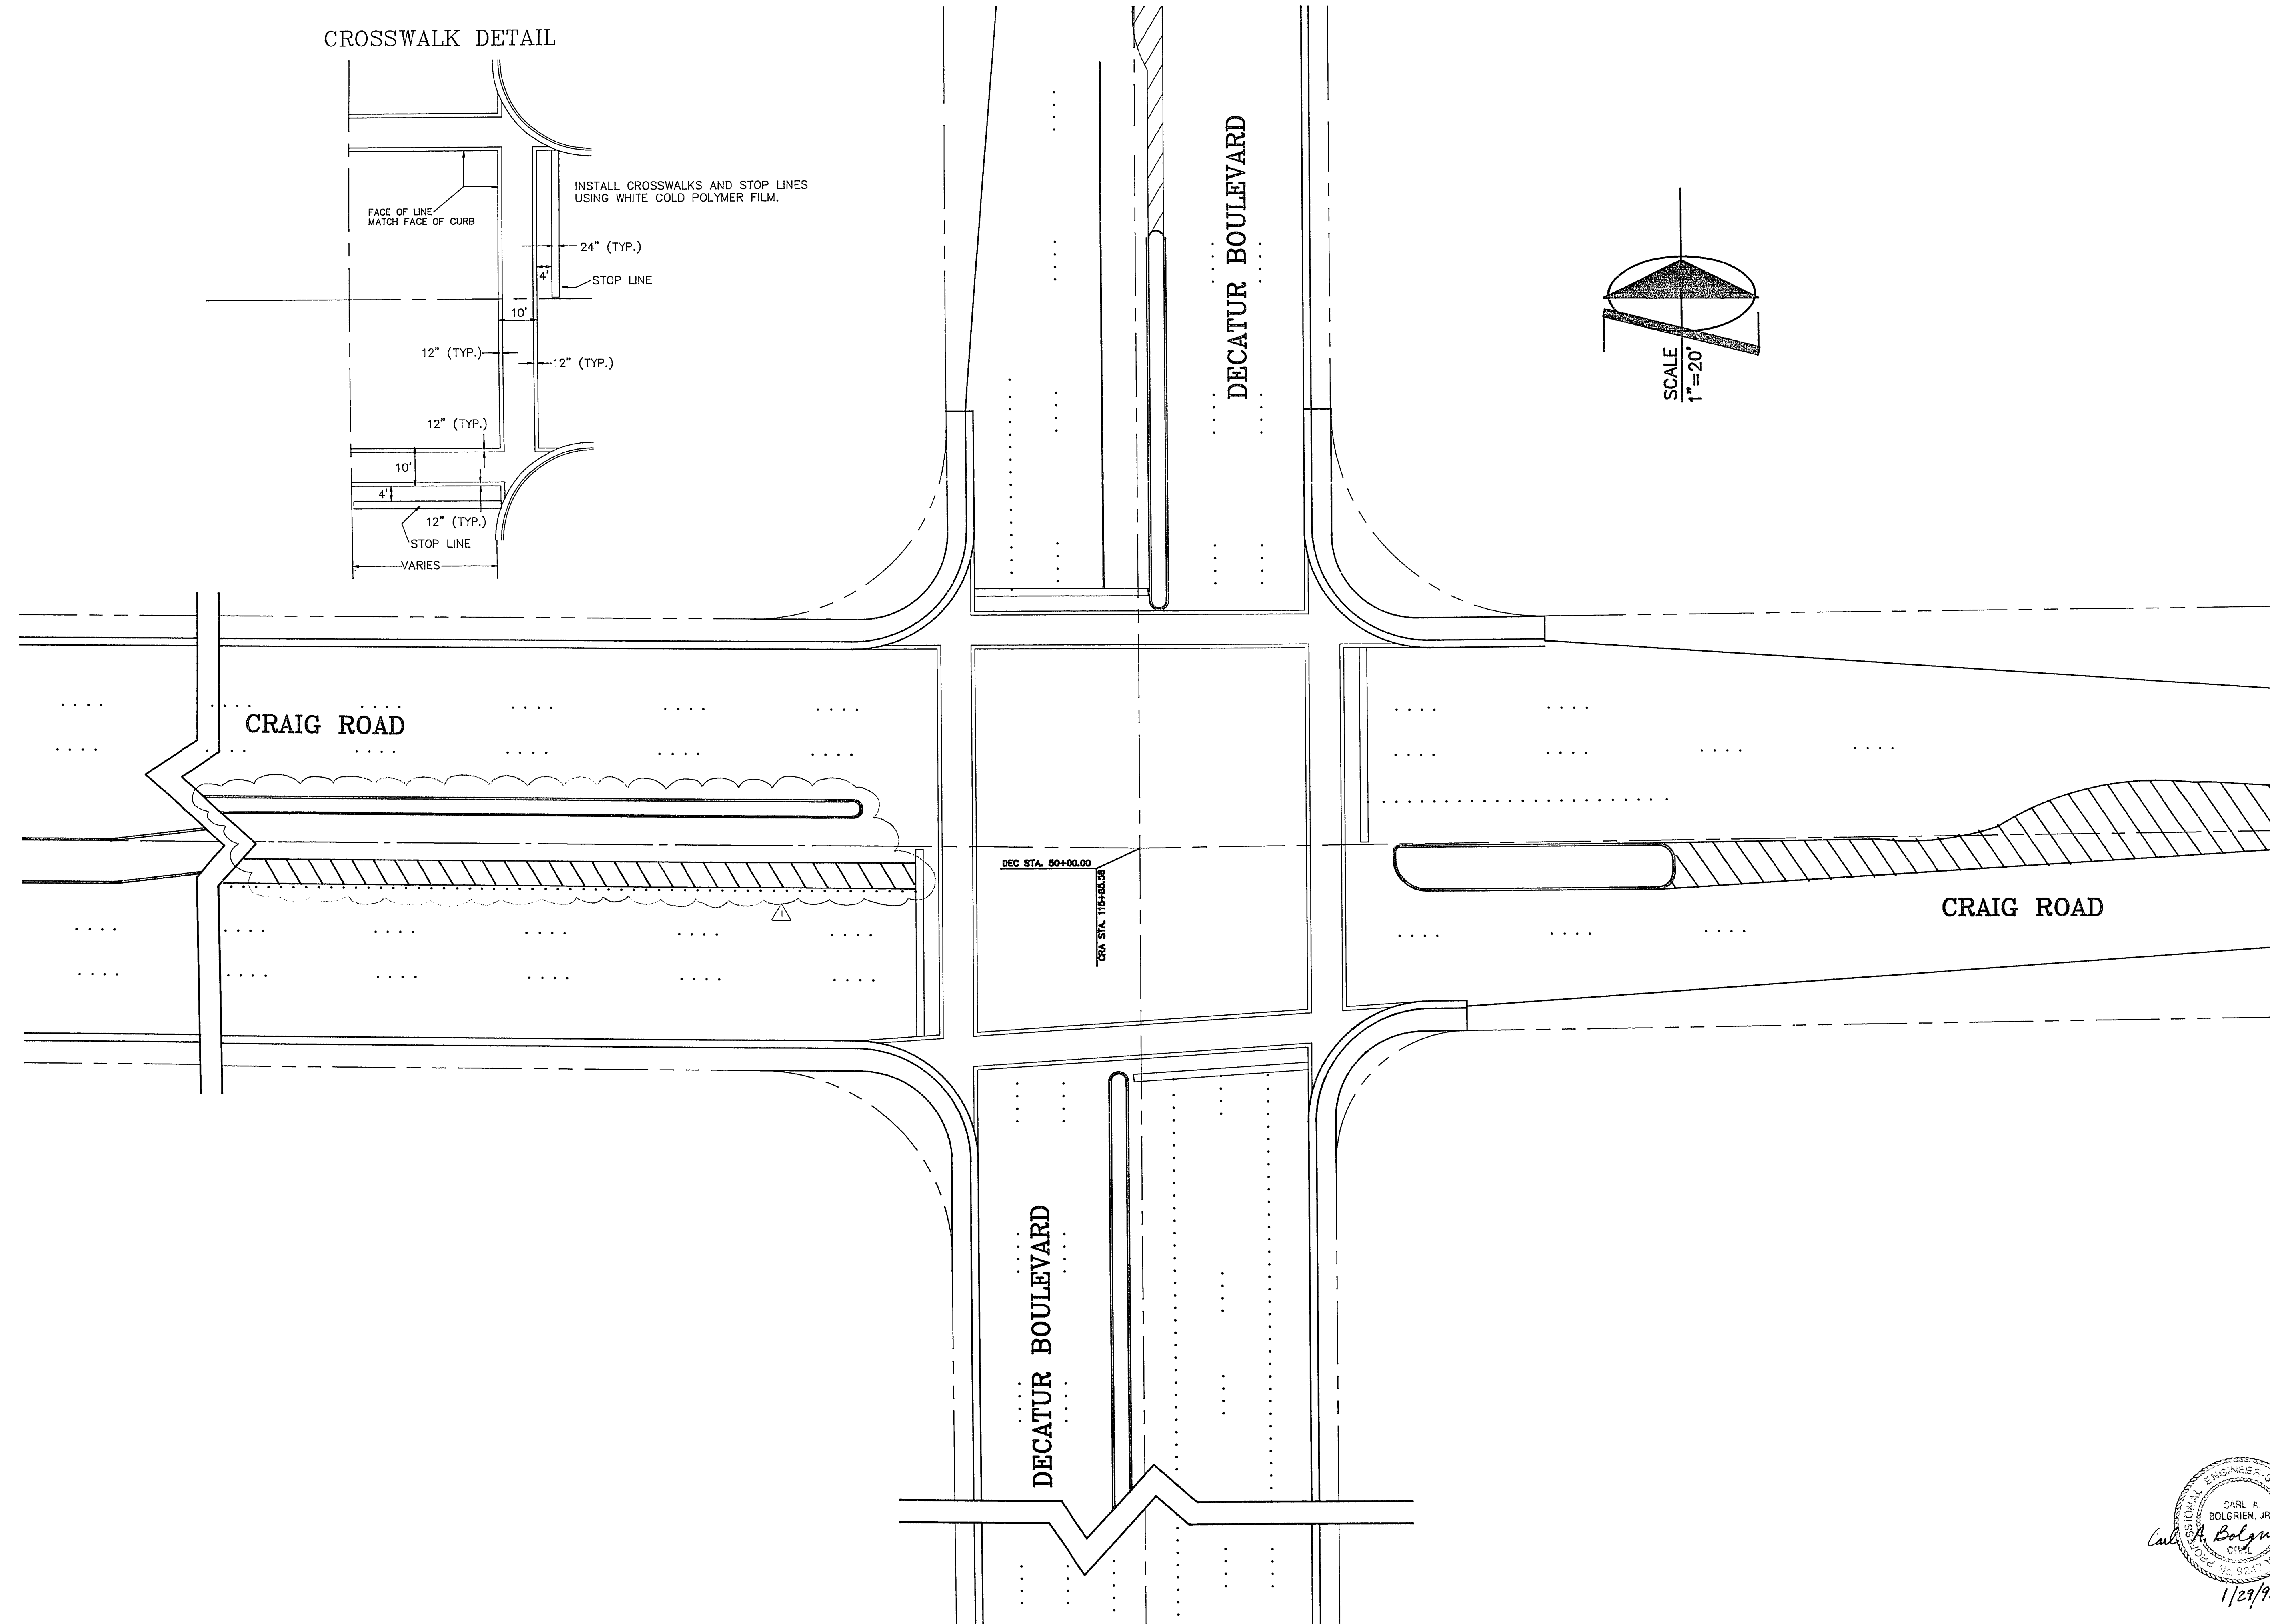
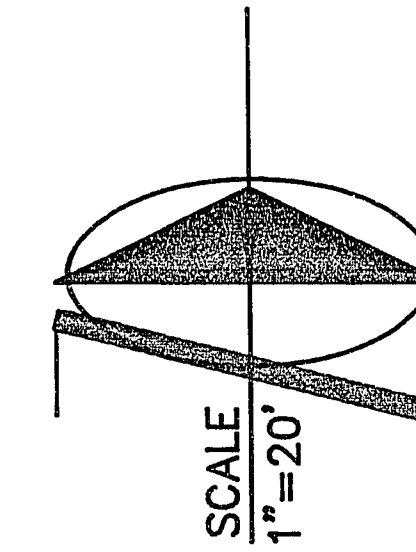


CROSSWALK DETAIL

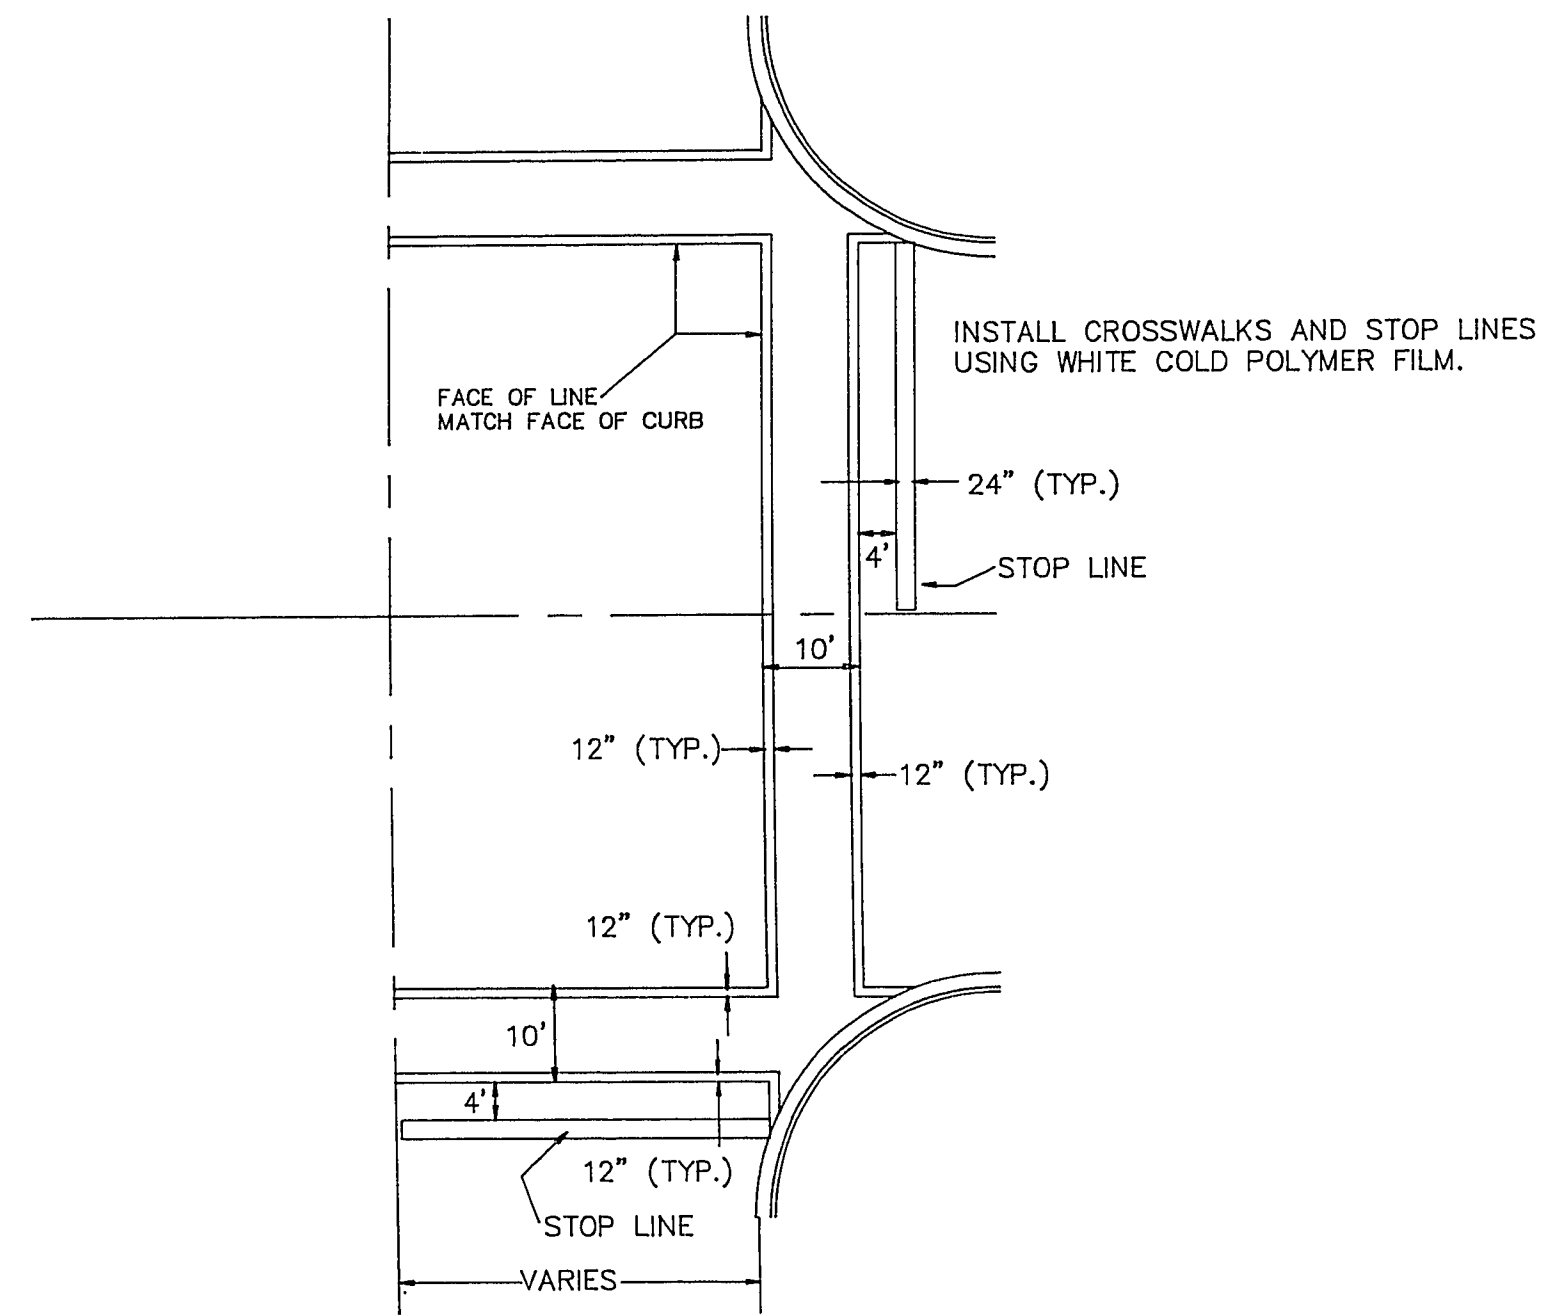

DATE	REVISION
11/19/91	1. AS PER CITY OF LAS VEGAS STANDARD SPECIFICATIONS FOR CONSTRUCTION

HEFFNER ENGINEERING

CIVIL ENGINEERING & DESIGN
1000 SOUTH MAIN STREET
LAS VEGAS, NEVADA 89103
PHONE: (702) 788-1800

CRAIG ROAD
CRAIG ROAD & DECATUR BOULEVARD
CROSSWALKS & STOP LINES

W.O.#:	LOS140
BY:	J.D.T./J.S.T.
DATE:	11/19/91
SCALE:	1" = 20'
SHEET NO.	T-11
107 - V1804	
SHEET 11	OF 11