


2023
2022
2021


PROFILE - FIRST ST.

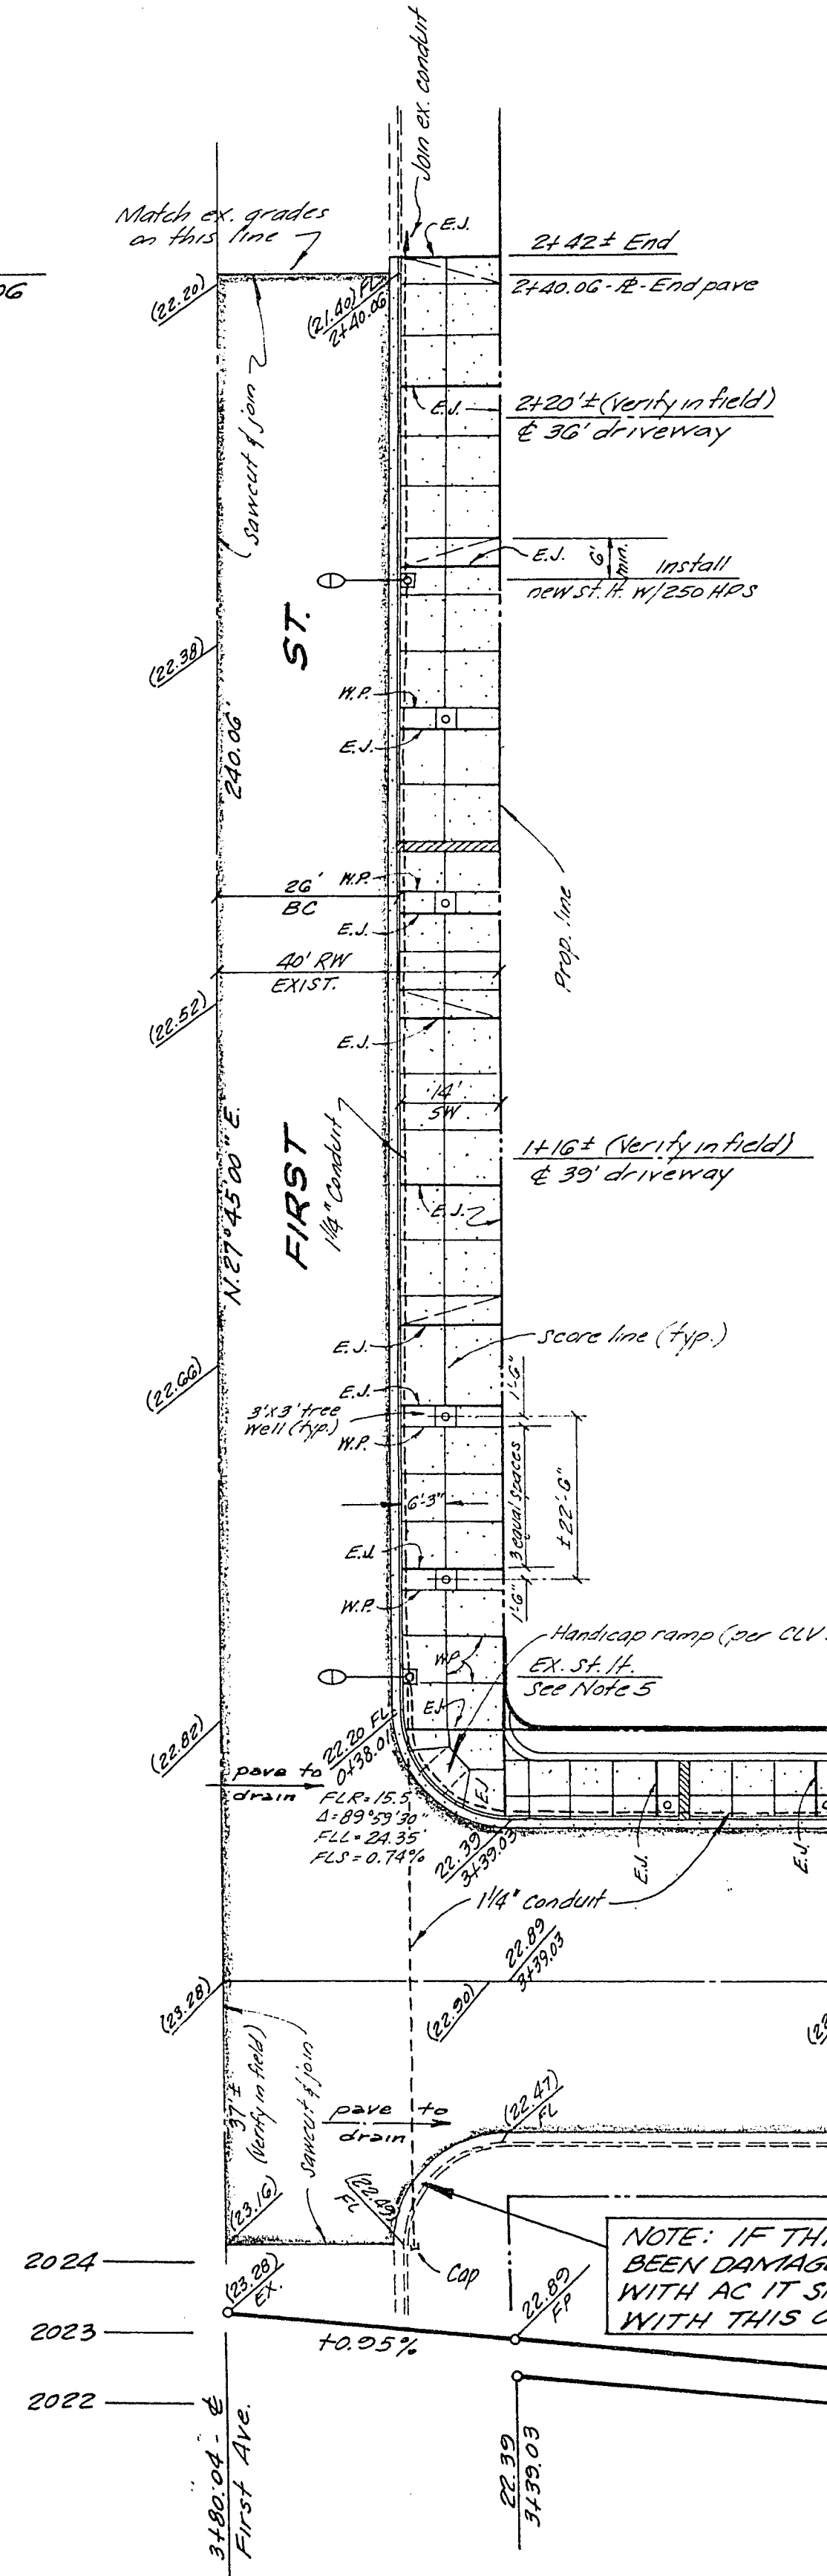

LEGEND & ESTIMATE OF QUANTITIES

- | | |
|-------------------------------------|---|
| St. H. relocation | 1 each |
| Sidewalk drain | 8 each |
| Tree well | 21 each |
| Curb & gutter | 747 l.f. (Per C.L.V. Standard) |
| Conc. sidewalk (in street R/W only) | 7040 s.f. (includes 1424 s.f. of commercial driveway) |
| Sawcut pave | 661 l.f. |
| 3" AC pave (in gravel) | 3152 s.y. |
| E.J. = Expansion joint | L.S. (Note: Do not extend expansion joints thru curb) |
| W.P. = Weakened plane joint | L.S. (Note: Make joints 1" in depth - See Dwg. 107-V-235) |
| Install new street light | 1 each (includes 250 WHPs head) |
| New 250 WHPs heads | 5 each |
| 1 1/4" conduit | 1074 l.f. |
| Existing elevation | |

BENCH MARK: CLV BM 0613484 at N.E. corner of Lewis Ave. & Casino Center Ave. - Elevation = 2019.611

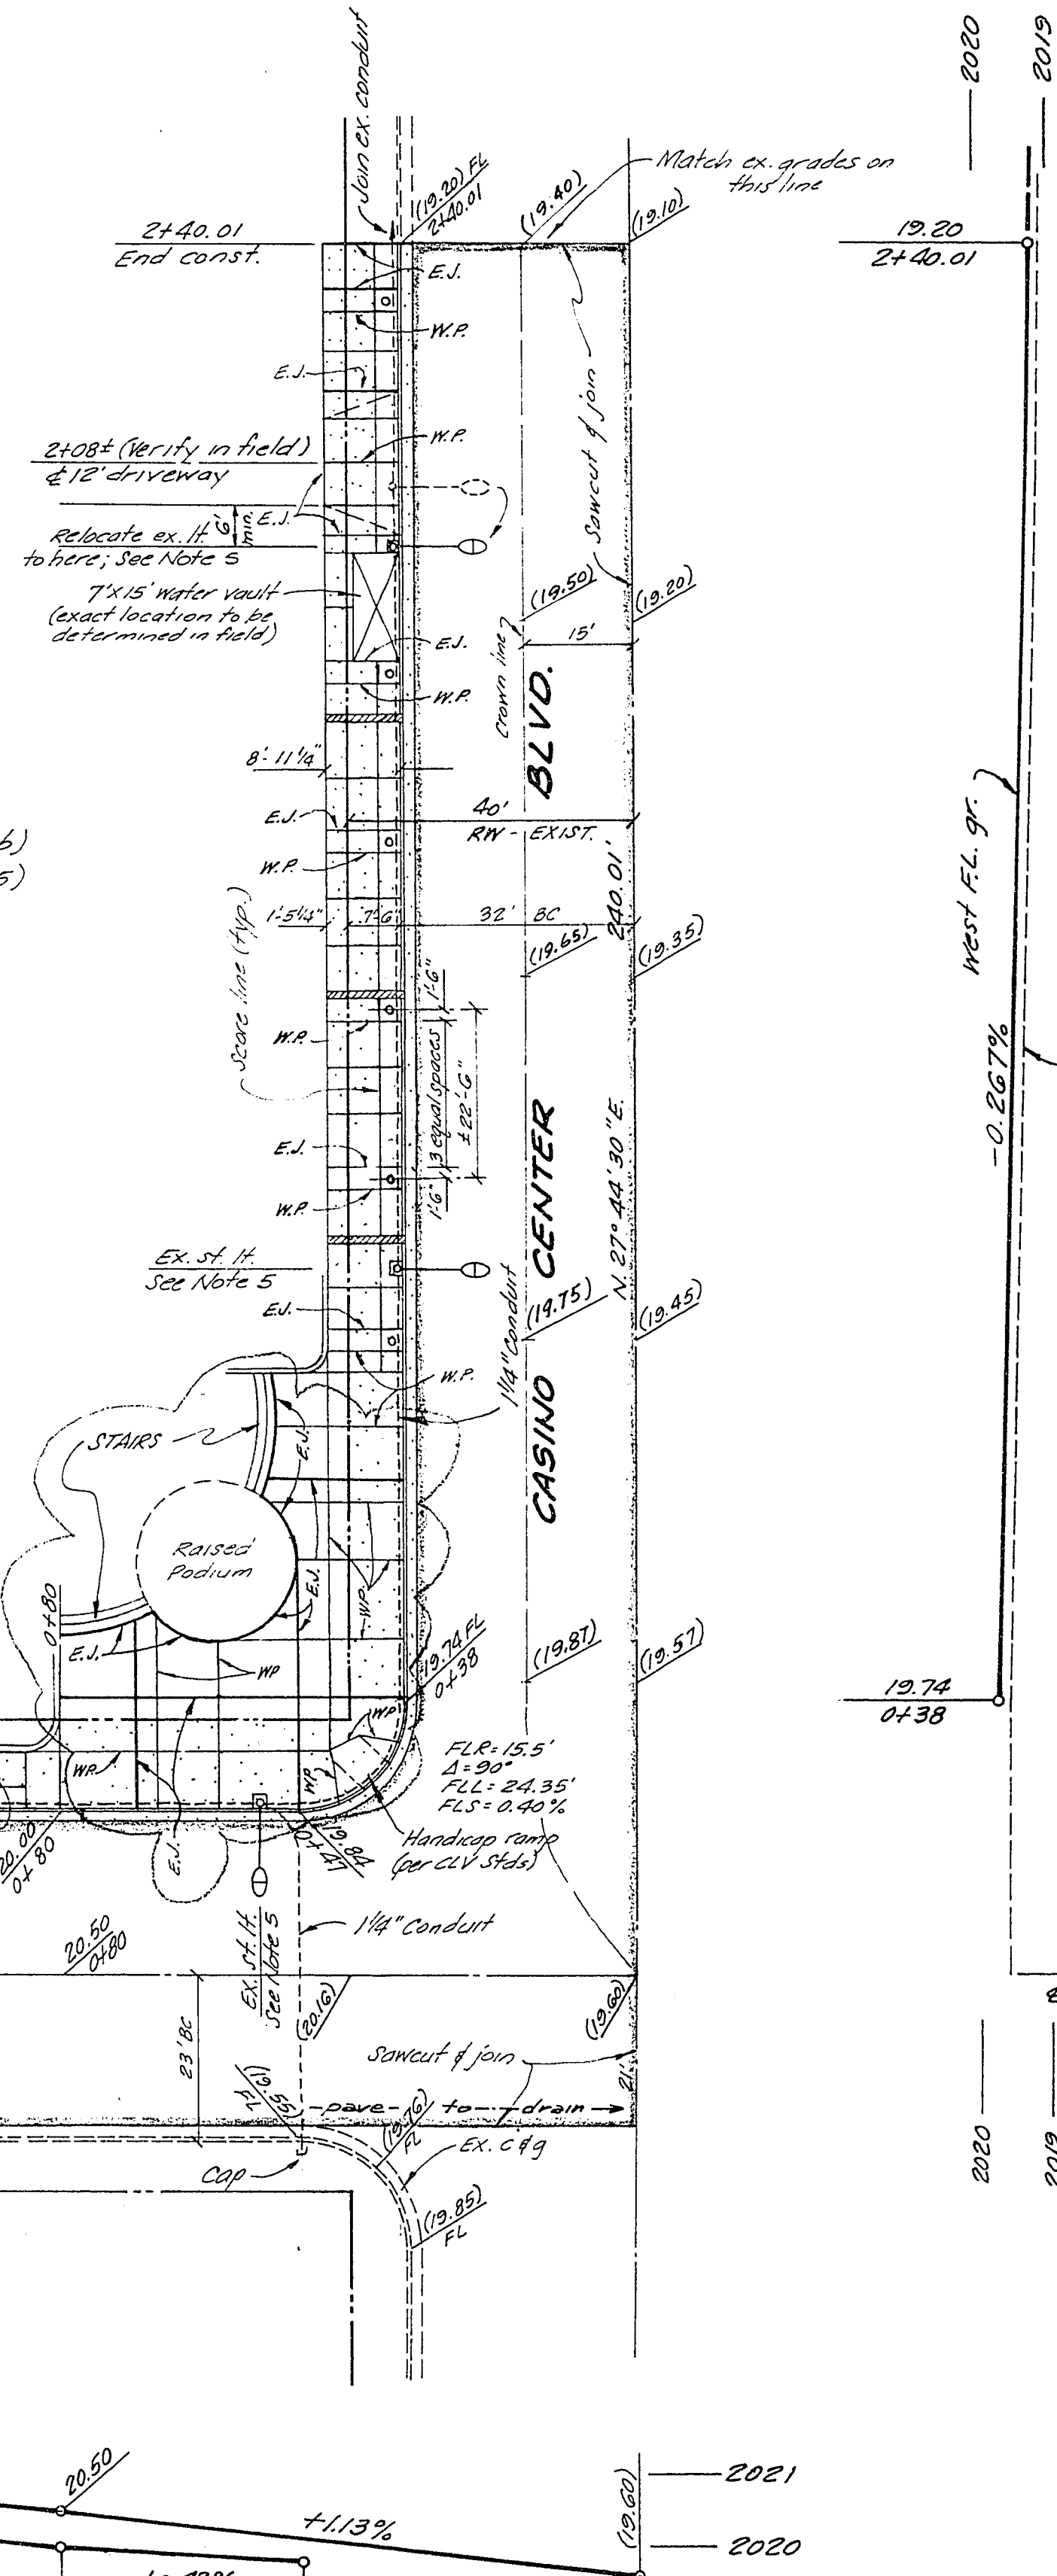

PROFILE - CASINO CENTER BLVD.

PROFILE - LEWIS AVE.


NOTE: IF THIS CURB RETURN HAS BEEN DAMAGED DUE TO COVERING WITH AC IT SHALL BE REPLACED WITH THIS CONTRACT.

GENERAL NOTES:

- All constr. & materials shall be in accordance with the "Uniform Std. Specs. for Public Works Construction Off-Site Improvements Clark County Area Nevada" issued 1978; the "Uniform Std. Dwg. for Public Works Construction, City of Las Vegas; any other applicable approved stds. issued by the controlling agency, the Uniform Bldg. Code, and all local city codes & ordinances applicable.
- All construction shall be as shown on these plans, any alterations shall have the prior approval of the City Engineer.
- The Contractor shall provide all necessary horizontal & vertical transitions for proper drainage, extent of transitions shall be as shown or as determined by City Engineer or Inspector.

- Existing 1 1/4" conduit contains 2-#4 wires and 1-#8 wire. Add 3-#12 wires from pedestal on south side of Lewis Ave. thru existing pullbox. Extend 3-#12 wires to closest light standard and install a Honeywell 2 pole lighting contactor, or approved equal, in service pedestal.
- Replace all existing street lights with 250 WHPs heads.
- See Architect's Dwg. LS 1 for Onsite jointing, scoring, etc.

APPROVALS

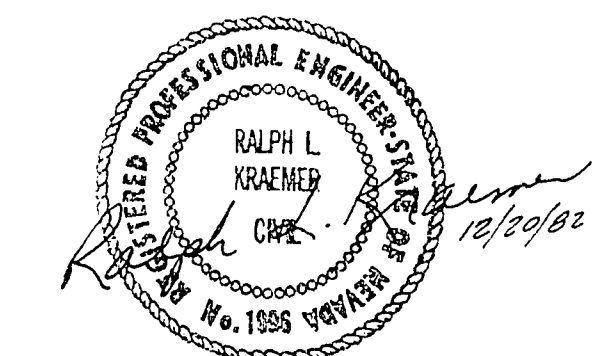

[Signature] 2-2-83
CLV Electric Supervisor Date

[Signature] 2/1/83
CLV Electric Coordinator Date

[Signature] 1-28-83
CLV Traffic Engineer Date

[Signature] 4/6/83
CLV Quality Control Engr. Date


[Signature] 1-27-83
CLV Fire Department Date

[Signature] 2-17-83
CLV City Engineer Date

REVISIONS	BY
11/21/83	RK

OFFSITE IMPROVEMENT DESIGNS
CLARK COUNTY DETENTION CENTER
LAS VEGAS, NEVADA
FIRST & LEWIS

Scale Horiz. - 1" = 20'
Vert. - 1" = 2'
Drawn RK
Job
Sheet 1
Of 2 Sheets

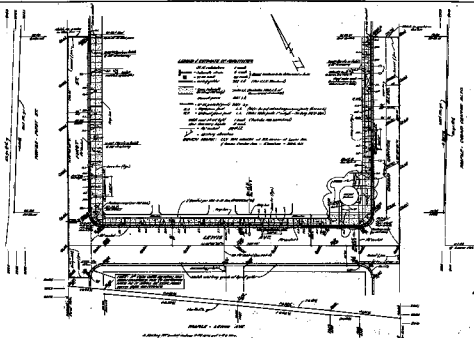[illegible][illegible]

CLARK COUNTY DETENTION CENTER
CLARK COUNTY DETENTION CENTER
CLARK COUNTY DETENTION CENTER

