


22-2-34

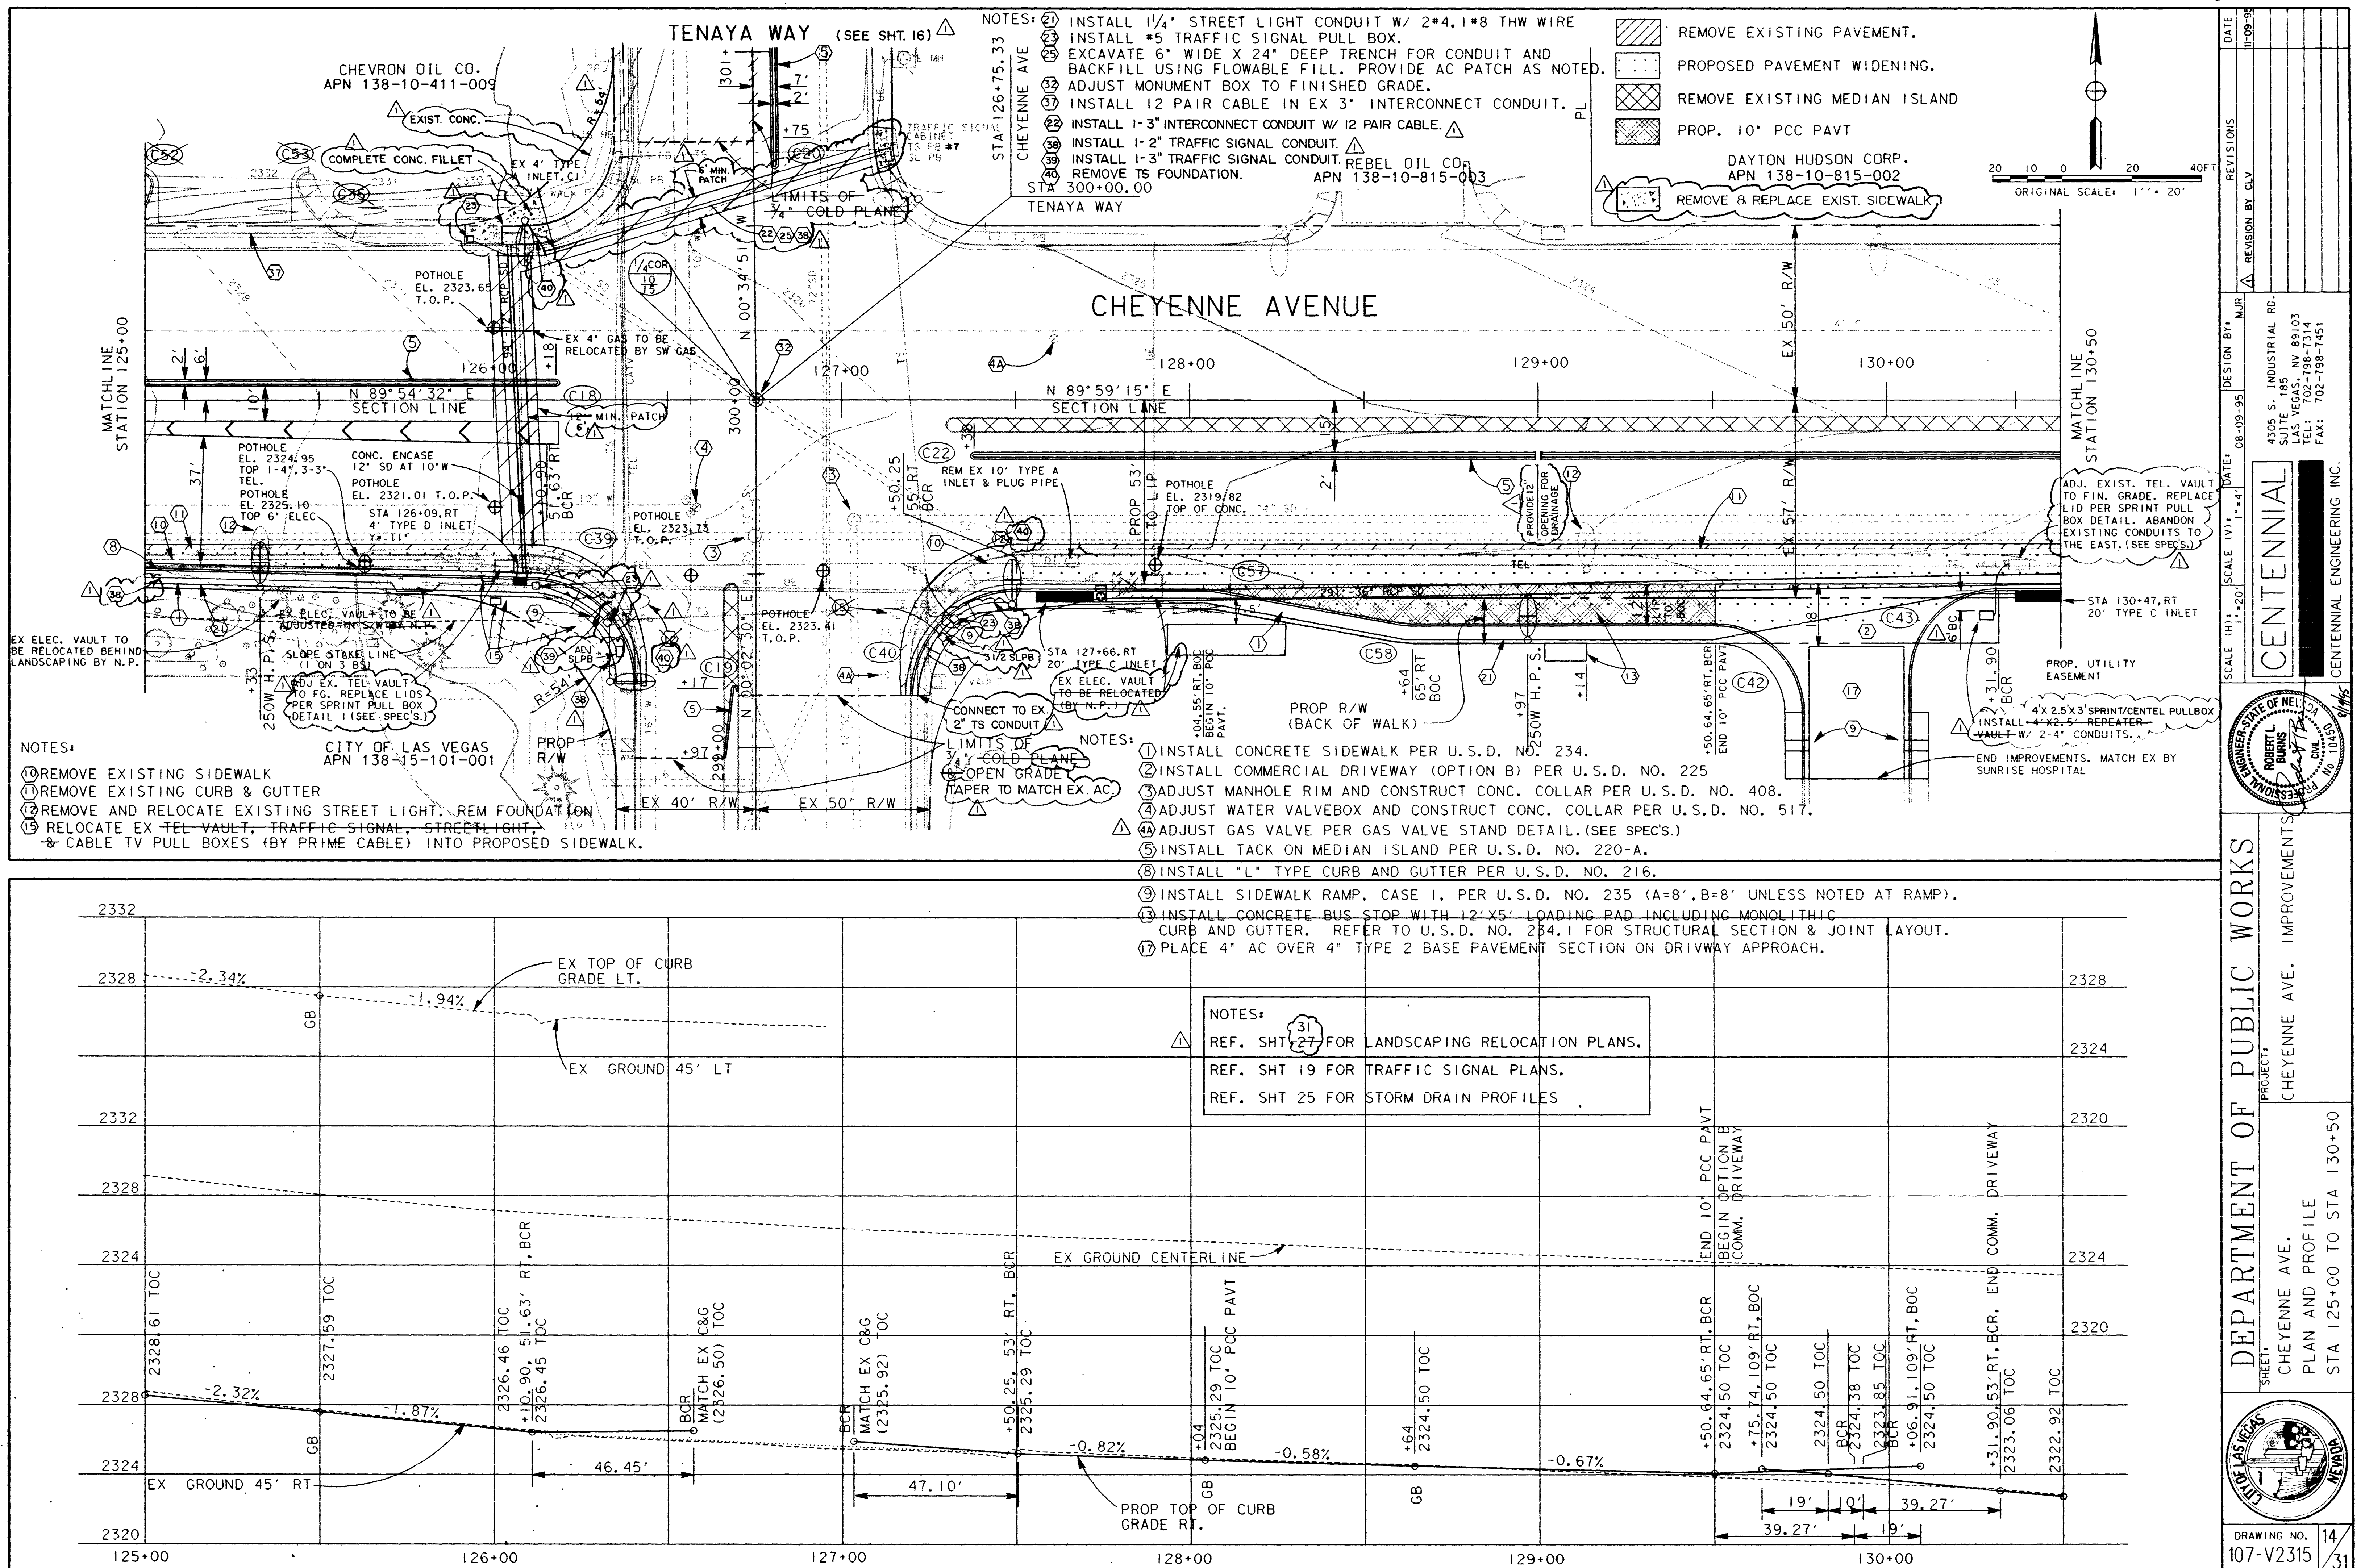

PLAN AND PROFILE

