



NOTE

THE ORIGINAL DESIGN IS MADE ON THE PREMISE THAT CONCORD CIRCLE WILL BE VACATED AND BALZAR AVENUE AND CONCORD STREET WILL BE DEDICATED THROUGH THE EXISTING CIRCLE. IF THIS IS NOT ACCOMPLISHED BY THE TIME CONSTRUCTION IS UNDERWAY, THEN THE ALTERNATE DESIGN WILL BE USED. EASEMENTS WILL BE ACQUIRED BY THE CITY OF LAS VEGAS.

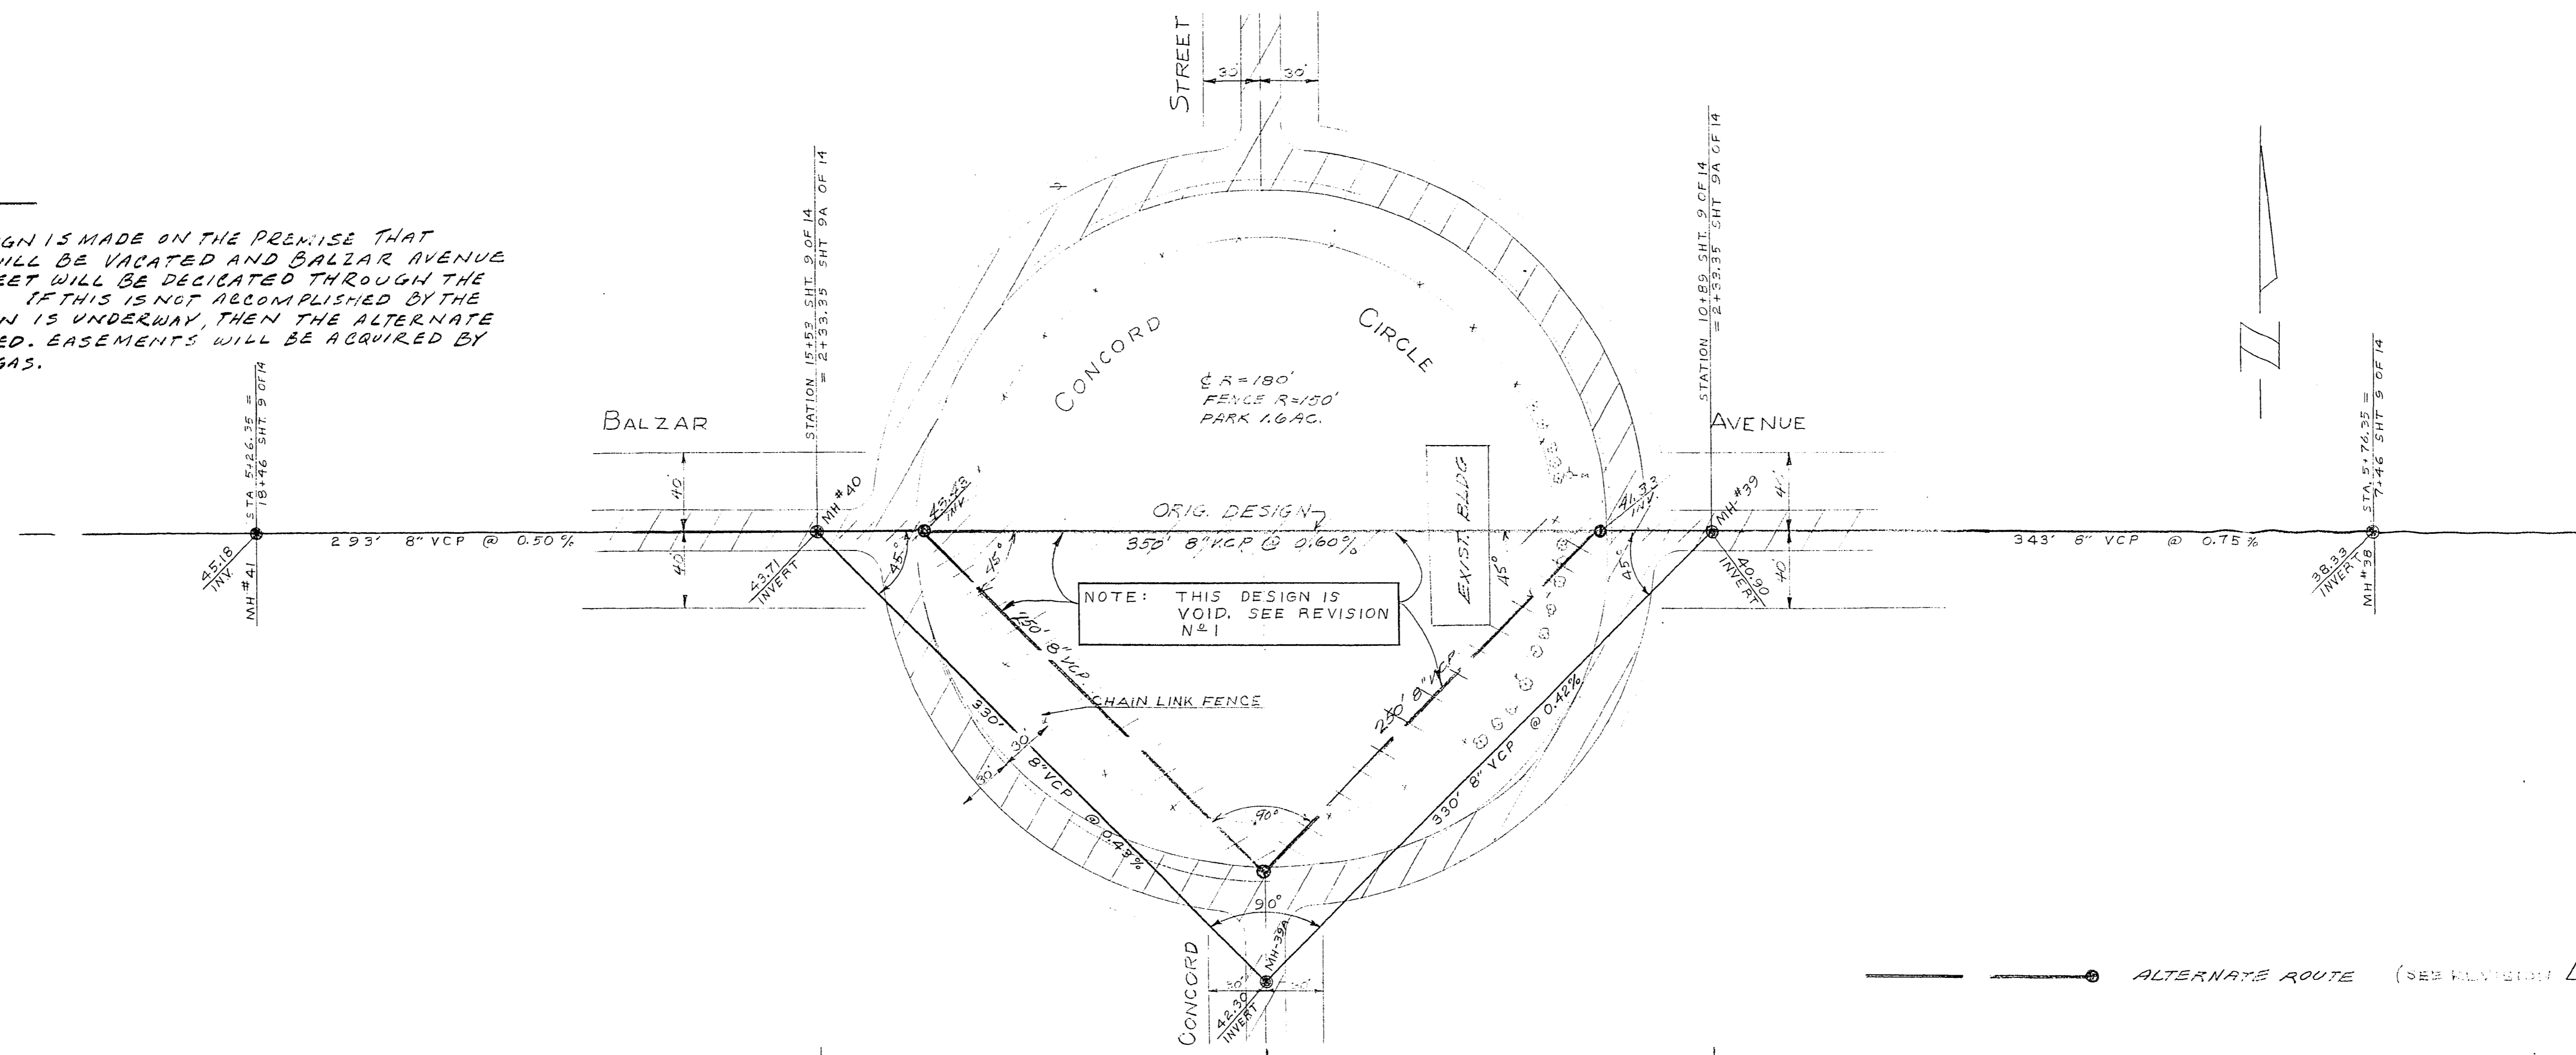

2050
2045
2040

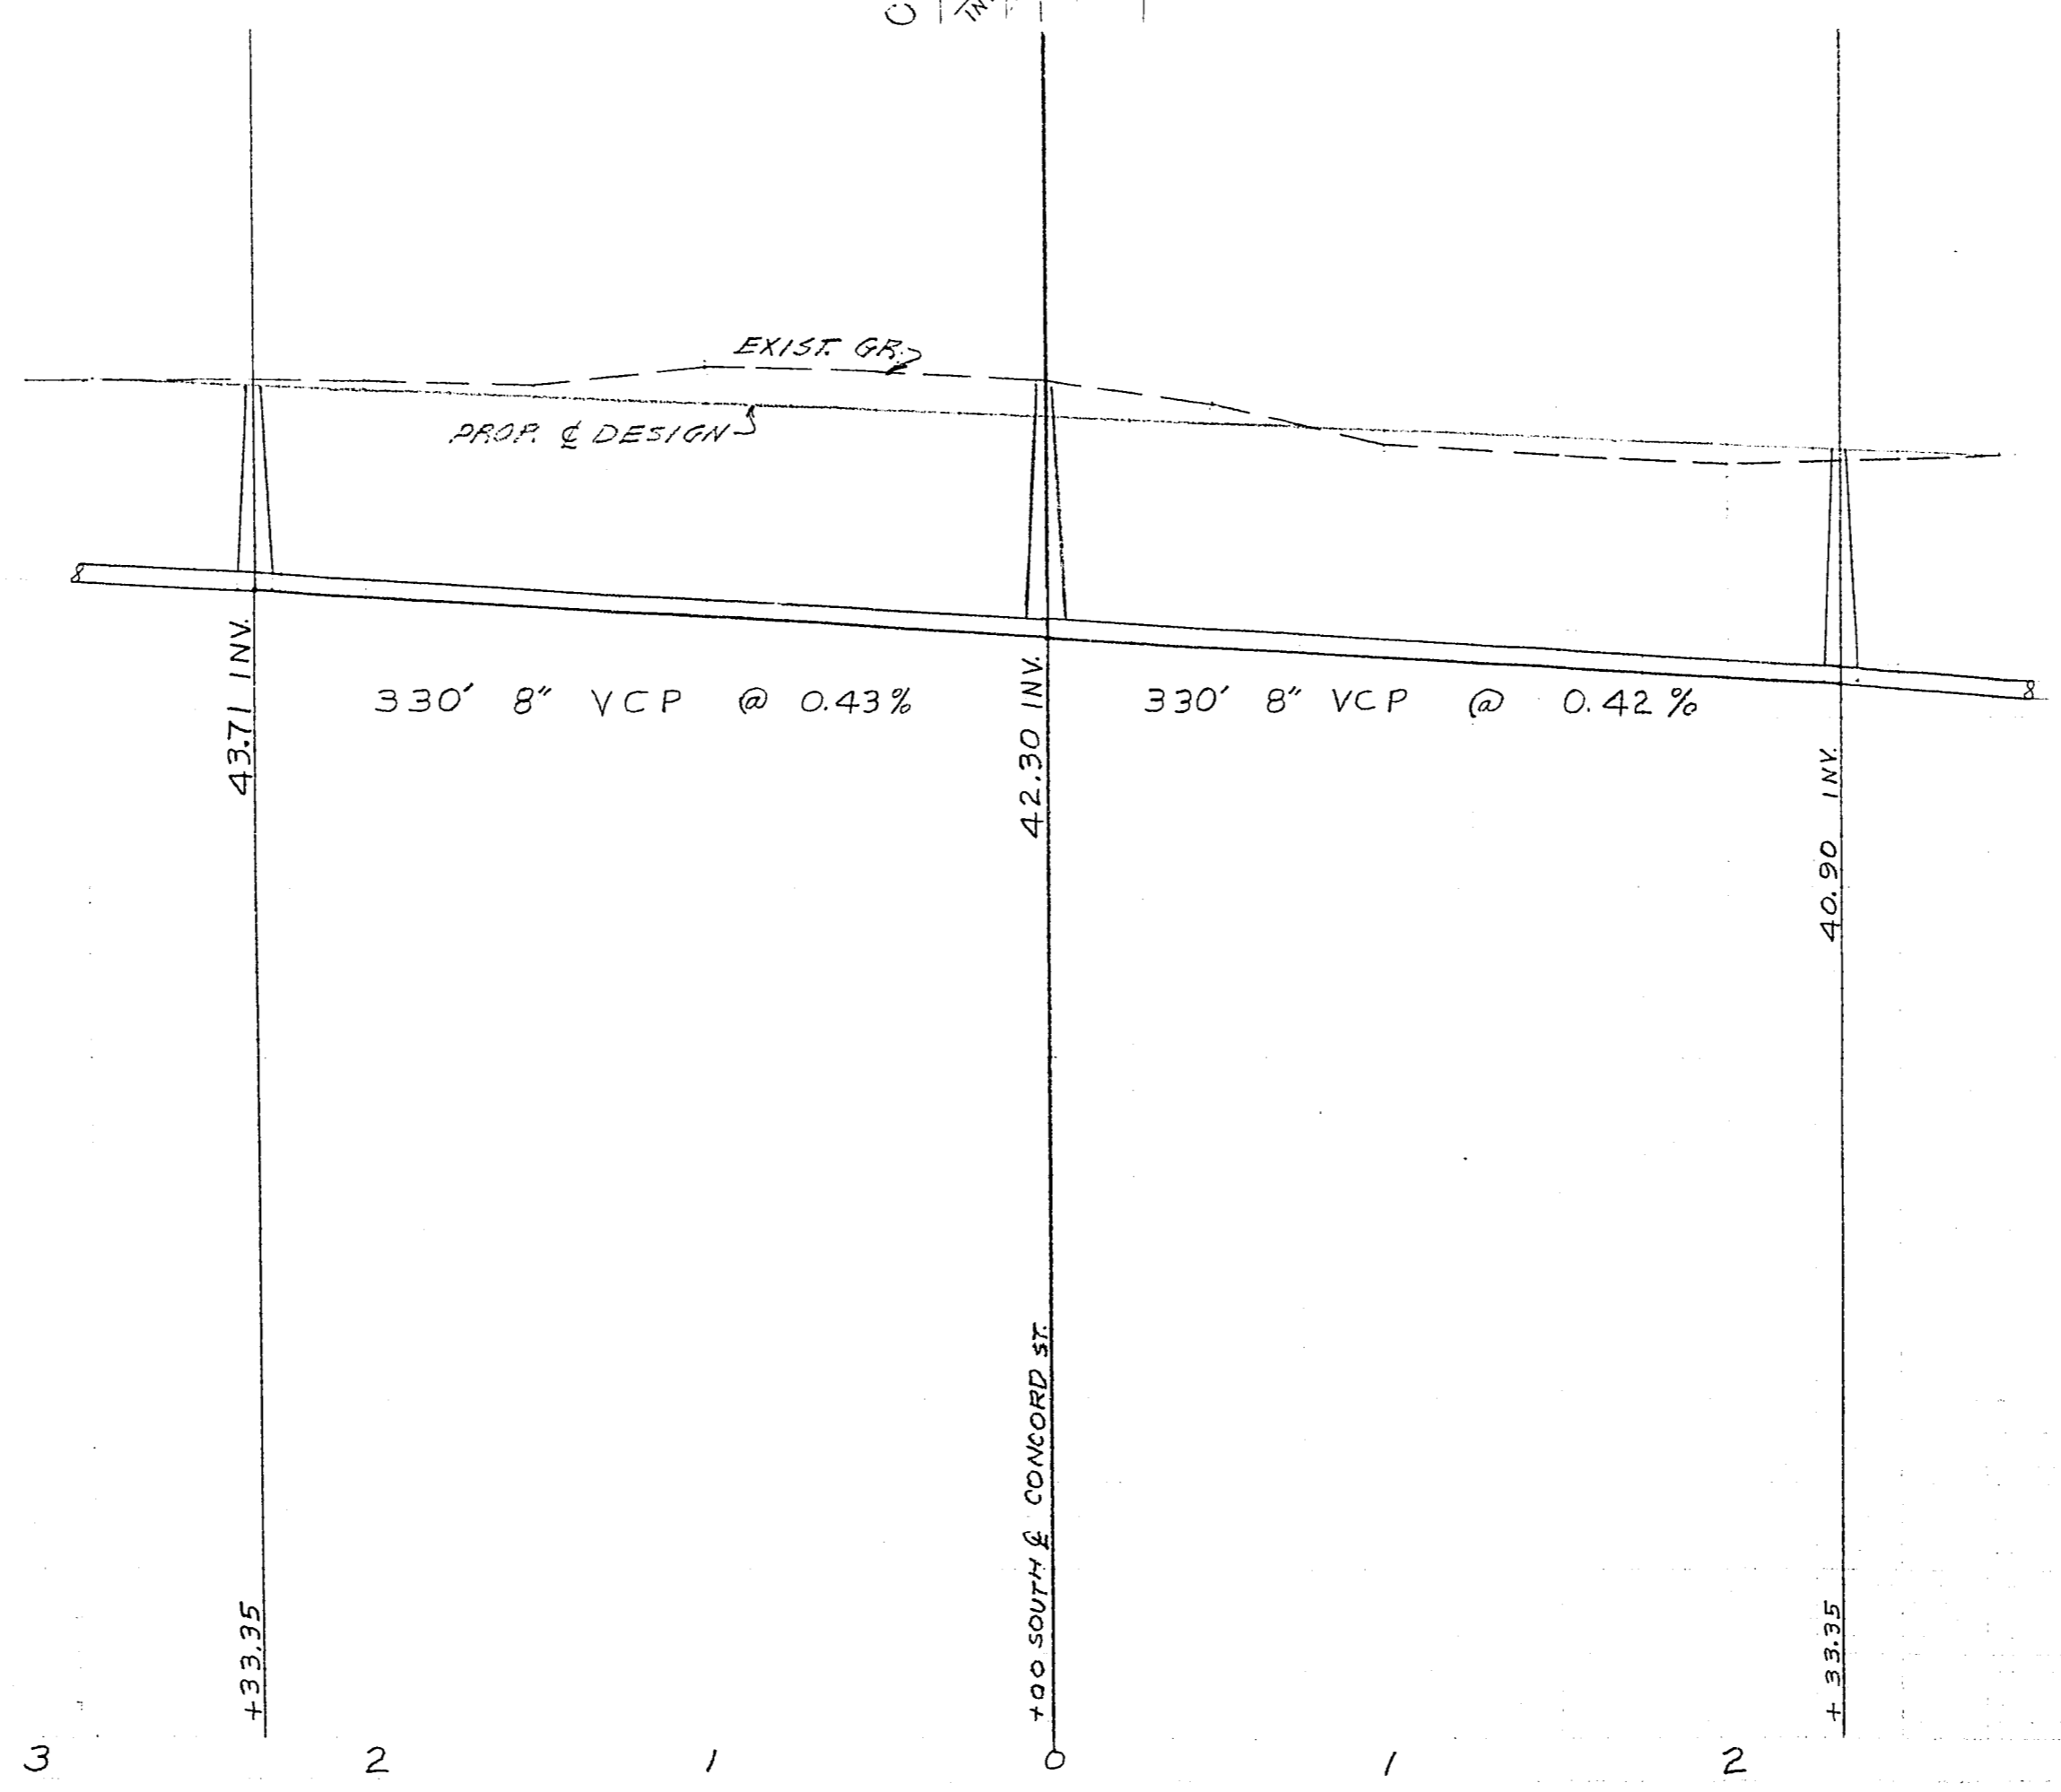

APPROVED BY: _____
S.U.P.T. SANITATION DATE: _____

REVISION: Δ
SEWER ALIGNMENT MODIFIED TO REMAIN WITHIN EXISTING RIGHT-OF-WAY
APPROVED BY: *[Signature]* 9/2/65
CITY ENGINEER DATE

CONTRACT DRAWING
JUNE 7 1965

SAD 467

CITY OF LAS VEGAS NEVADA
ENGINEERING DEPT.

CONCORD CIRCLE
ALTERNATE SEWER DESIGN

DES. DODD	DATE 12-1-64	SC. 1/1" = 50'
DR. LANGE	11-30-64	SC. 1/1" = 5'
CKD.		F.B.K. NO. 64-182
APPROVED BY CITY ENGR. <i>[Signature]</i>	2-3-65	P.L.O. NO. DRAWING NO. 467