


NOT A PART

NOT A PART

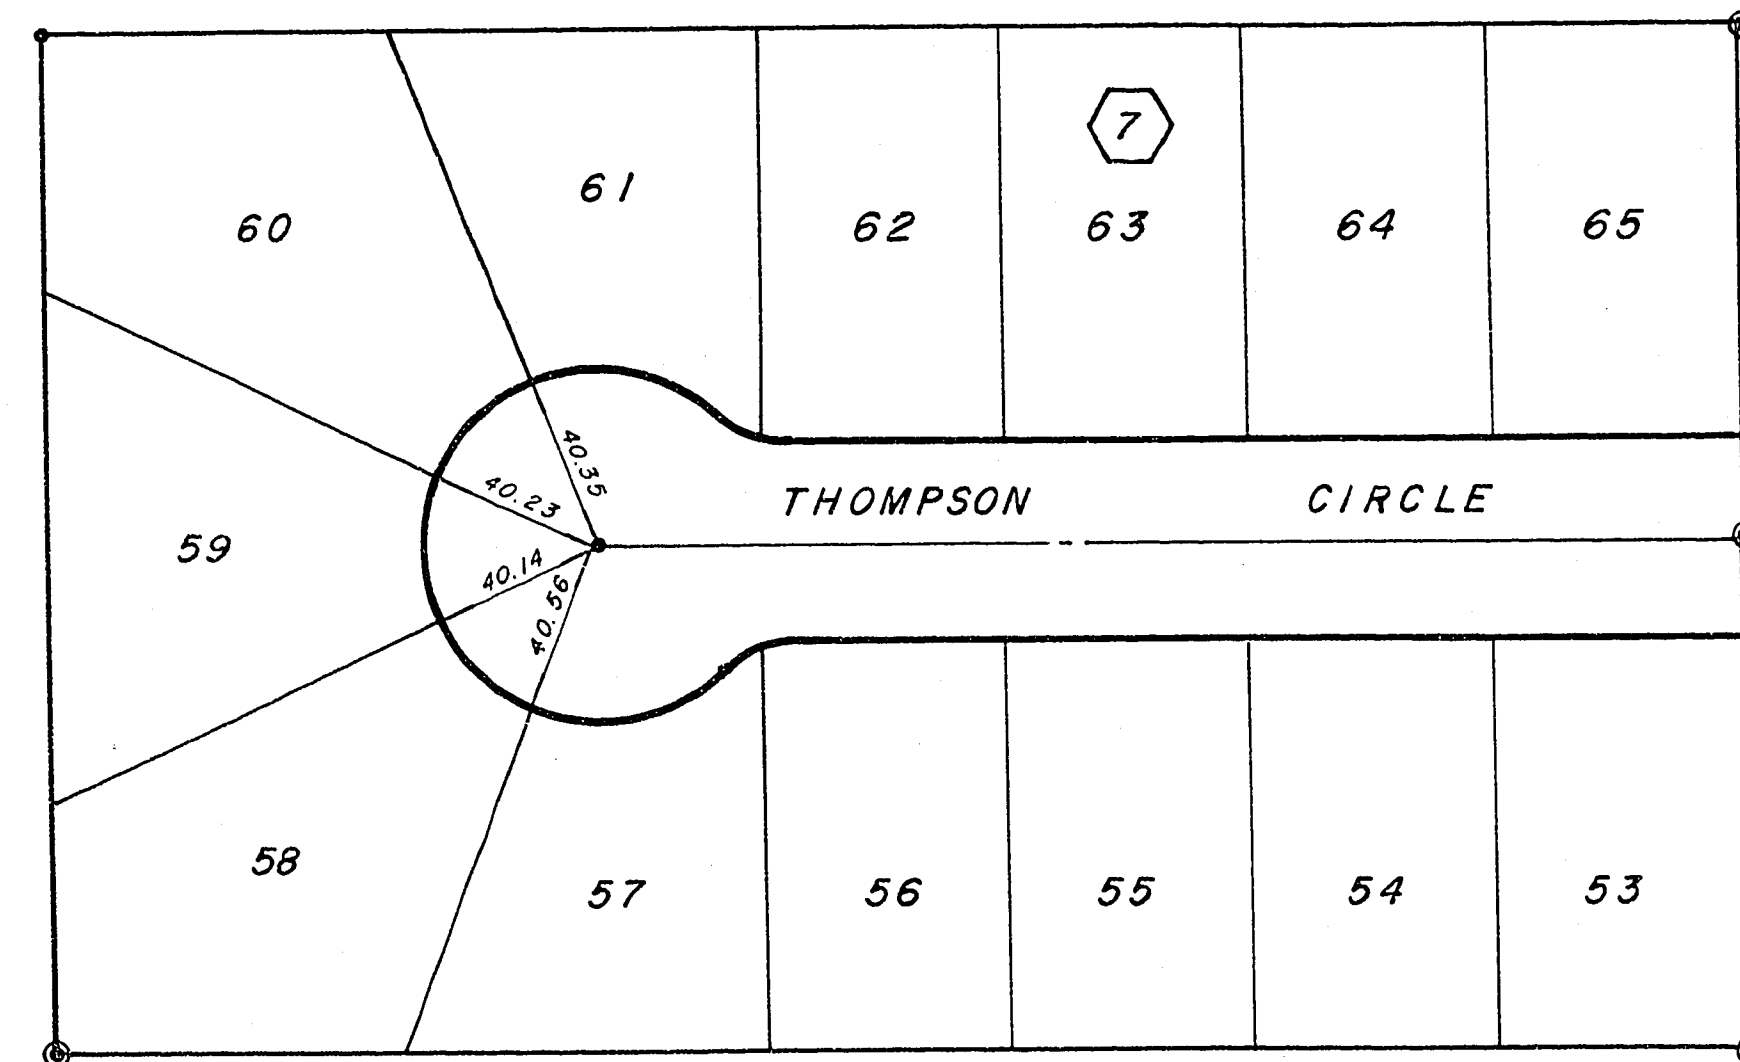

NOT A PART

NOT A PART

SCALE 1" = 50'

NOTE: ALL POINTS MARKED IN TOP OF CURB

MONUMENT MAP
FOR
CHARLESTON ESTATES
UNIT NO. 2-C

DESIGNED	WESTERN ENGINEERS, INC.	SHEET 1 OF 1
DRAWN	LAS VEGAS NEVADA	
CHECKED	APPROVED <i>[Signature]</i> DATE <i>4/15/63</i>	

1-6-15

058-1038-2c