
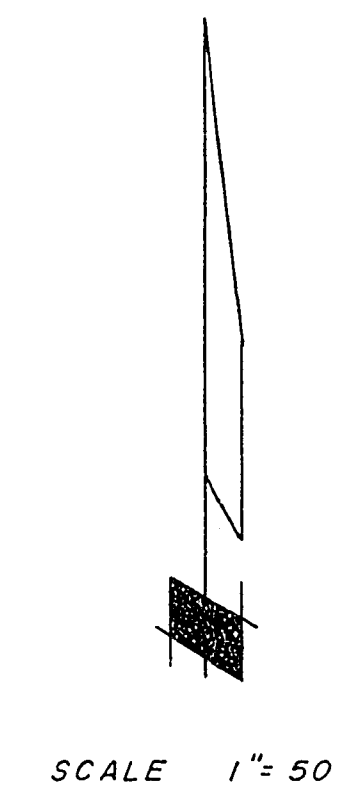


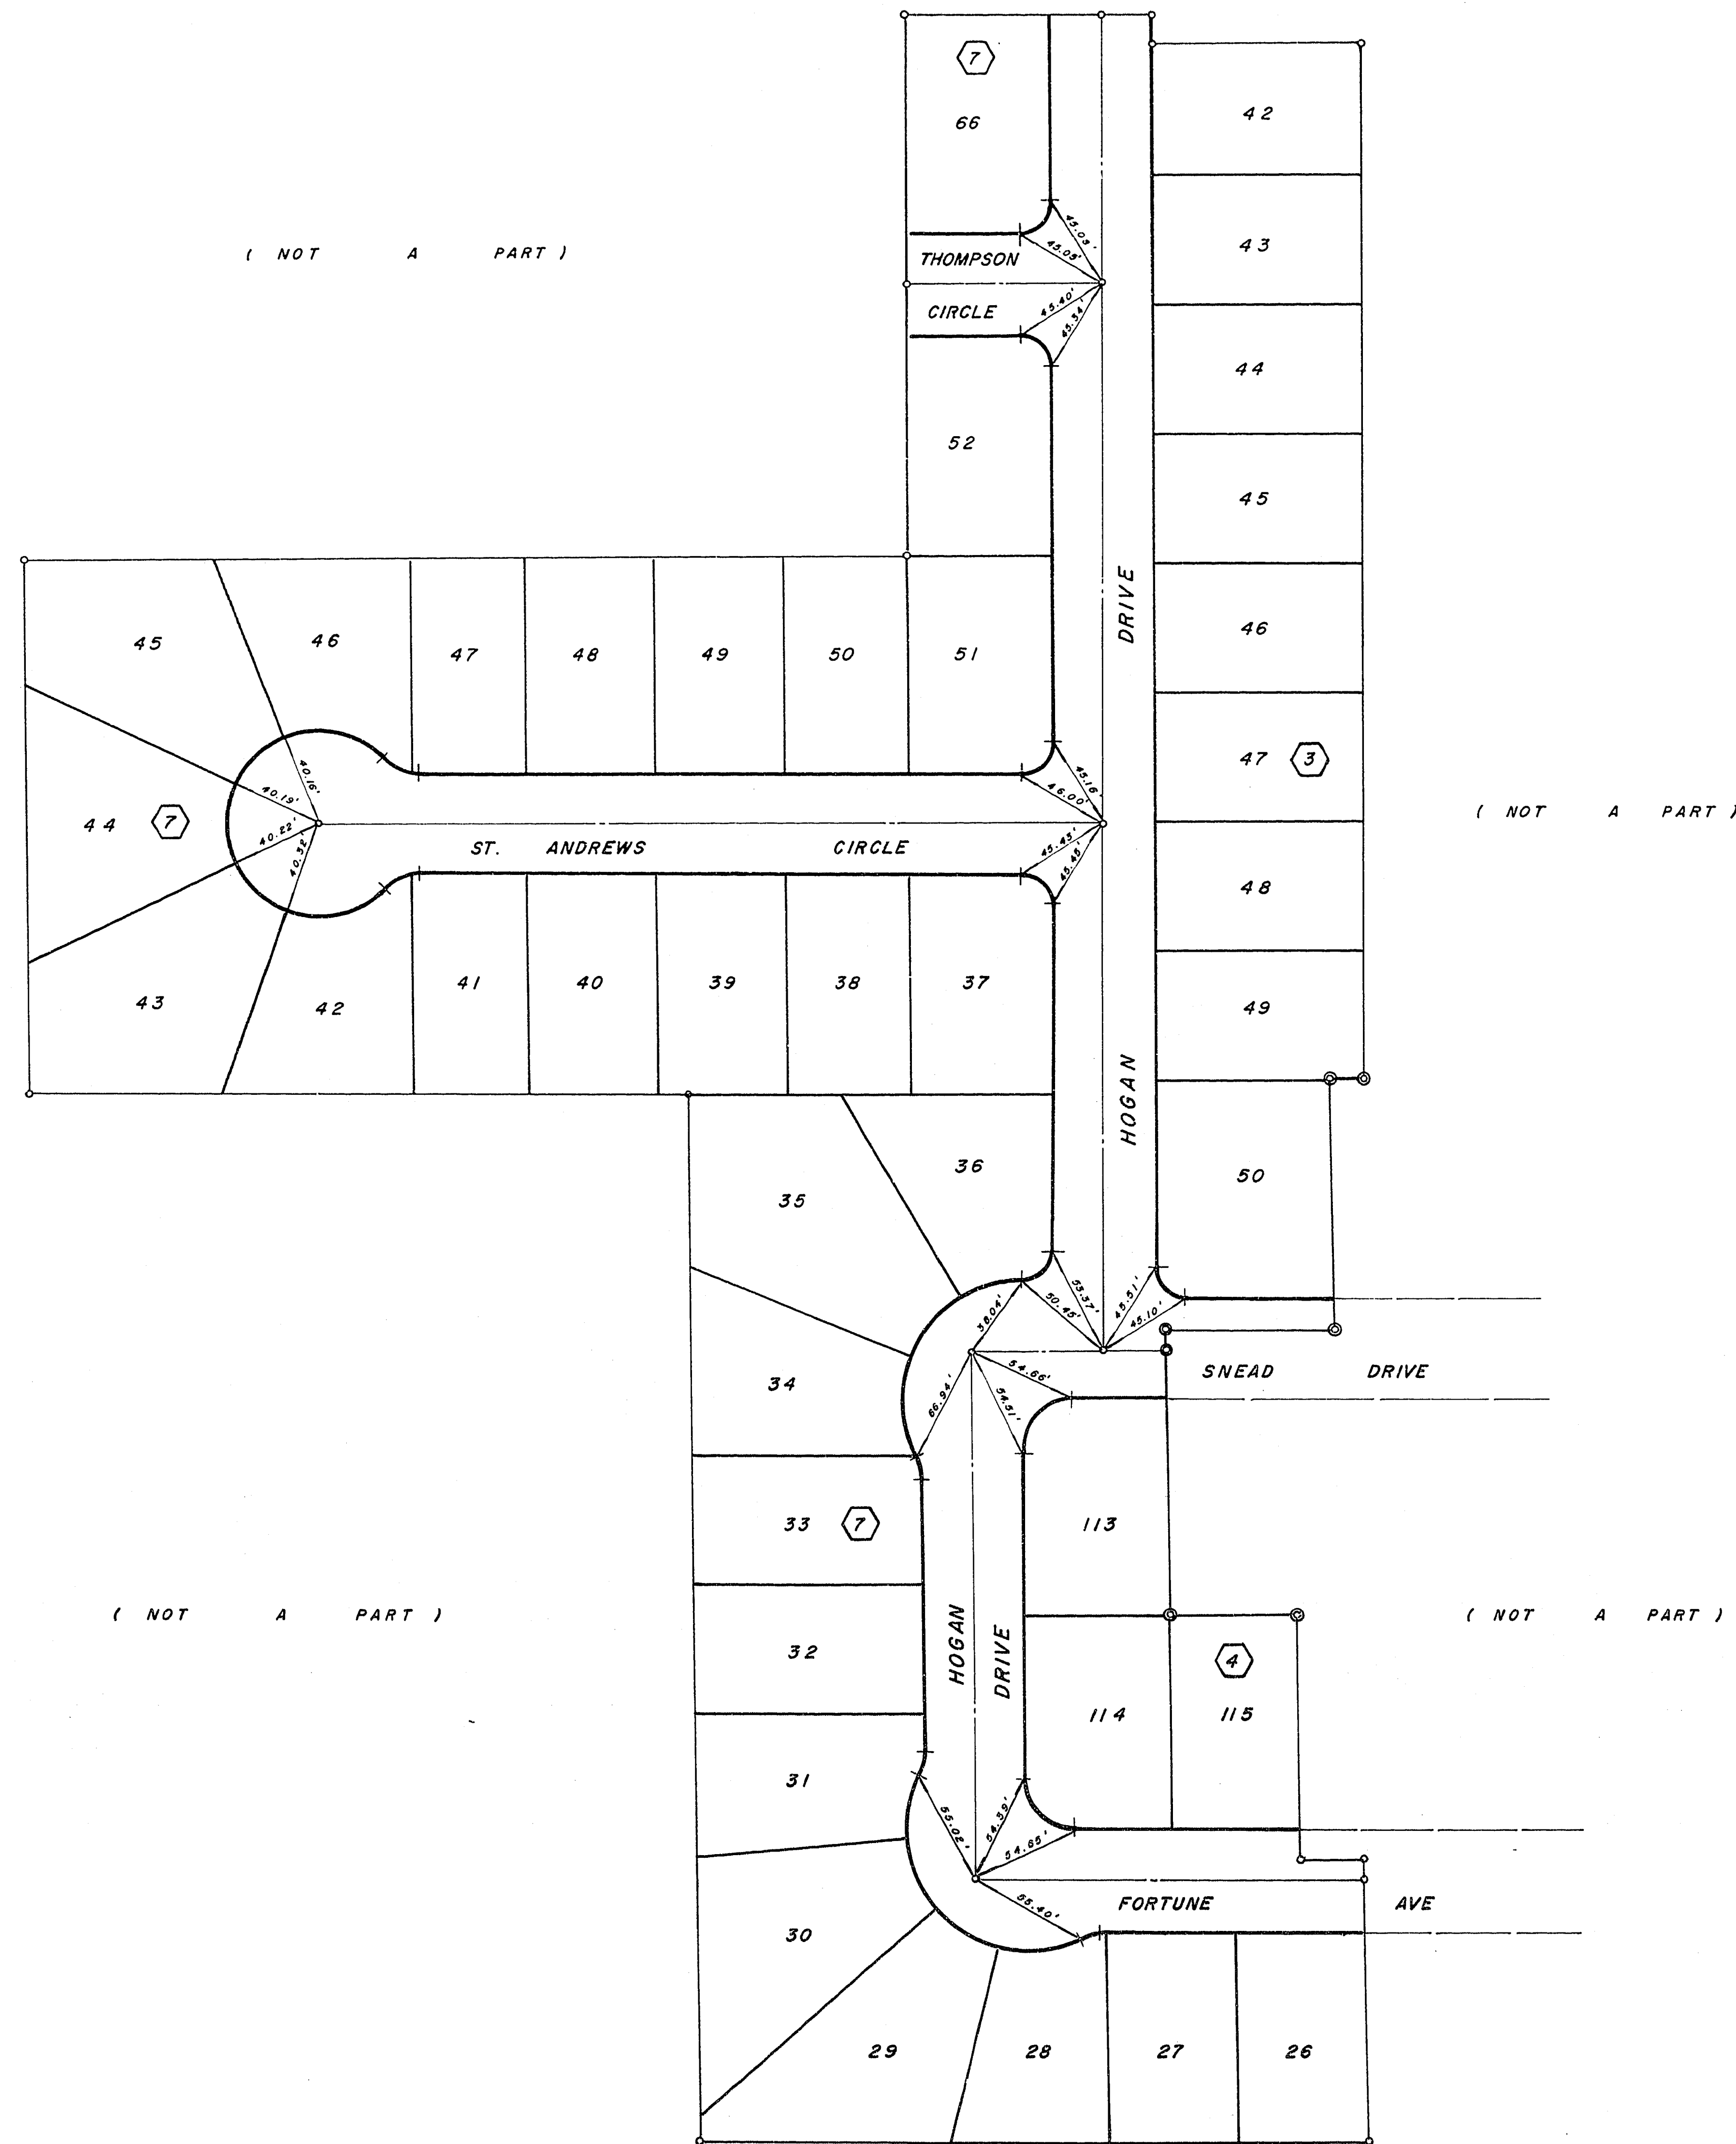

NOTE: ALL POINTS MARKED IN TOP OF CURB

MONUMENT MAP FOR CHARLESTON ESTATES UNIT NO. 2-B		
DESIGNED	WESTERN ENGINEERS, INC.	SHEET 1 OF 1
DRAWN	LAS VEGAS NEVADA	
CHECKED	APPROVED <i>[Signature]</i> DATE <i>4/26/63</i>	

1-6-16

058-1638-26