
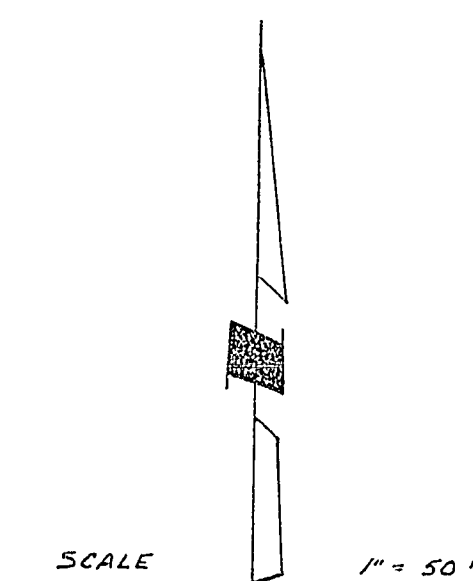


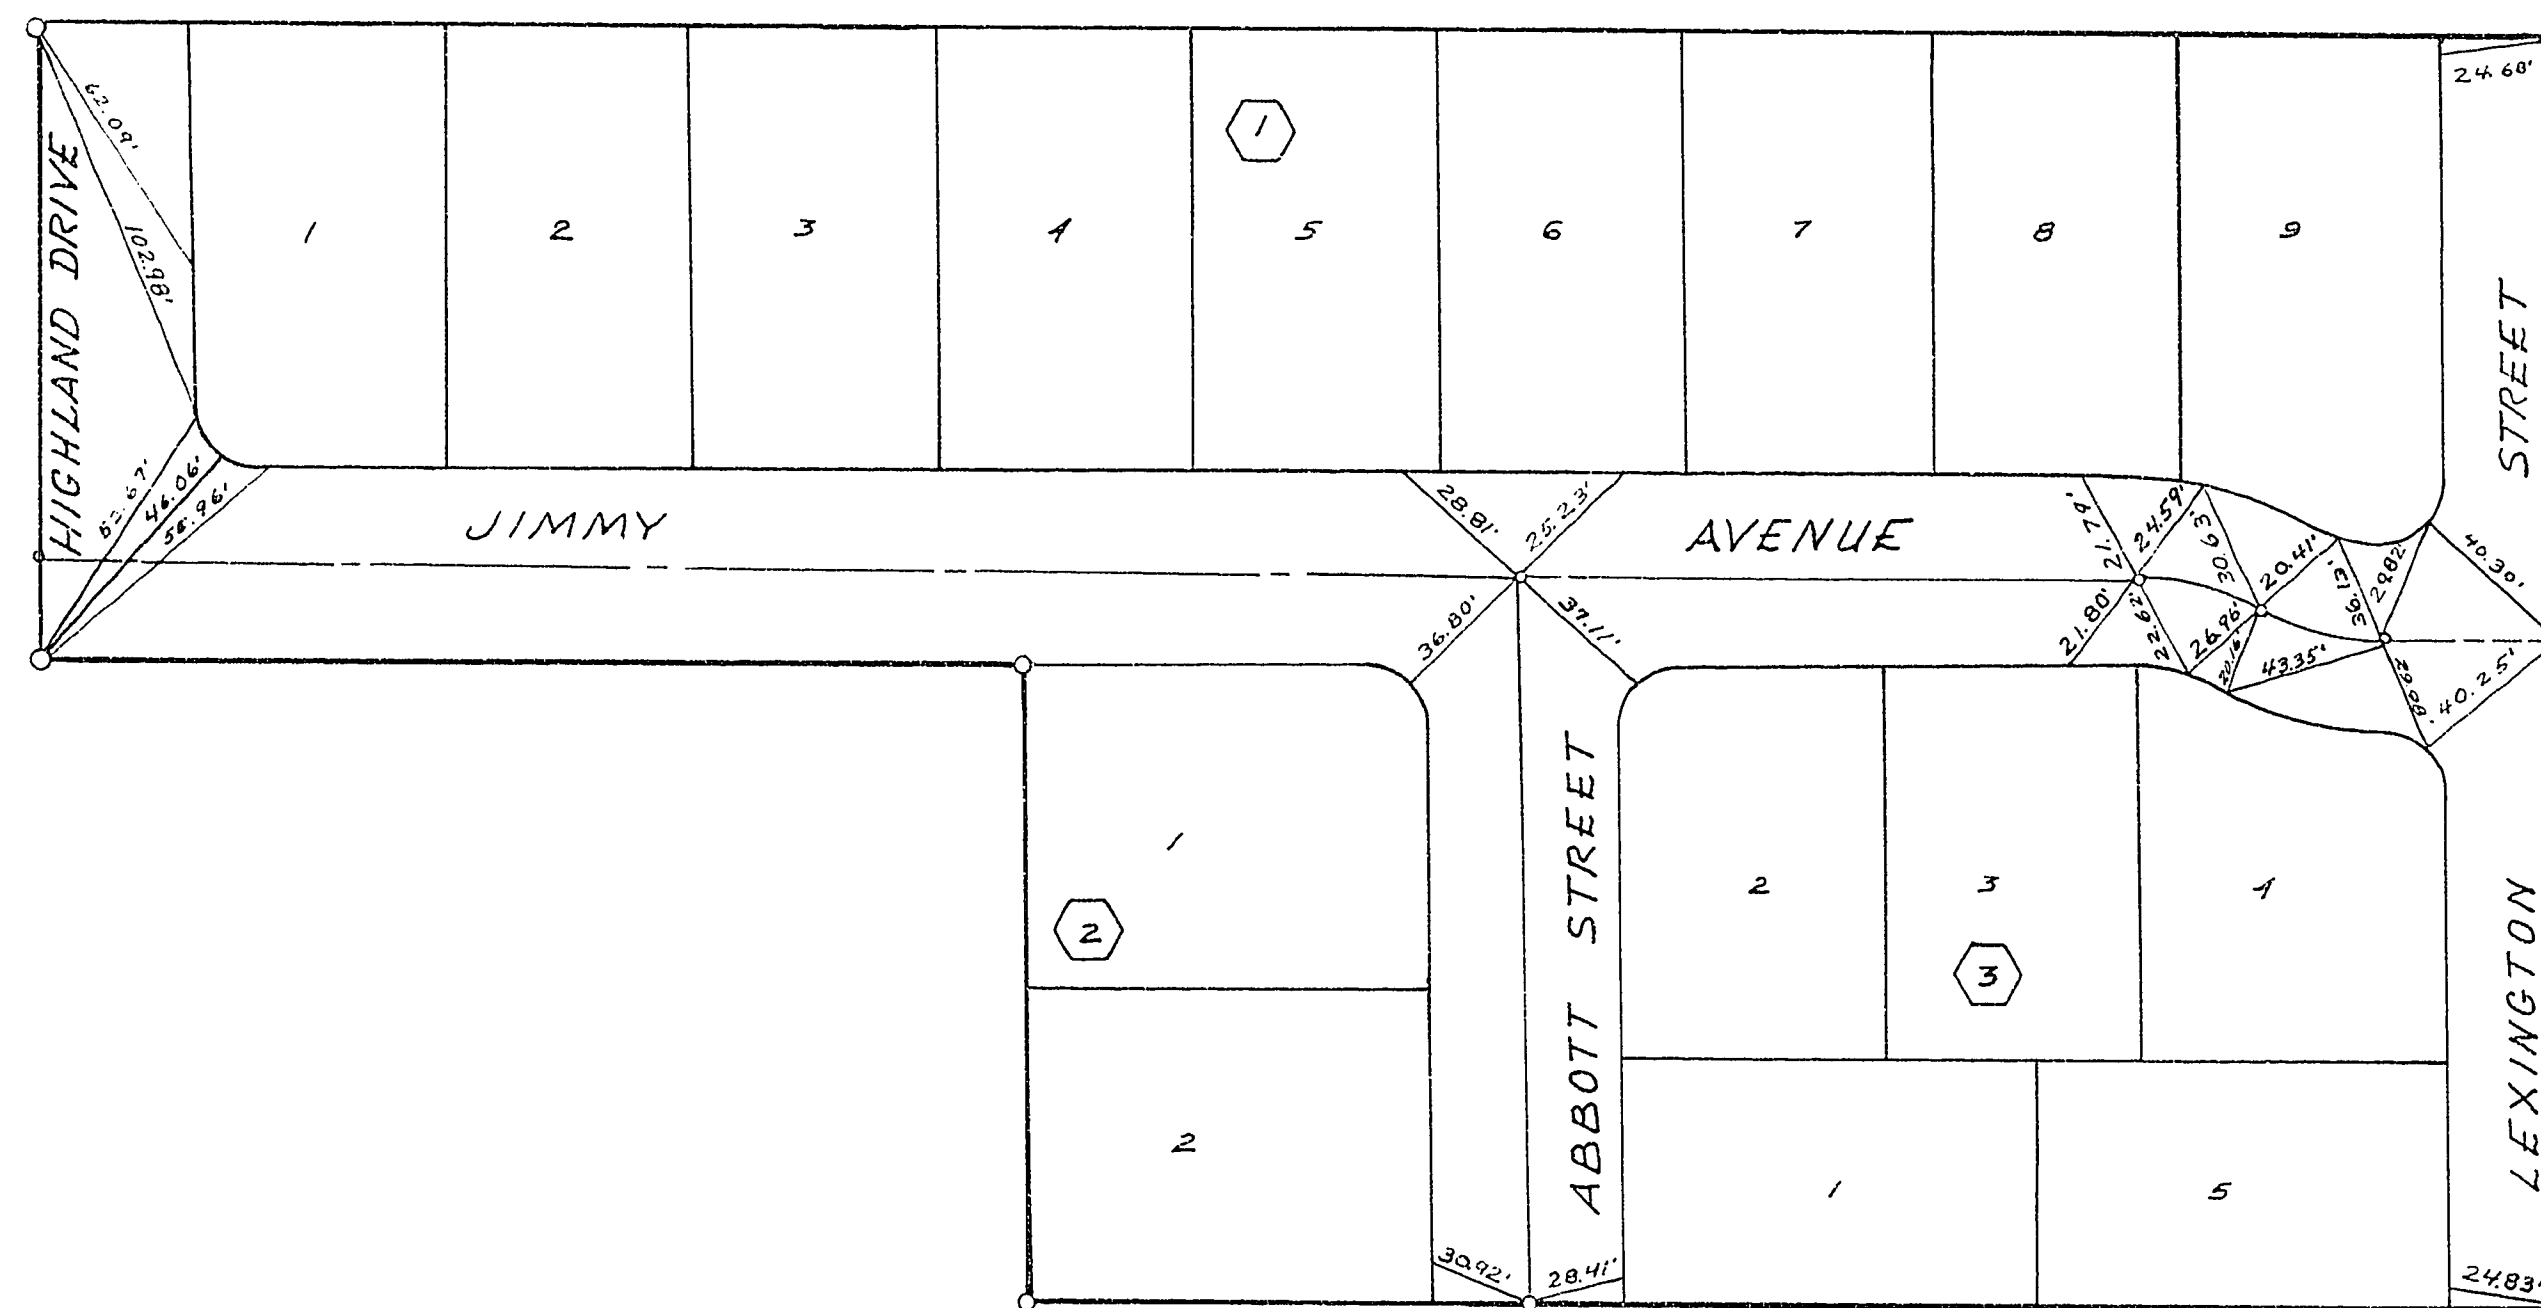

Note: All Points Marked in Top of Curb
Unless Otherwise Noted

MONUMENT MAP FOR
CARVER MANOR

DESIGNED	TROJAN ENGINEERING, INC.	SHEET /
DRAWN MH	800 W. BONANZA RD. SUITE 100	OF 1
CHECKED W	LAS VEGAS, NEVADA	
APPROVED	<i>[Signature]</i>	

1-6-84

058-1031