


CHAS. HEIGHTS 29-A

CHAS. HEIGHTS 28-A

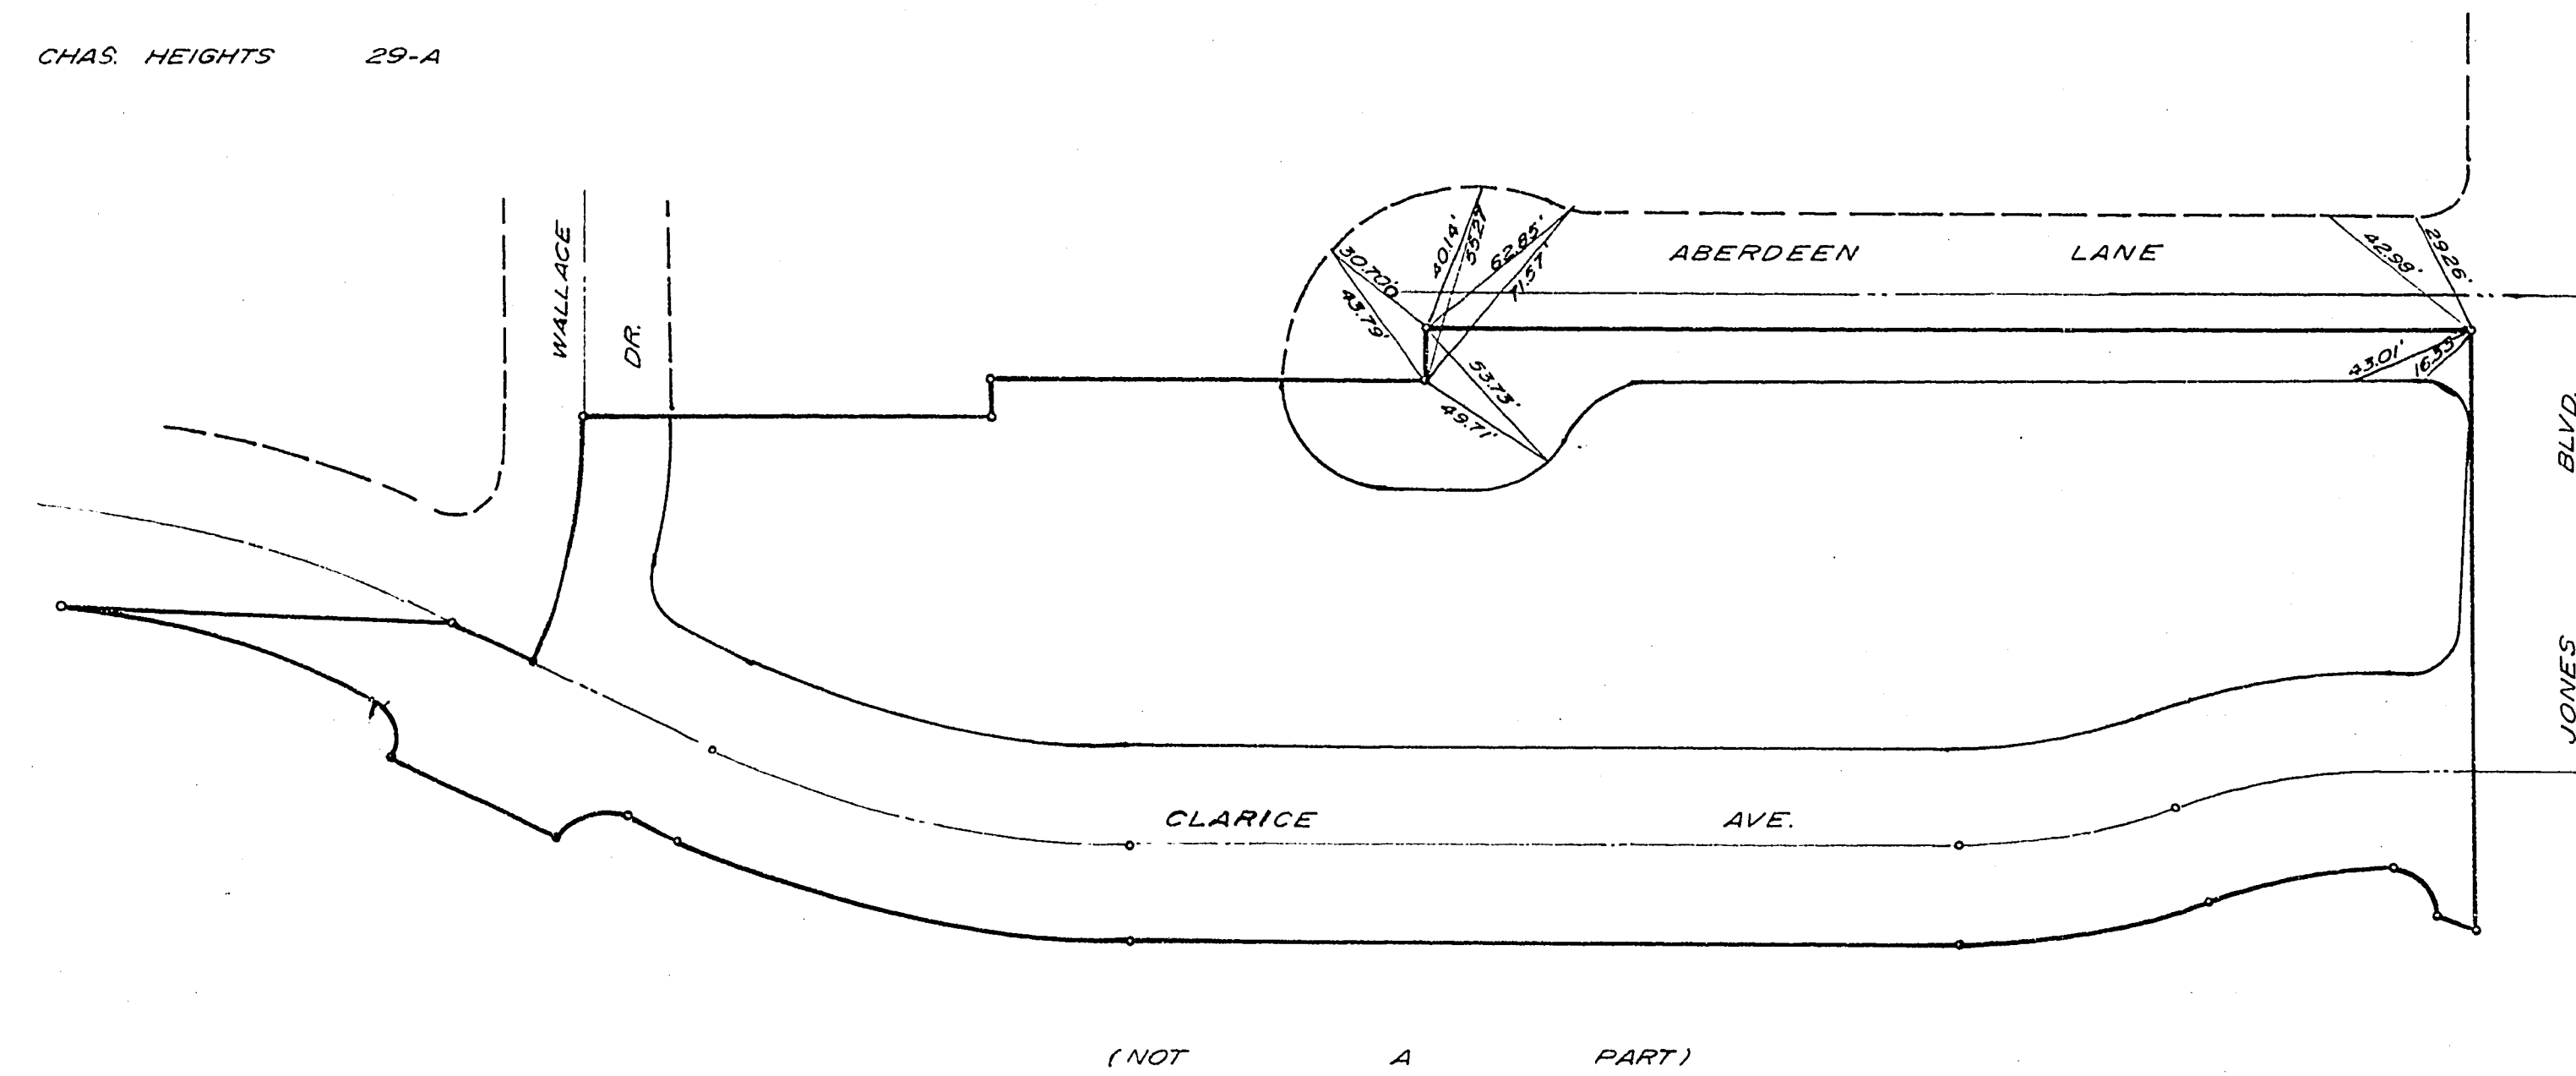

NOTE. ALL TIES TO CHISELED "X"
IN TOP OF CURB.
FOR TIES ALONG CLARICE
AVENUE SEE MONUMENT
MAP OF CHARLESTON HTS. 29-A

SCALE 1" = 50'

MONUMENT MAP		
CHARLESTON HEIGHTS TRACT		
NO. 28-B		
DESIGNED	WESTERN ENGINEERS, INC.	SHEET /
DRAWN	LAS VEGAS NEVADA	OF 1
CHECKED	APPROVED <i>[Signature]</i> DATE 5-20-64	

2690 098-1040-28B