


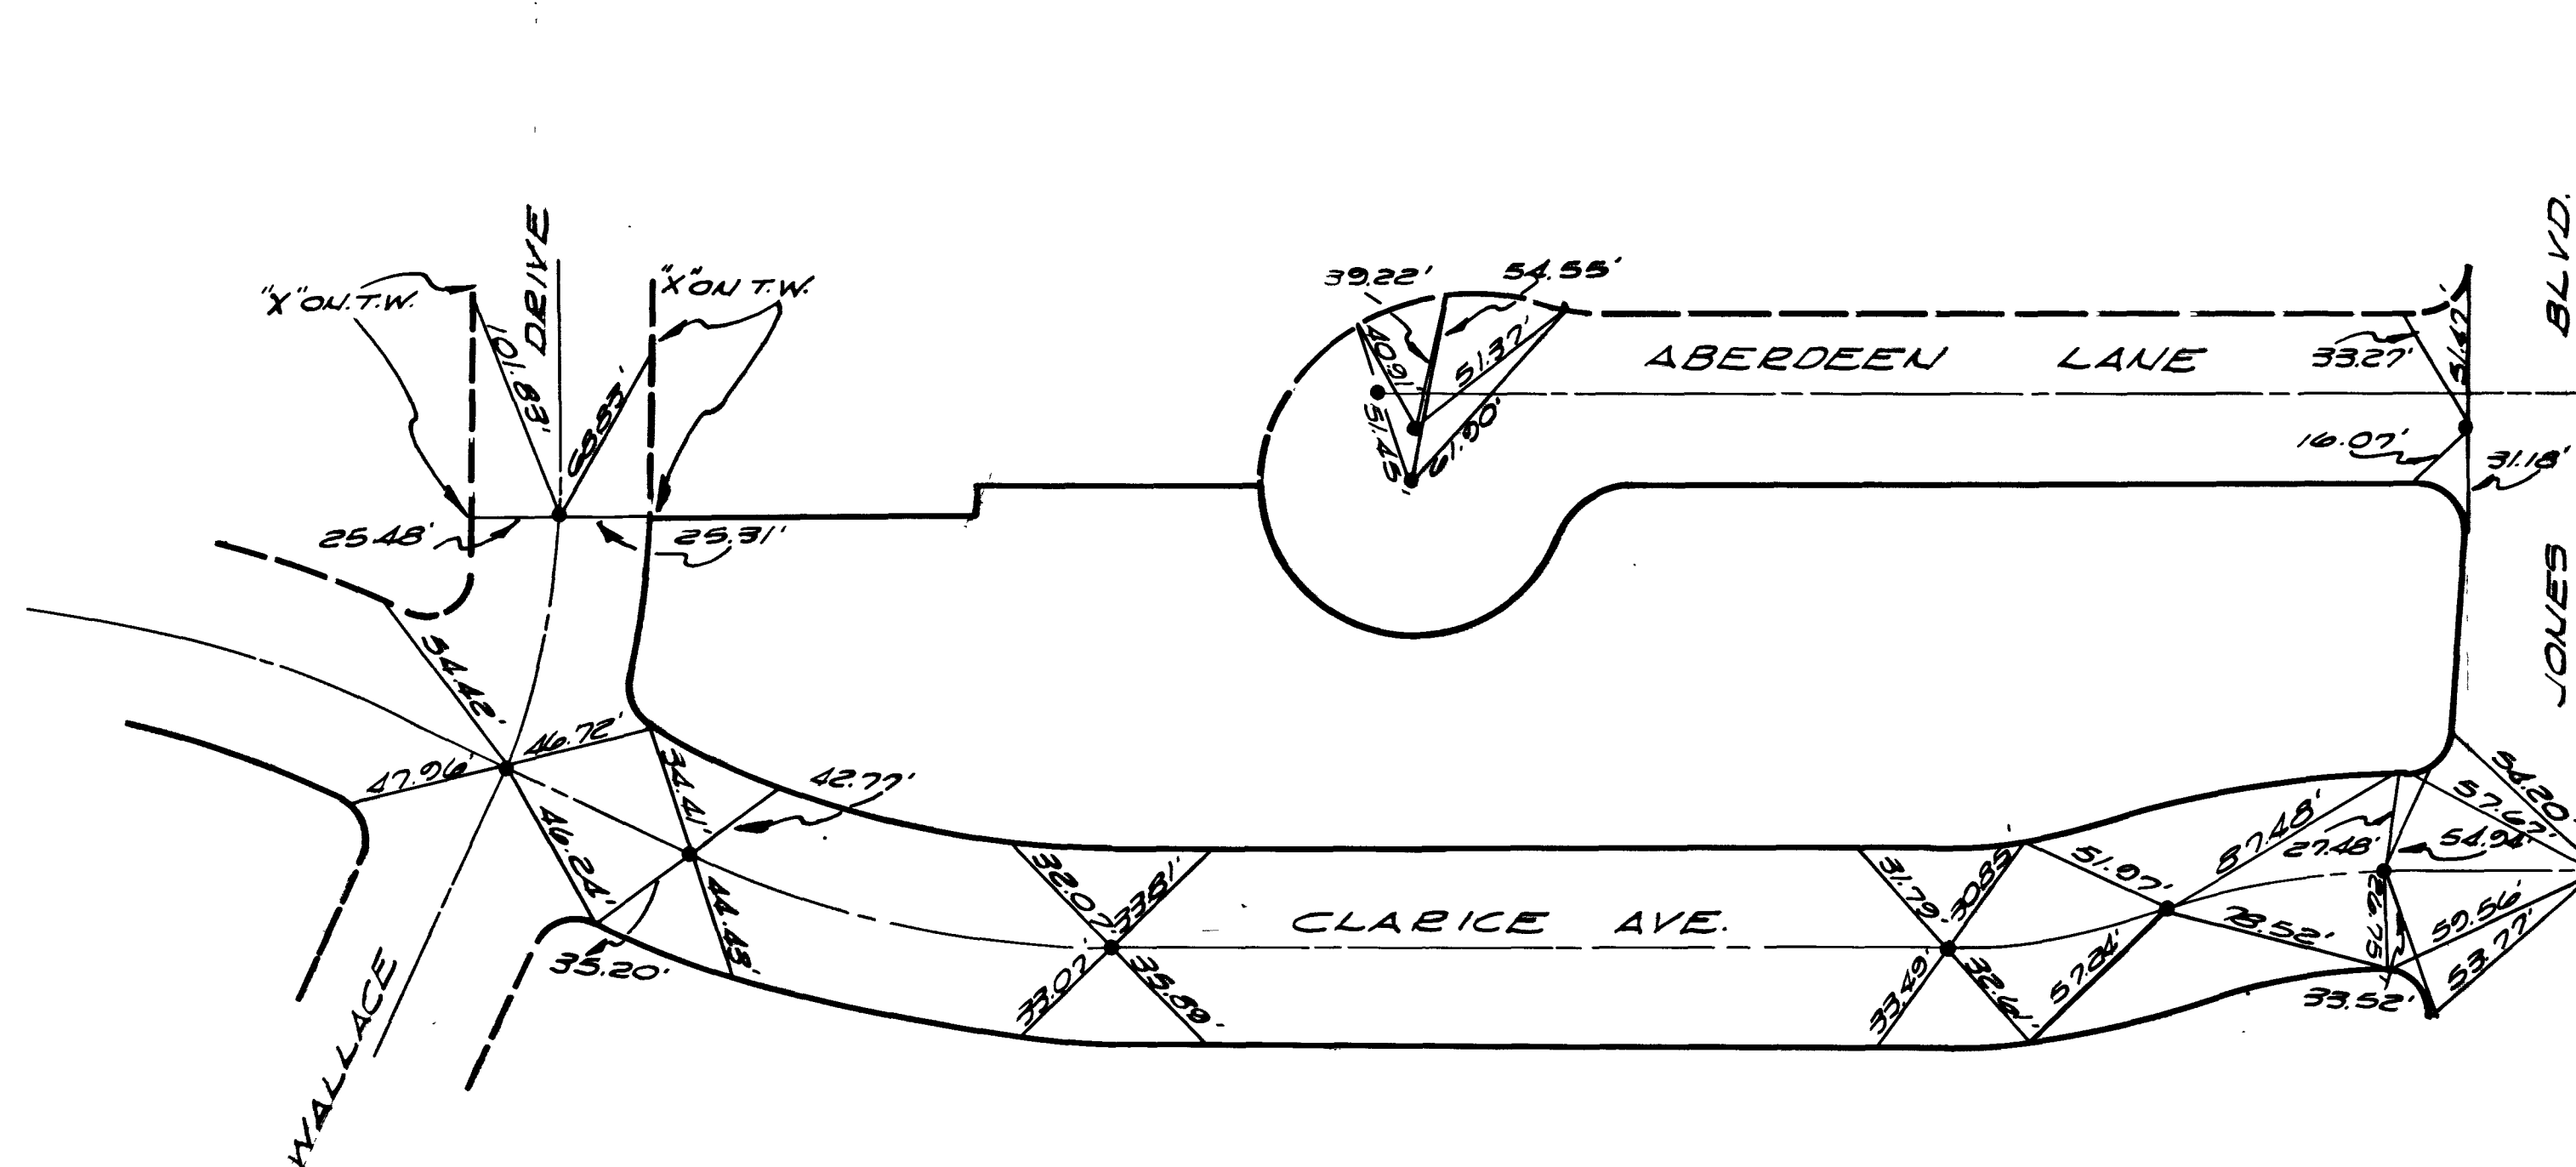

SCALE 1" = 50'


NOTES
 1. ALL MONUMENTS SET BY R.L.S. 1412.
 2. ALL MONUMENT REFERENCE TIES ARE CH 15 "X" IN TOP OF CURB. (UNLESS OTHERWISE SHOWN.)

MONUMENT MAP			
FOR CHARLESTON			
HEIGHTS TRACT NR 28-B			
DESIGNED	WESTERN ENGINEERS, INC.		
DRAWN L.S.	LAS VEGAS	NEVADA	SHEET 1
9/2	9/2	9/2	9/2

2702

2-10-61

058-1040-28B

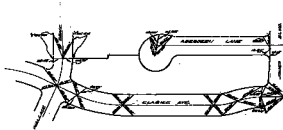

ALL DIMENSIONS ARE IN FEET
 1" = 100'

CONTRACT NO.	
FOR STATIONING	
APPROXIMATE TOTAL IN SQ. FT.	
DATE	BY
10/10/68	10/10/68
10/10/68	10/10/68