BOOK 781

740829

MONUMENTATION MAP FOR

CORONADO PARK

BEING A PORTION OF THE NE1/4 OF THE NE1/4 OF THE NE 1/4 OF
SECTION 26, T20S, R61E, M.D.M., CITY OF LAS VEGAS, CLARK COUNTY, NEVADA.

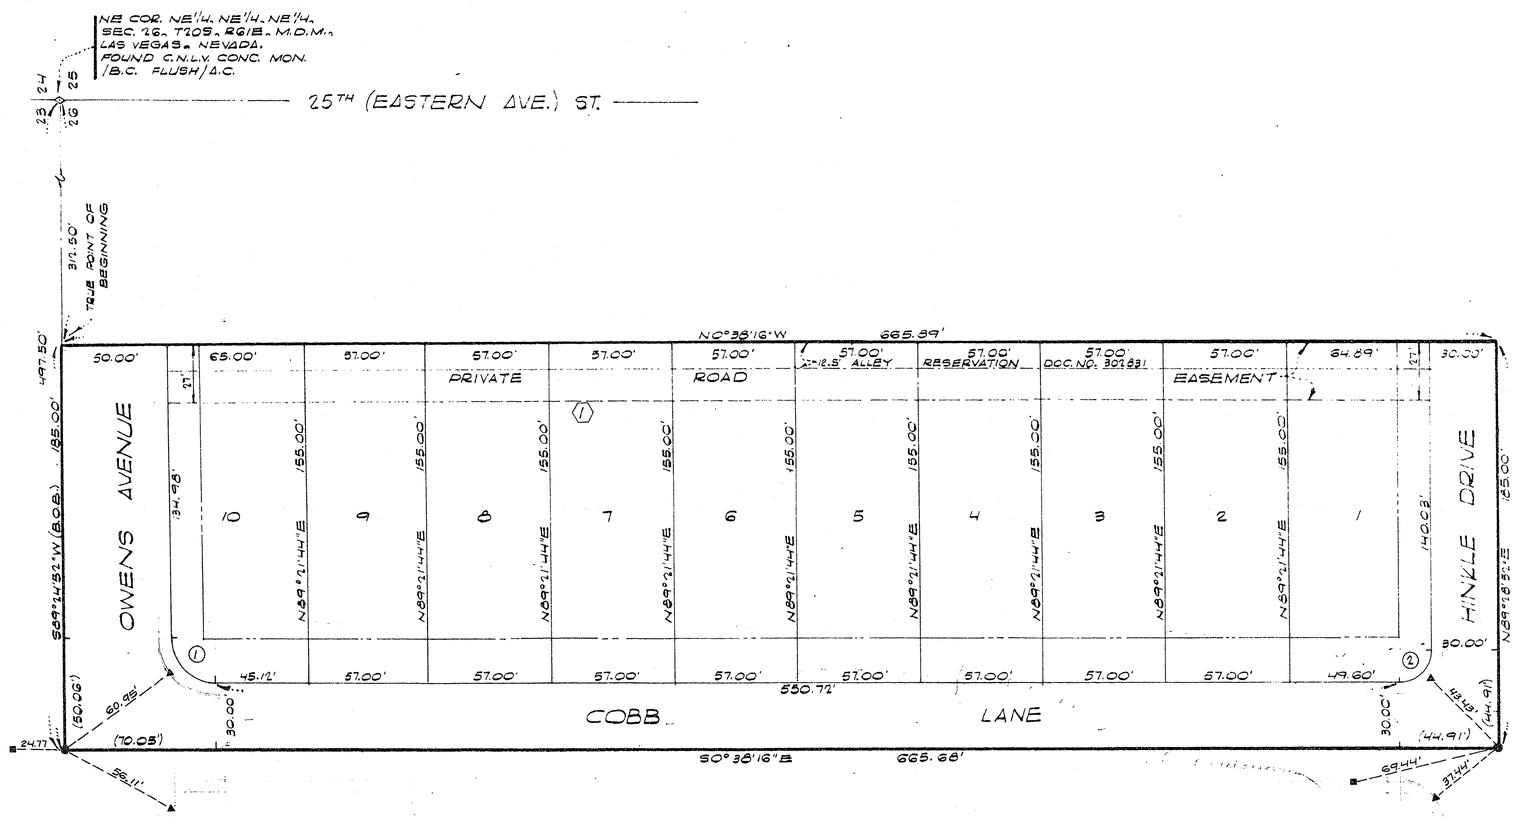

CURVE DATA

NO.	DELTA	RADIUS	TANGENT	LENGTH
1	90-03-08	20.00	20.02	31.43
2	89-52-52	15.00	14.97	23.53

SCALE 1"=30'

TIE SHEET LEGEND

- ▲ SET BRASS CAP IN TOP OF CURB
- ● SET 5/8" REBAR/AL CAP RLS NO. 2897
- ■ SET RAMSET

SURVEYOR'S CERTIFICATE

THIS IS TO CERTIFY THAT THE MONUMENTS HAVE BEEN SET AND TIES ESTABLISHED AS SHOWN HEREON.

William T. Cuddy 2/20/79

WILLIAM T. CUDDY — DATE
R.L.S. NO. 2897

3-6-37
058-1120-1