

ASCOT PARK

MONUMENTATION


MAP

MONUMENTATION CERTIFICATE


I, KENNETH L. KREEGER, A PROFESSIONAL LAND SURVEYOR DULY REGISTERED IN THE STATE OF NEVADA, DO HEREBY CERTIFY THAT THE MONUMENTS HAVE BEEN SET AND THE TIE DISTANCES ESTABLISHED ARE AS SHOWN HEREON.

THIS SURVEY WAS COMPLETED ON OR PRIOR TO NOVEMBER 15, 1992.

Kenneth L. Kreeger
KENNETH L. KREEGER
P.L.S. 8305

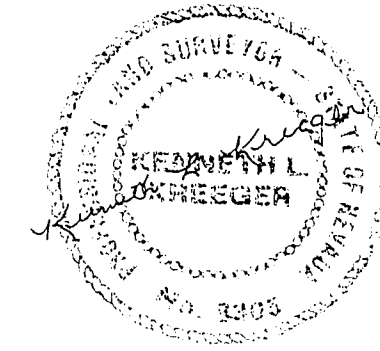

12-10-92

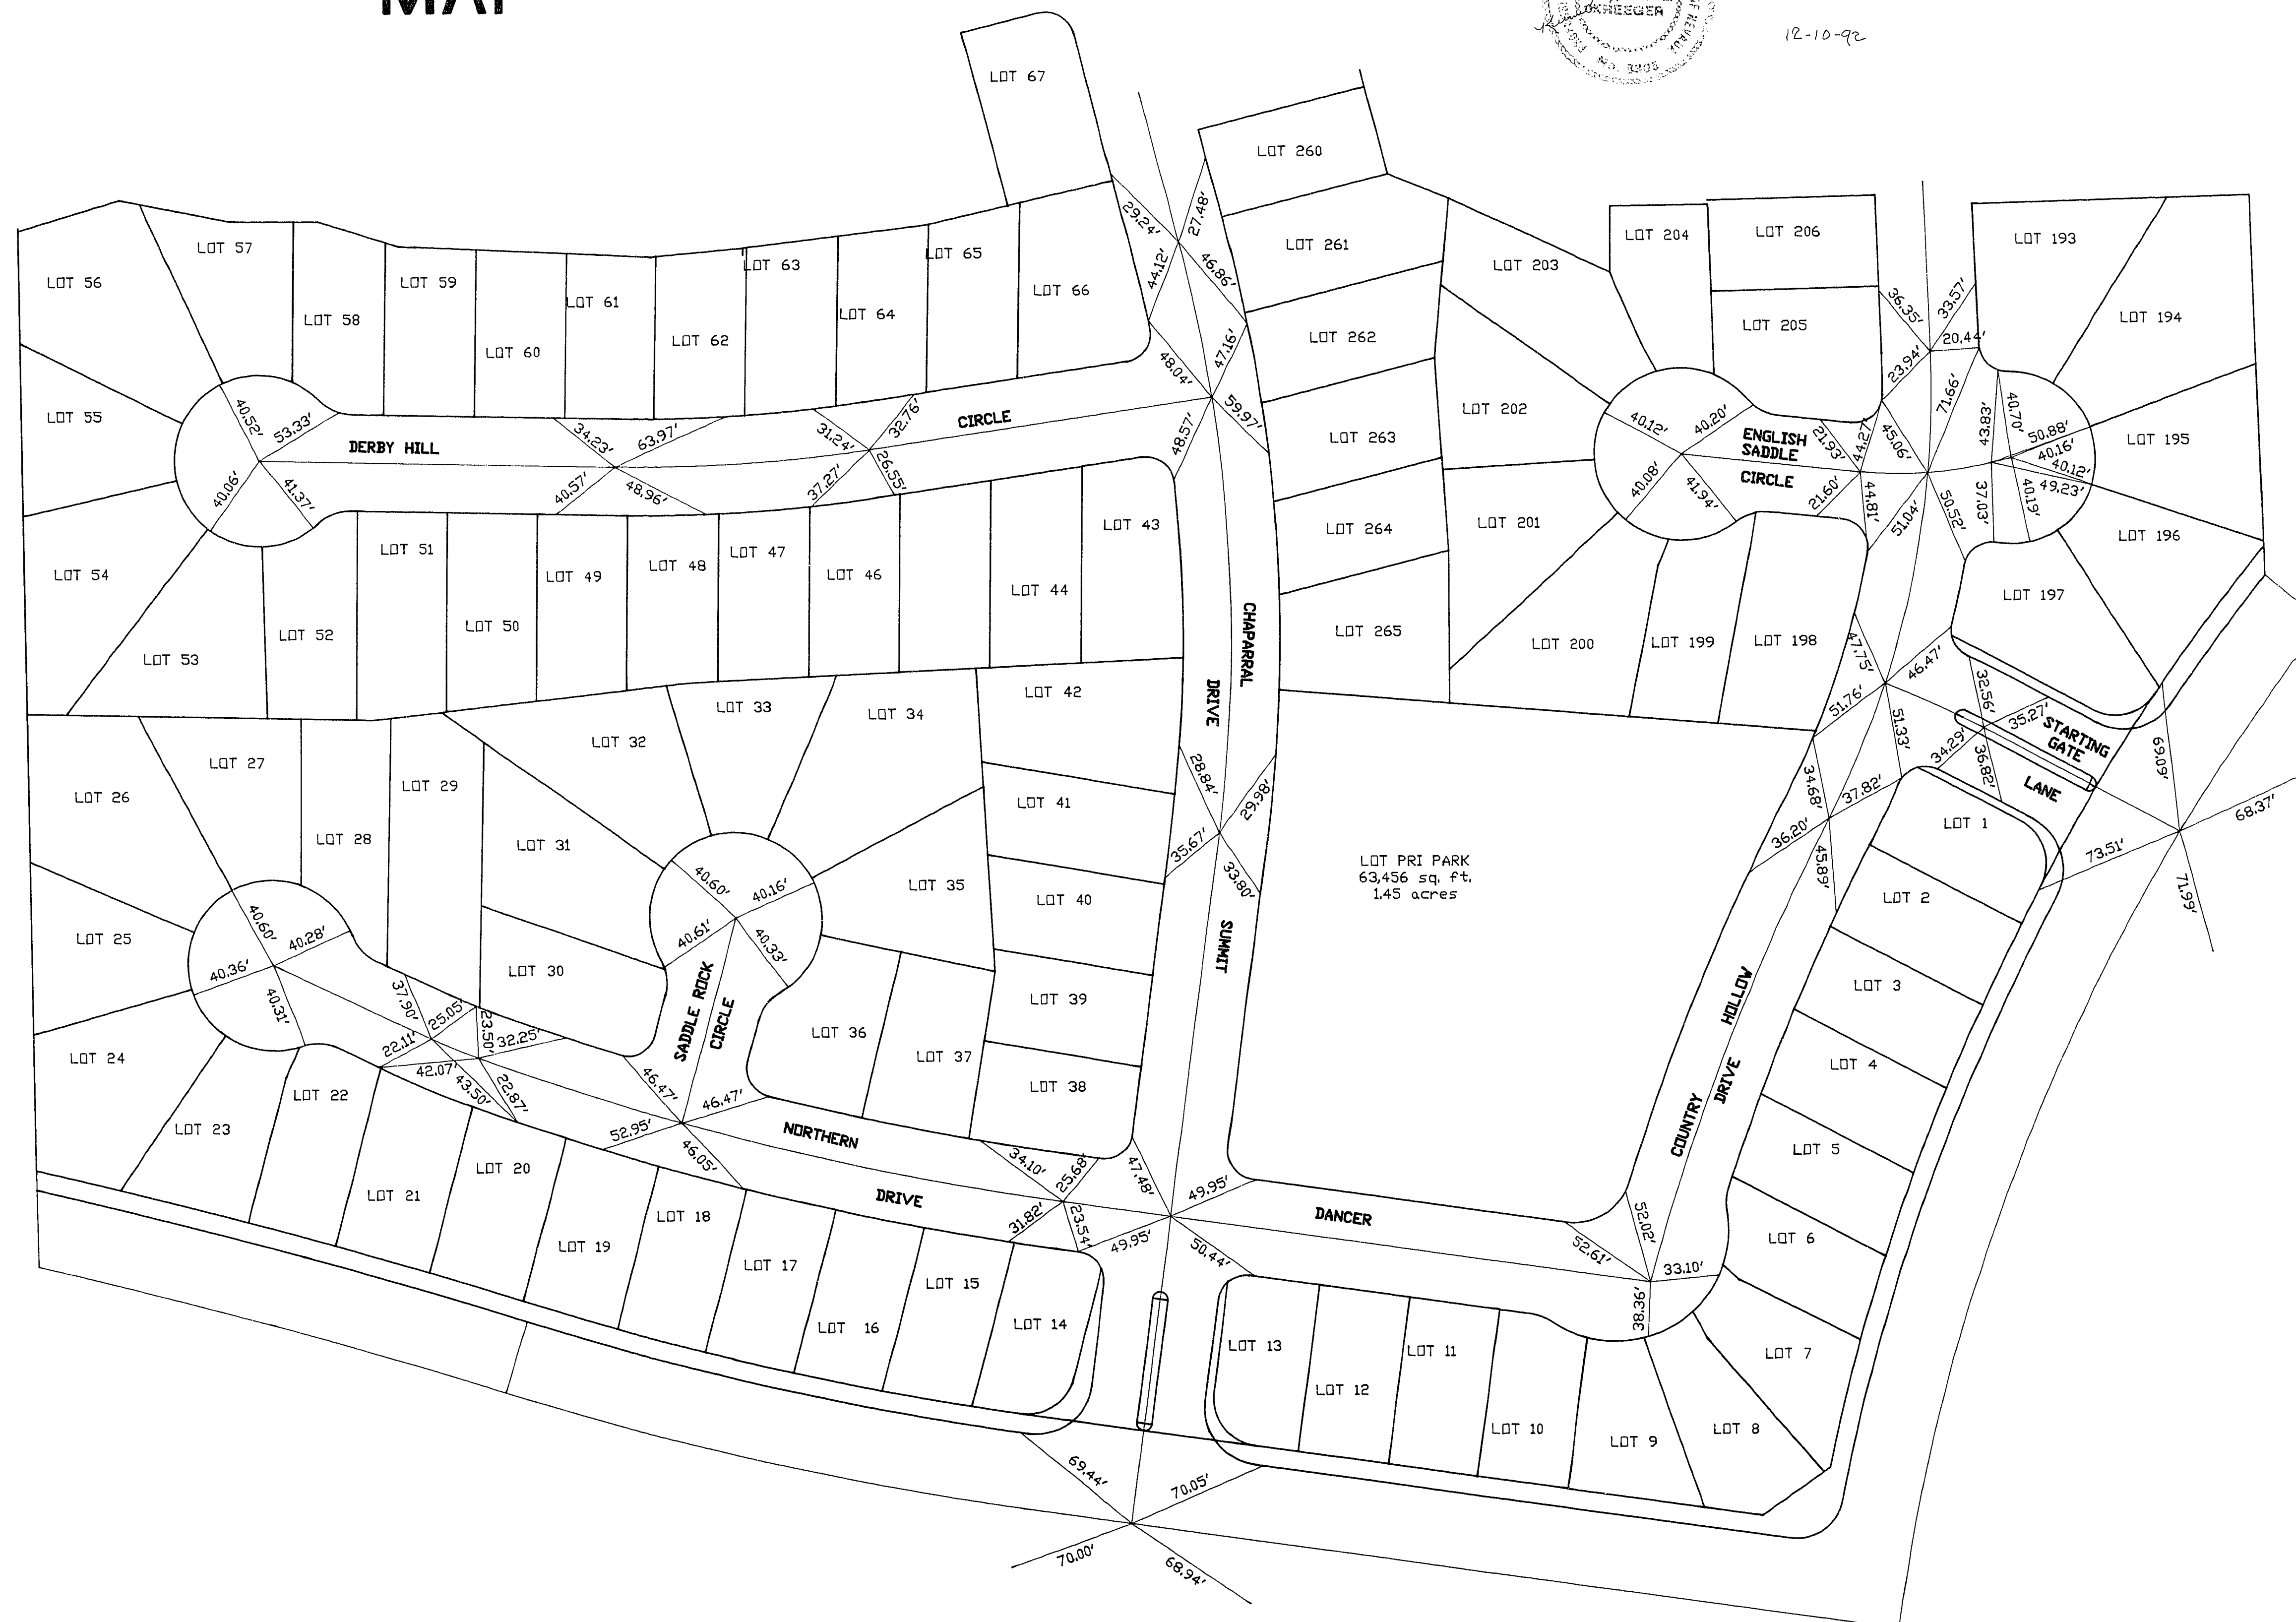

1" = 50'