


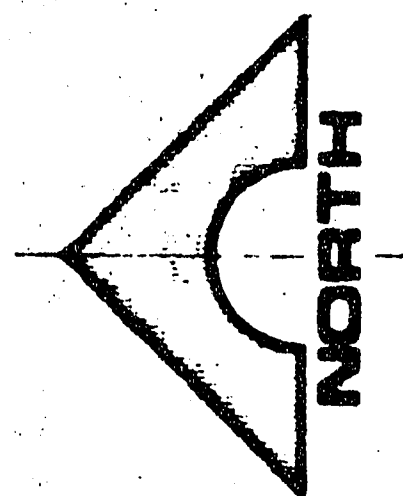

SCALE: 1" = 40'

MARION ESTATES

A SUBDIVISION

A PORTION OF THE NW 1/4 OF THE NW 1/4 OF
THE NE 1/4 OF SECTION 32, T.20S., R. 62E., M.D.B. 8M.

MONUMENT TIES MAP

