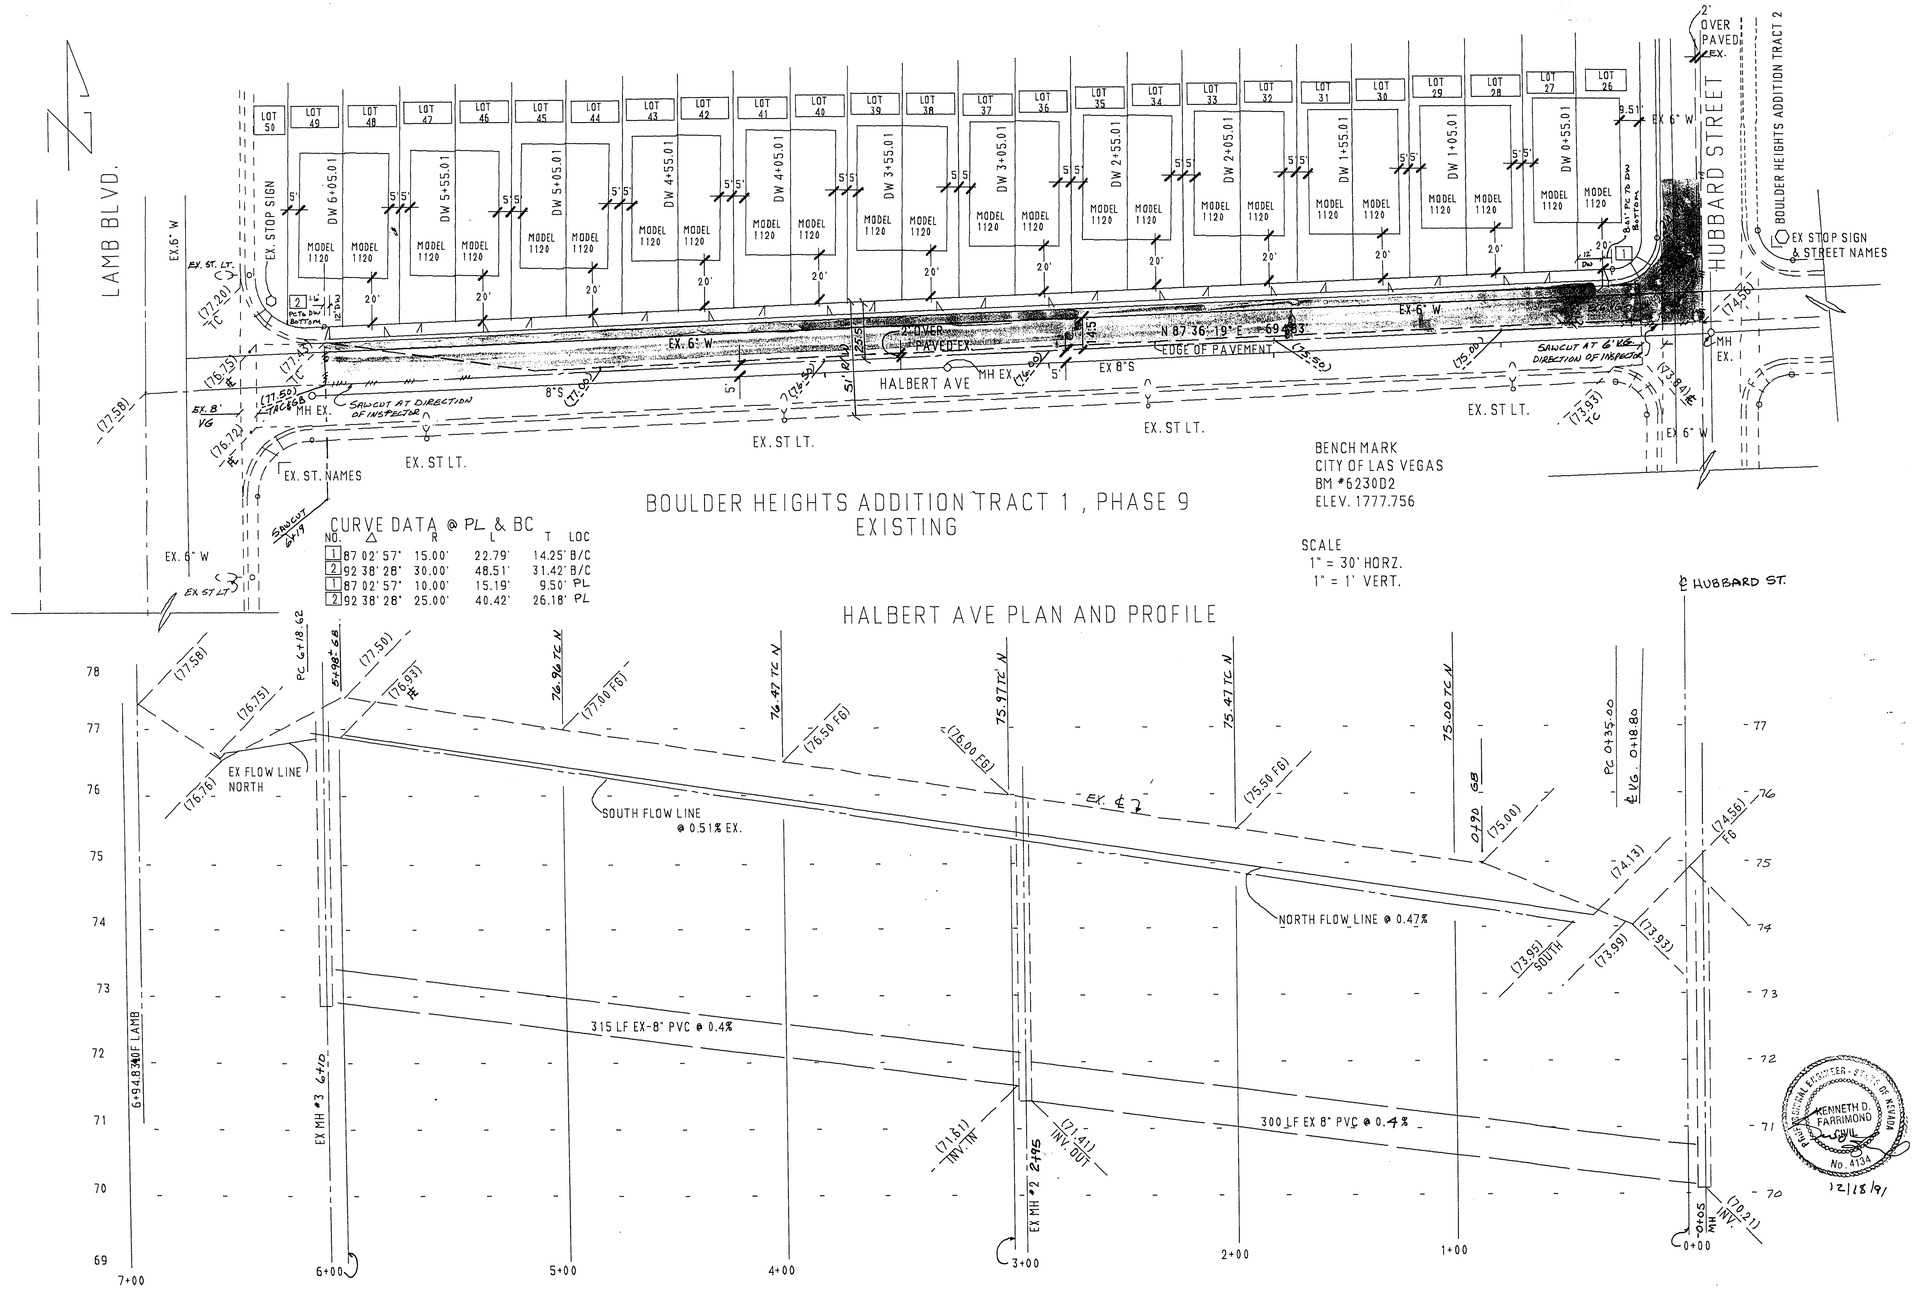

CURVE DATA @ PL & BC

NO.	Δ	R	L	T	LOC
1	87 02' 57"	15.00'	22.79'	14.25'	B/C
2	92 38' 28"	30.00'	48.51'	31.42'	B/C
1	87 02' 57"	10.00'	15.19'	9.50'	PL
2	92 38' 28"	25.00'	40.42'	26.18'	PL

REVISIONS

DATE	DESCRIPTION	APPR

KENNETH D. FARRIMOND, PE., PLS.
4160 PECOS ROAD
Las Vegas, Nevada
434-7366
ENGINEERS & SURVEYORS

BOULDER HEIGHTS ADDITION TRACT 1, BLOCK A, PHASE 10
HALBERT AVE PLAN & PROFILE
STREET AND SEWER DESIGN

DRAWN BY: PHIL
SCALE: AS SHOWN

SHEET NO.
5
OF
6

1074-980 A-1-11

21.6-57