
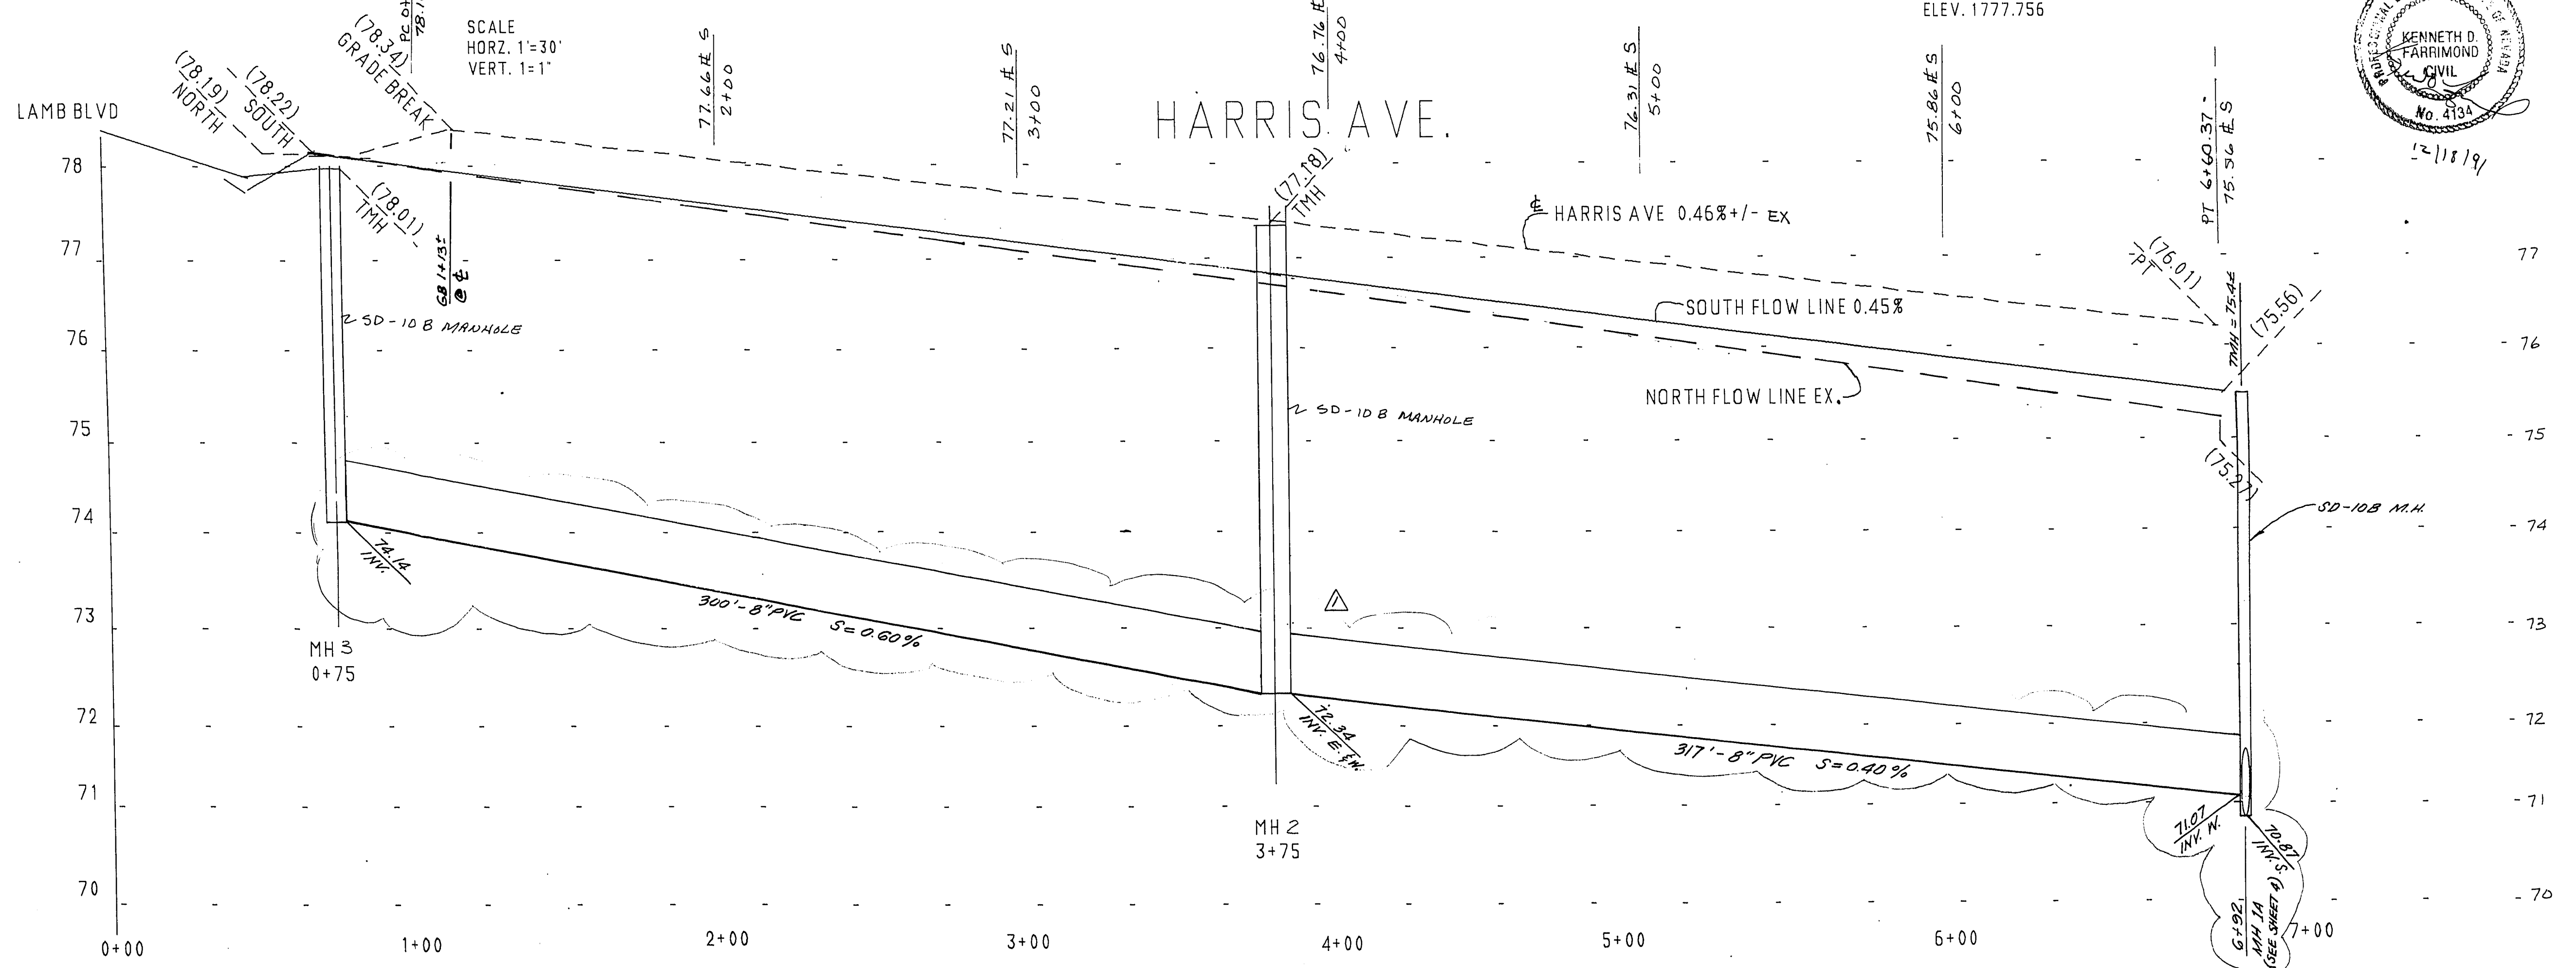
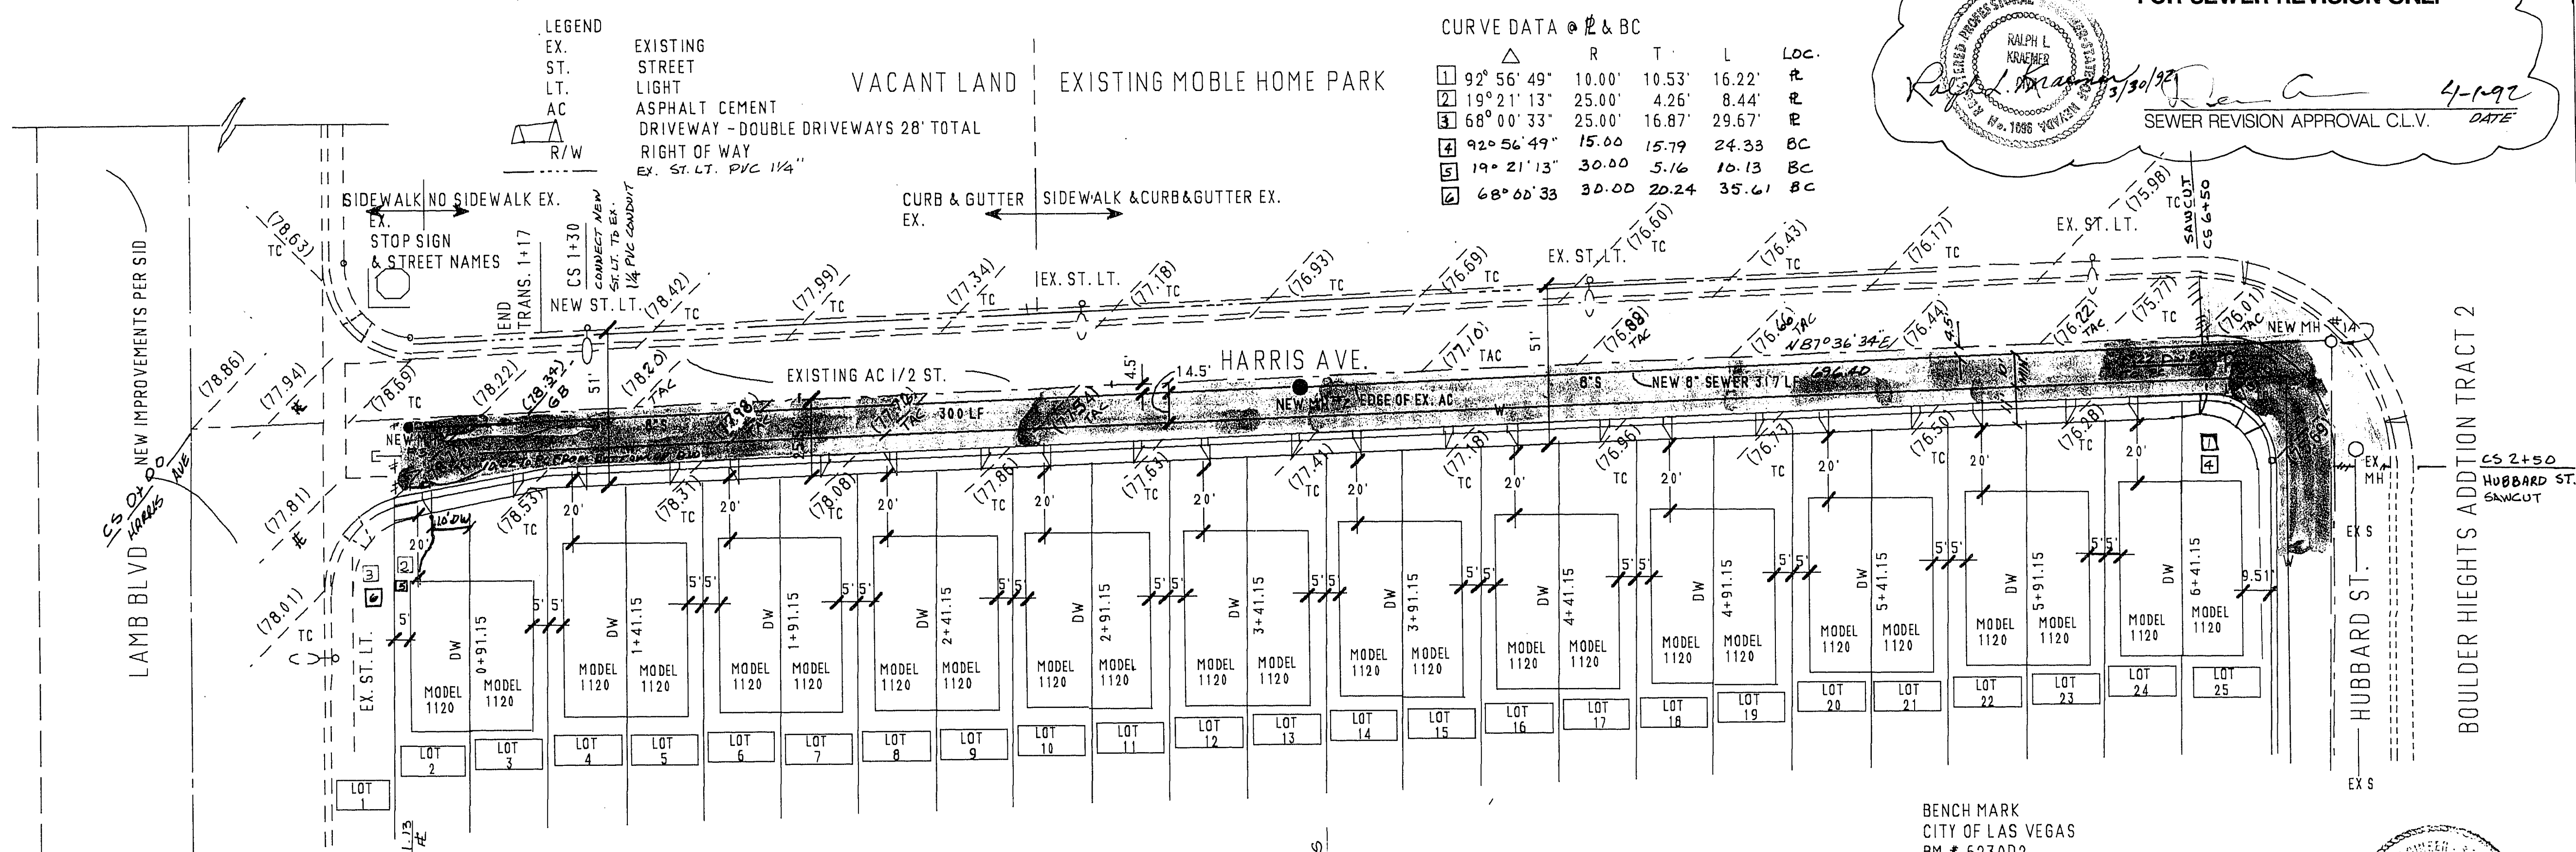


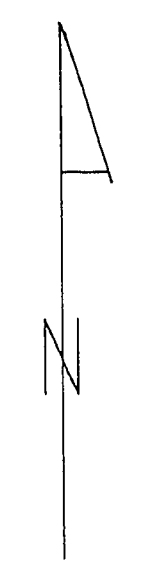

REVISIONS		
DATE	DESCRIPTION	APPR.

KENNETH D. FARRIMOND, P.E., PLS.
4160 PECOS ROAD
Las Vegas, Nevada
434-7366
ENGINEERS & SURVEYORS

BOULDER HEIGHTS ADDITION, TRACT 1, BLOCK A PHASE 11
HARRIS AVENUE PLAN & PROFILE
STREET & SEWER DESIGN
STREET LIGHT

DRAWN BY: C GREEN
SCALE: 1"=30'

SHEET NO.
6
OF
6

1074-980A-1-11
21-6-98