


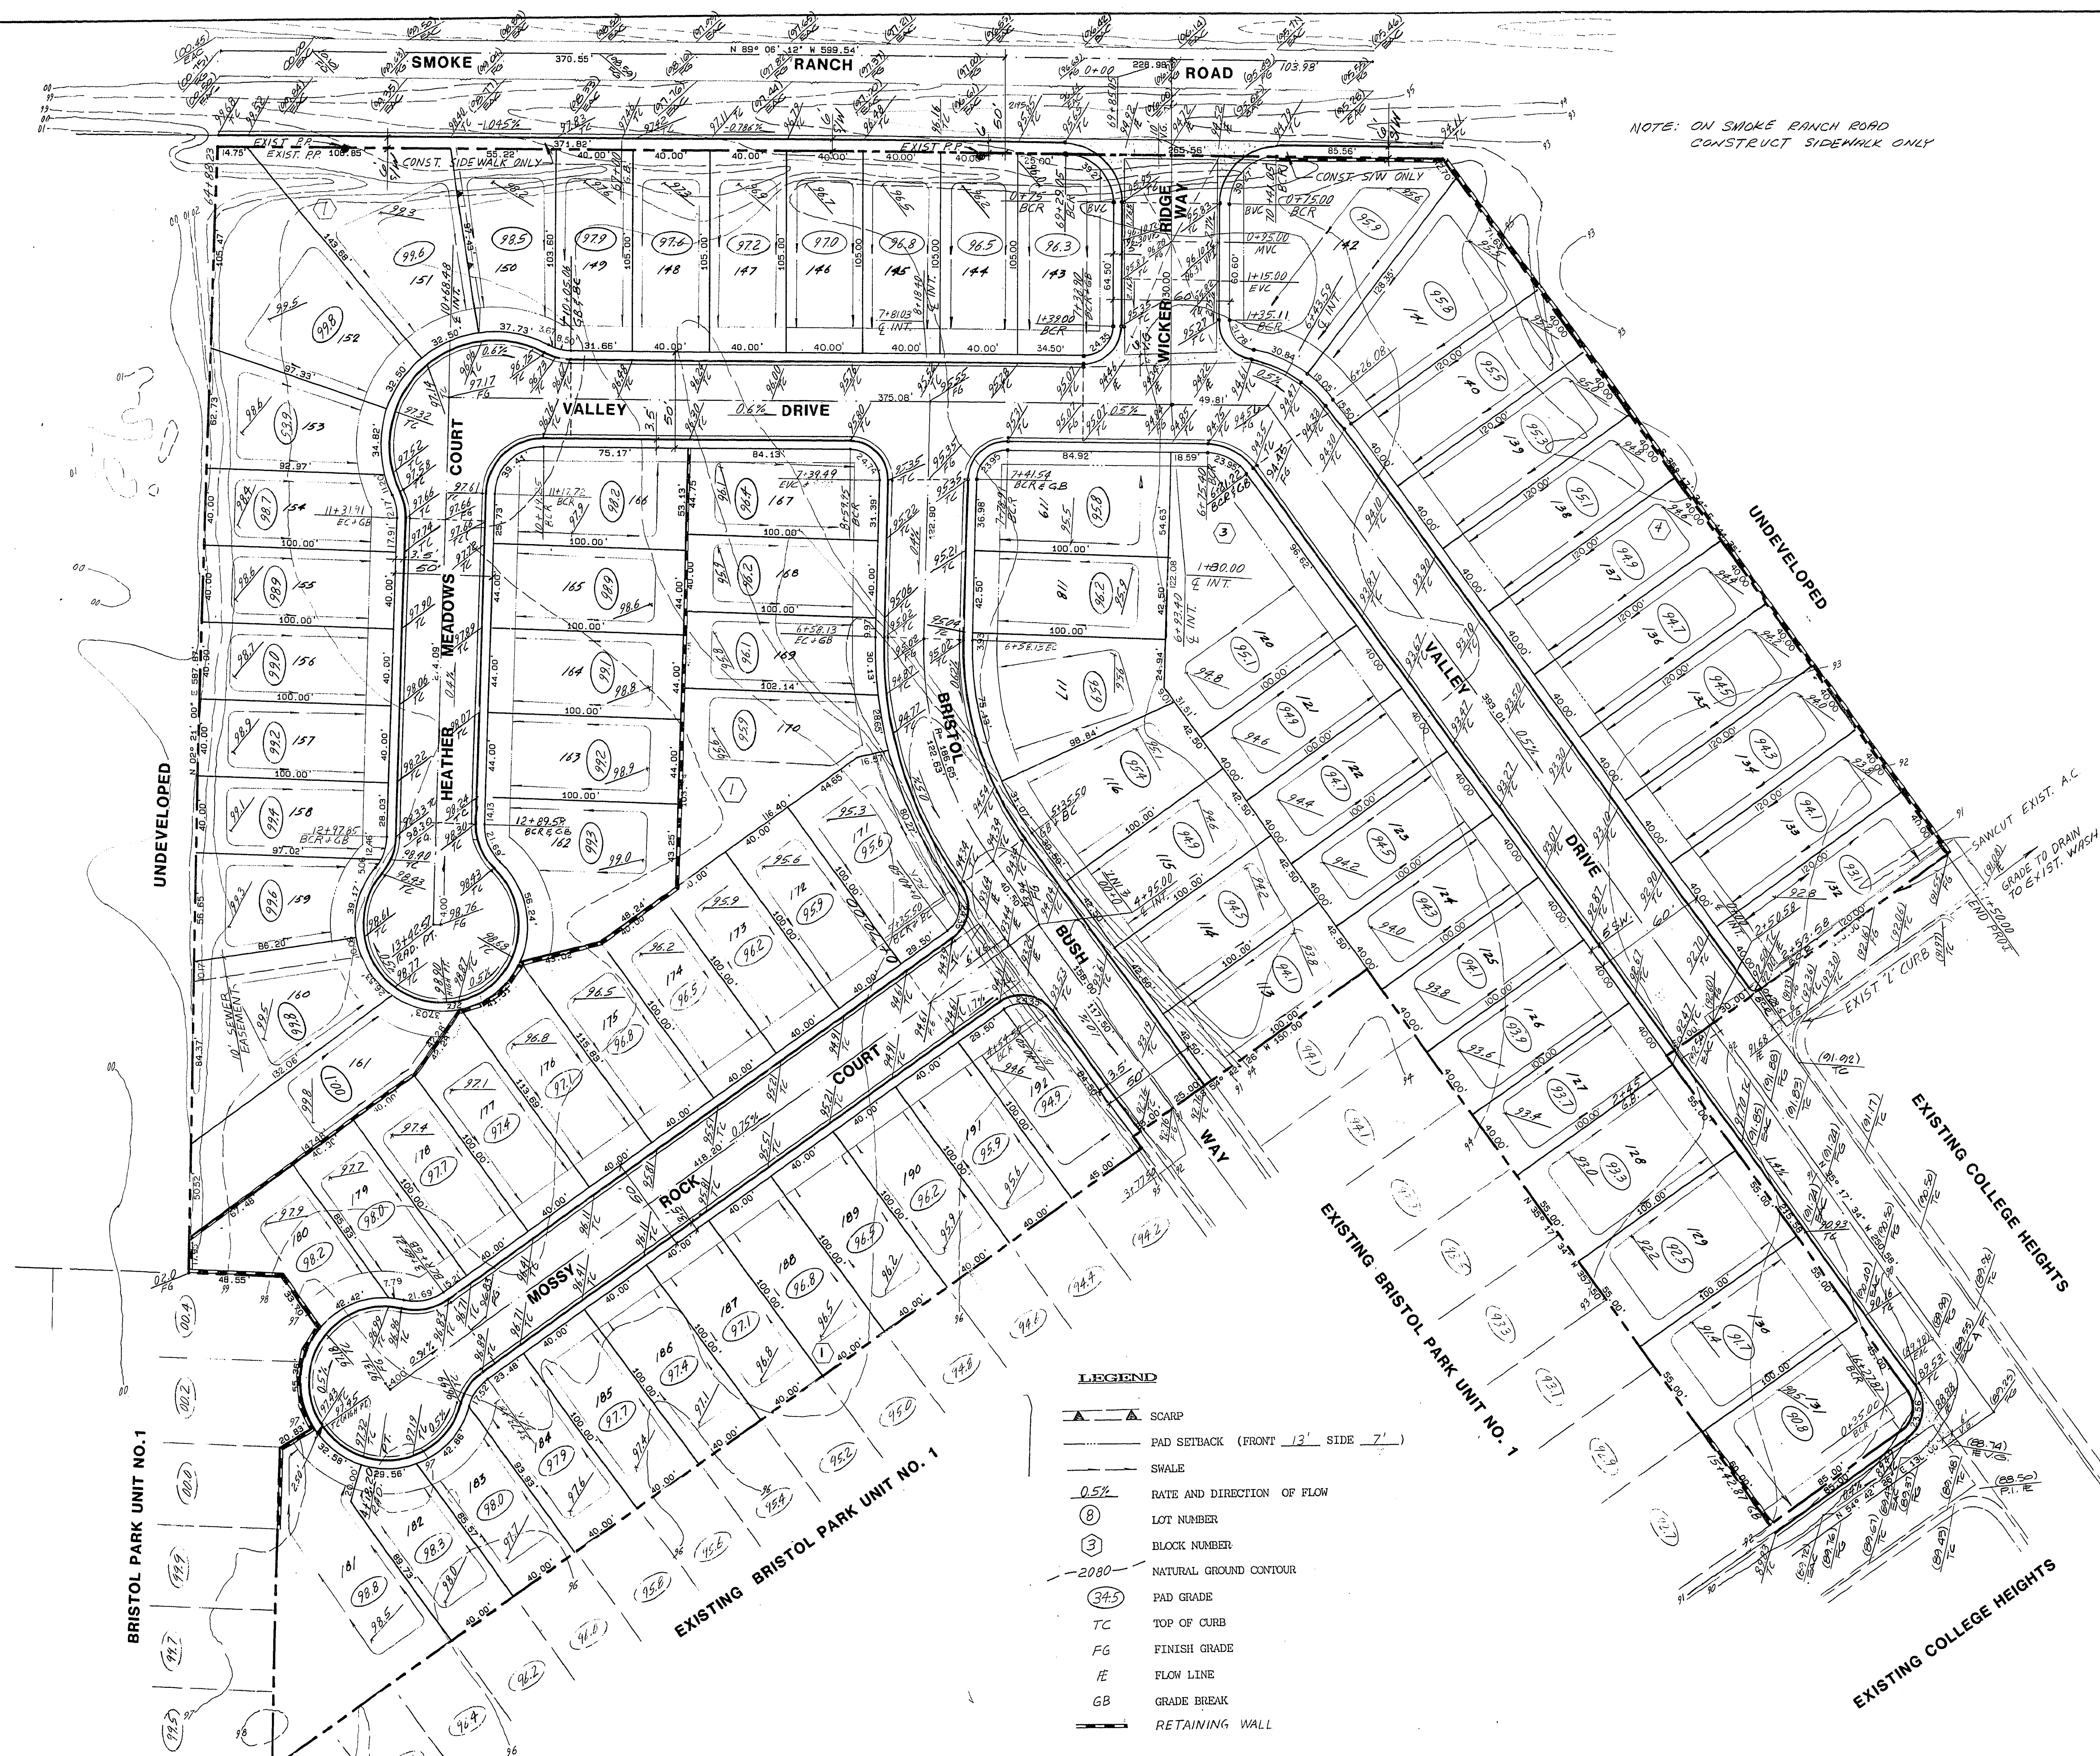

REVISION			
REV	DATE	BY	DESCRIPTION
1	6/11/87	G.S.	ADDED STATIONS AND GRADES
2	6/22/87	G.S.	REVISED LOTS AND WALLS AND NOTES
3	6/16/87	DA	GRADE DRAINAGE REVISIONS
4	7/18/87	G.S.	CHANGED GRADES ON WICKER RIDGE WAY

ESI ENGINEERS & SURVEYORS INC.

SUBMITTED BY: *Paul E. Allen* 5/21/87

TITLE: **ROUGH GRADING PLAN**

PROJECT: **BRISTOL PARK UNIT NO. 2**

WO NO: 4-060

BY: G.S.

DATE: 4/87

SCALE: 1"=40'

SHEET: 11

OF 11 SHEETS