


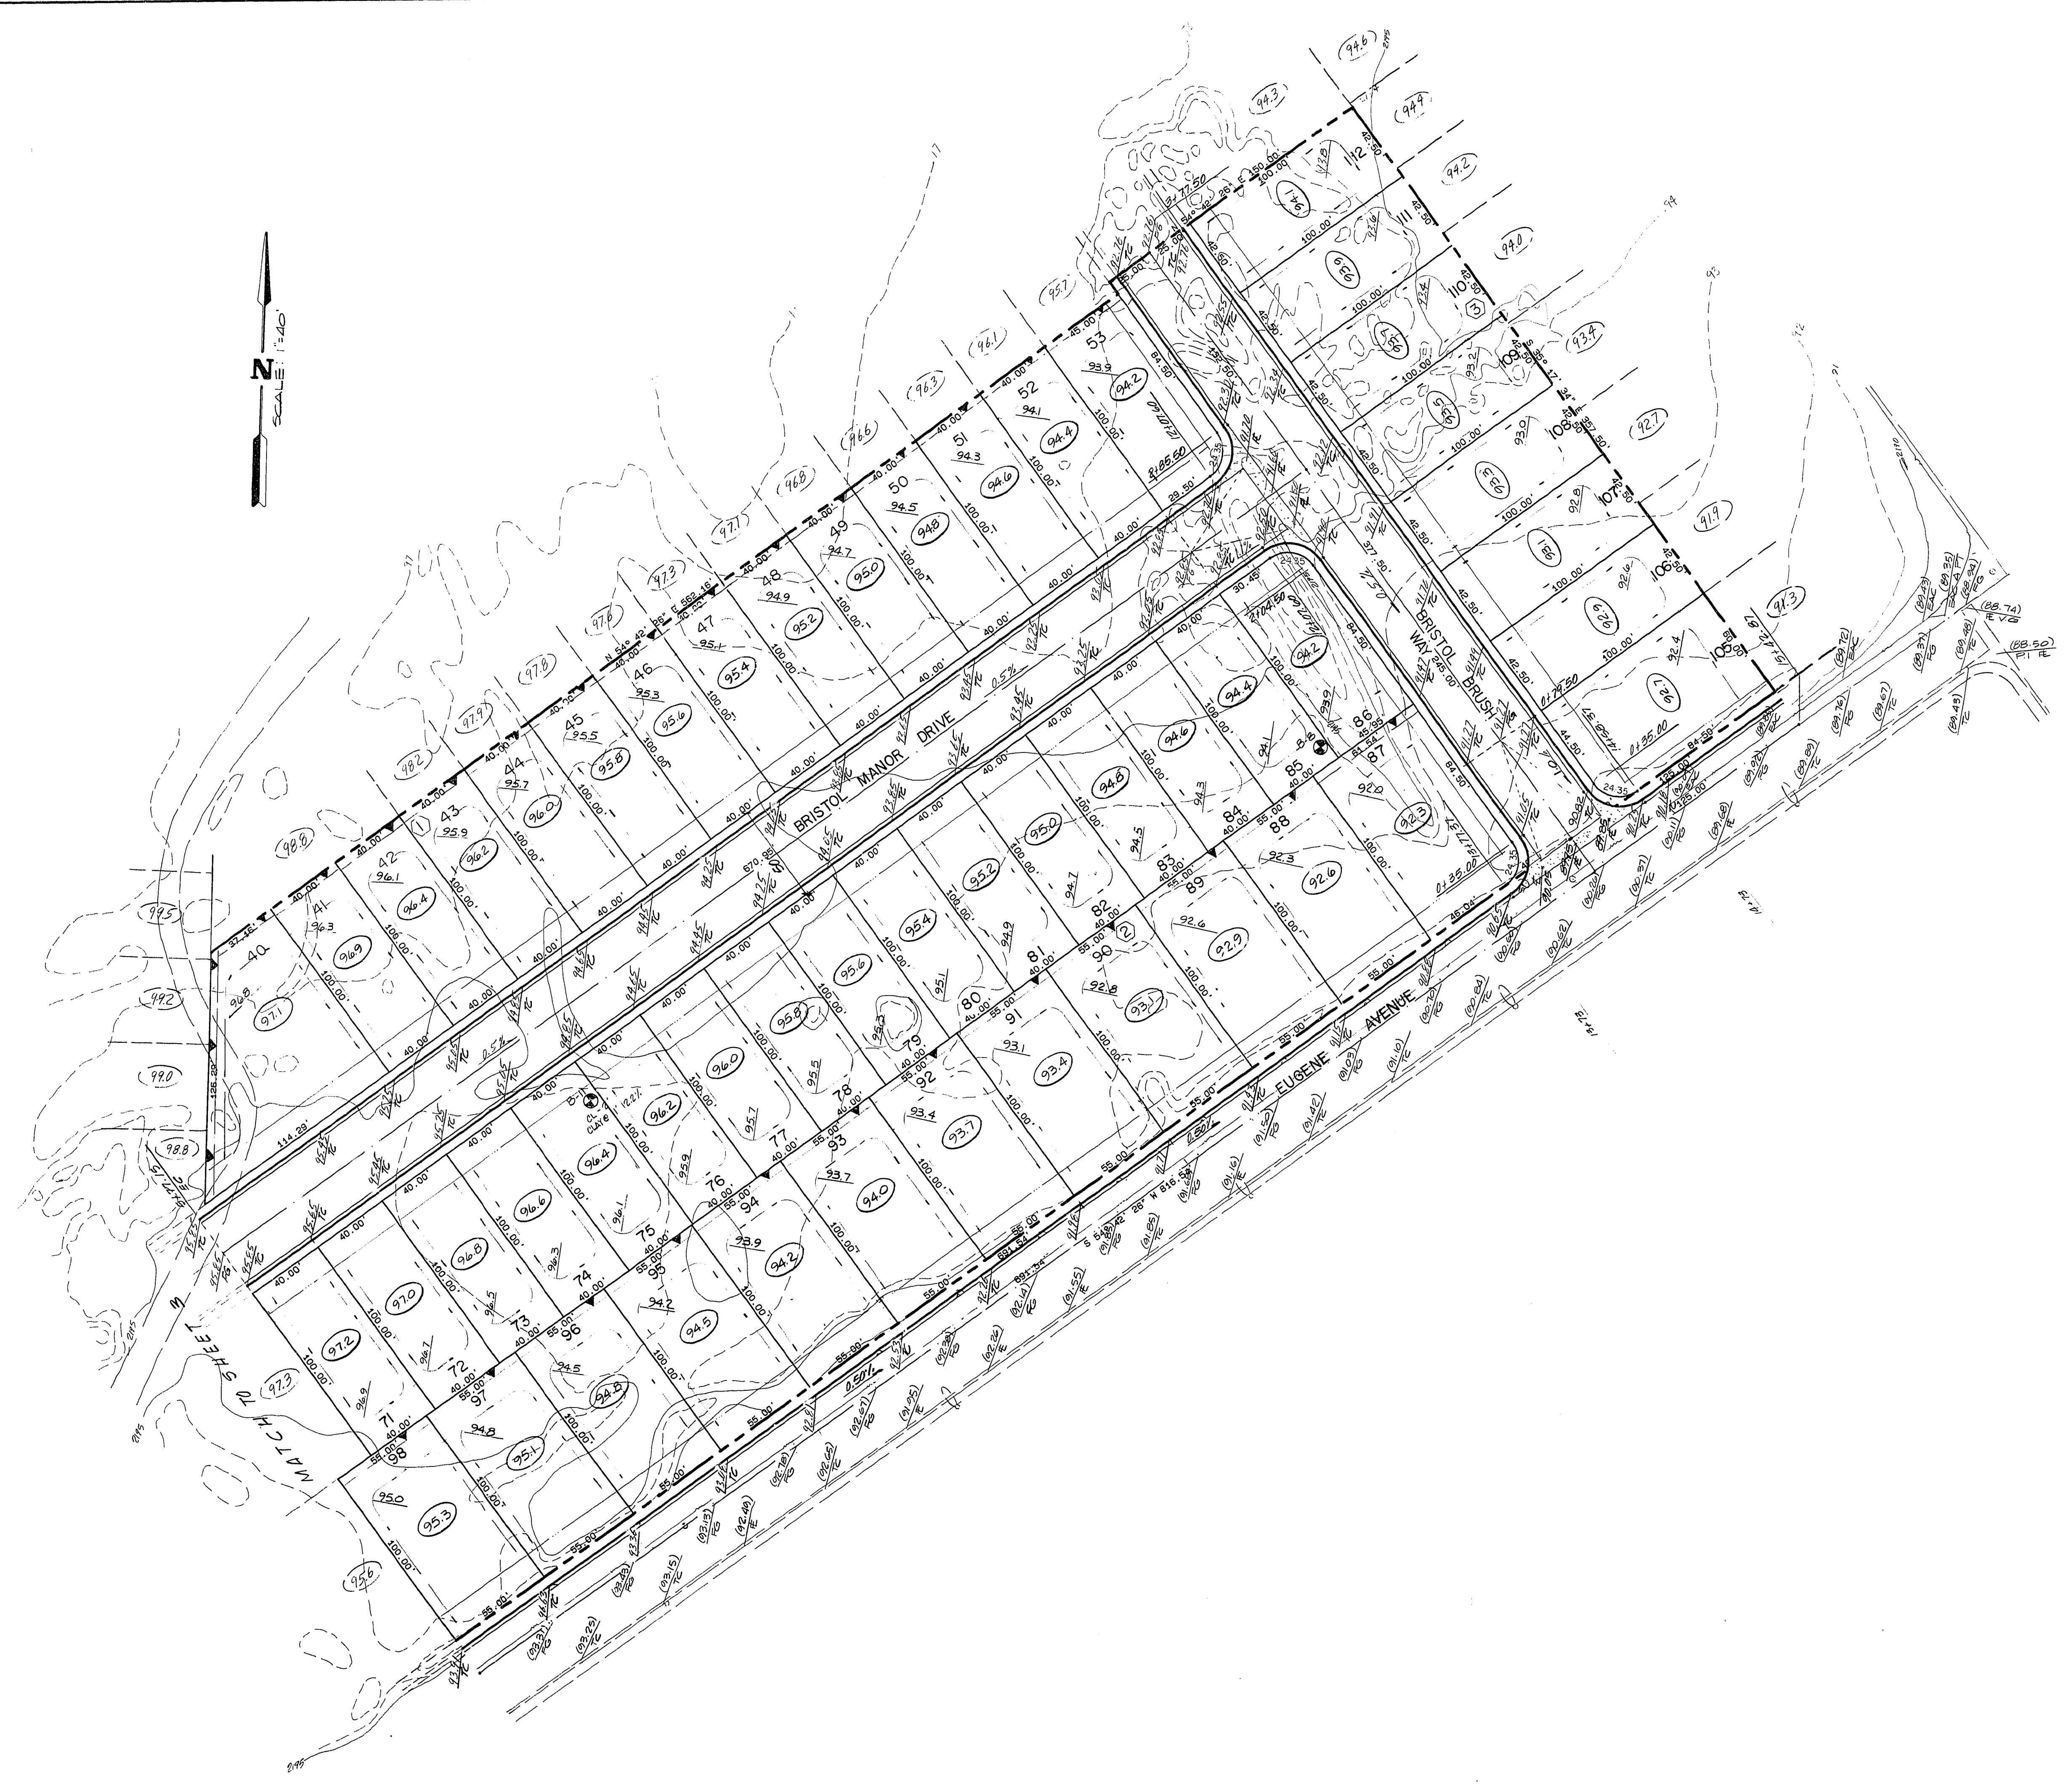

ENGINEERS & SURVEYORS INCORPORATED		7022 W. CHARLESTON BLVD. LAS VEGAS, NEVADA 89117 PHONE 702 / 363-6415		REVISION REV. DATE BY TB 1-5-87	
SUBMITTED BY: <i>Paul E. Valentine</i>		PAUL E. VALENTINE D.P.S.			
TITLE ROUGH GRADING PLAN				PROJECT BRISTOL PARK UNIT NO. 1	
WO NO. 4056				BY P. VALENTINE	
DATE 7/80				SCALE 1"=40'	
SHEET 4				OF 17 SHEETS	

Paul E. Valentine 10-16-86