


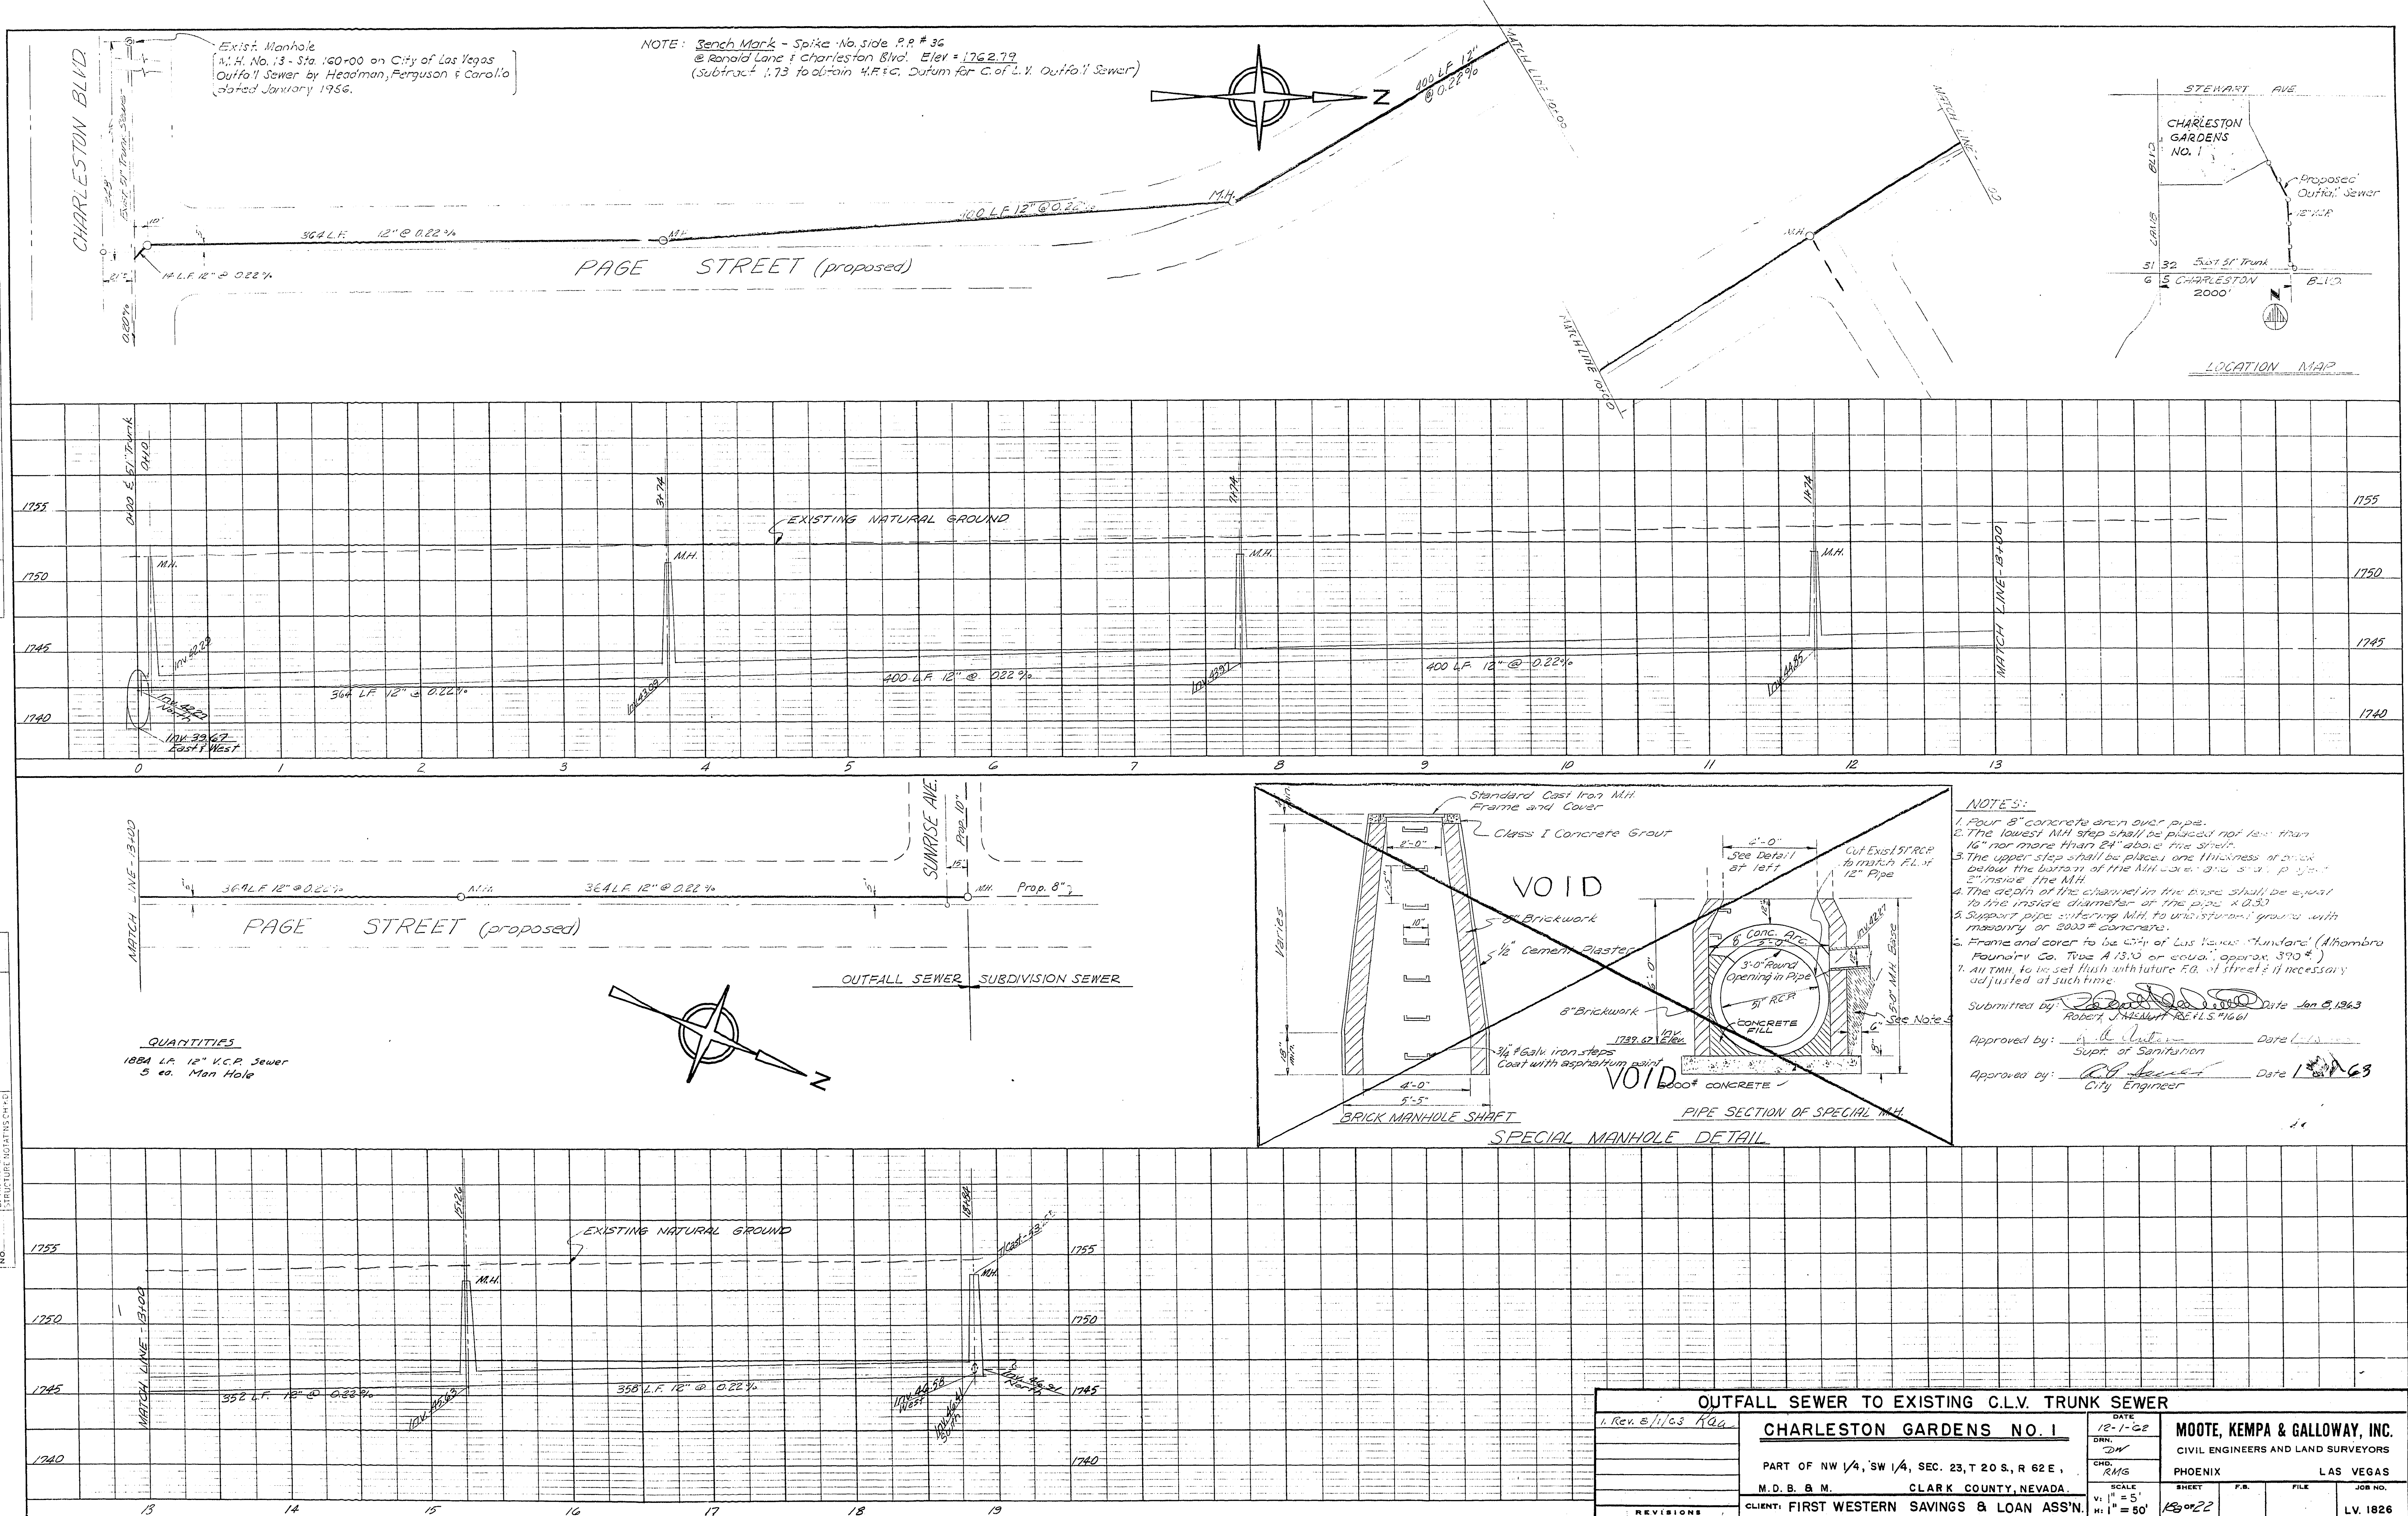

OUTFALL SEWER TO EXISTING C.L.V. TRUNK SEWER			
1. Rev. 2/1/63 RGA	DATE 12-1-62 DW RMS	CHARLESTON GARDENS NO. 1	
PART OF NW 1/4, SW 1/4, SEC. 23, T 20 S, R 62 E, M.D.B. & M. CLARK COUNTY, NEVADA.		MOOTE, KEMPA & GALLOWAY, INC. CIVIL ENGINEERS AND LAND SURVEYORS PHOENIX LAS VEGAS	
CLIENT: FIRST WESTERN SAVINGS & LOAN ASS'N.	SCALE V.I. 1" = 5' H.I. 1" = 50'	SHEET 183 of 22	JOB NO. LV. 1826

3074-1039-1

24-6-43