
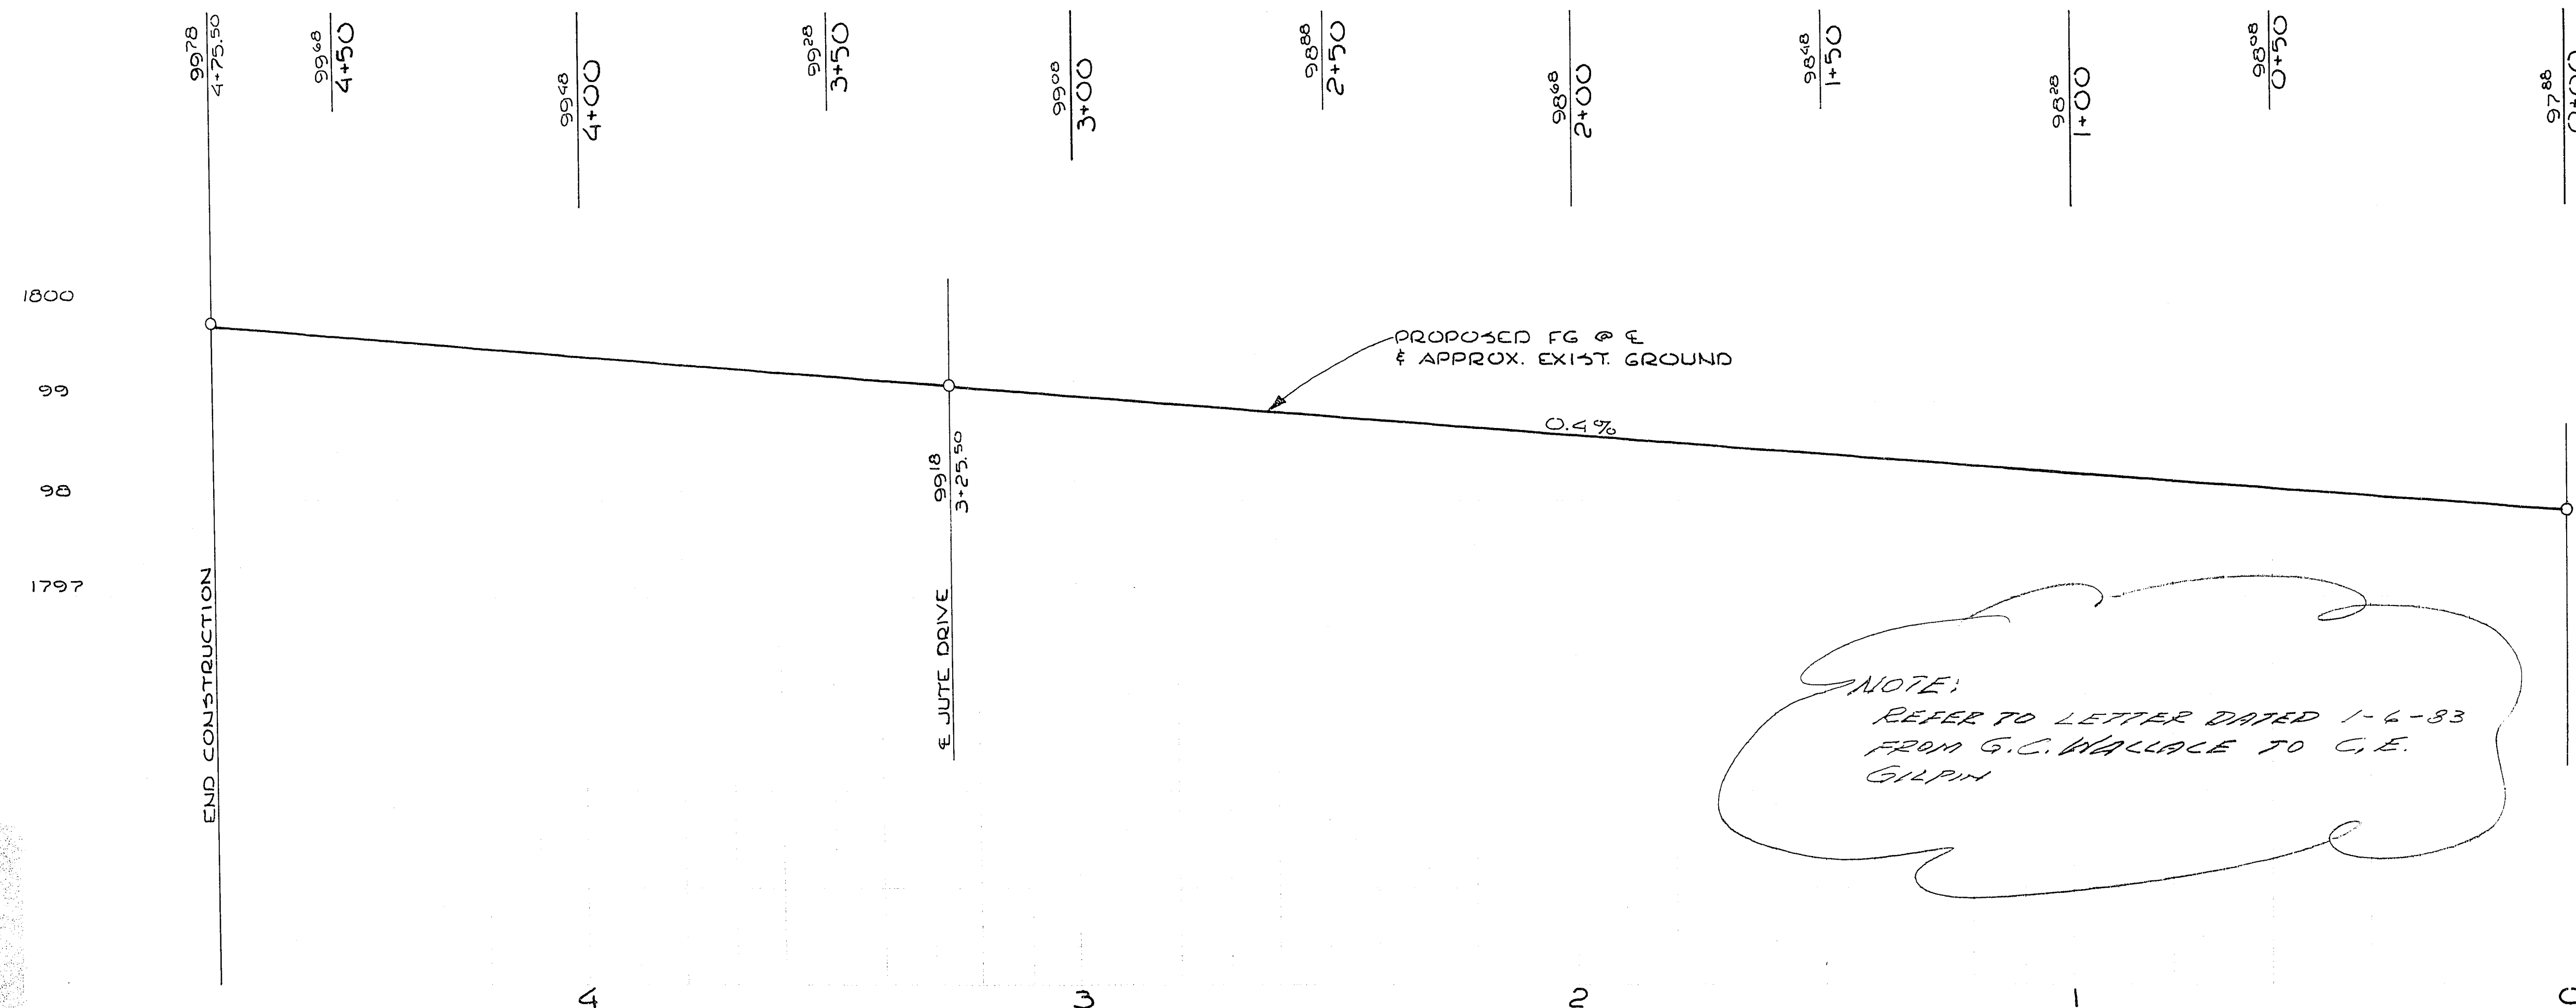
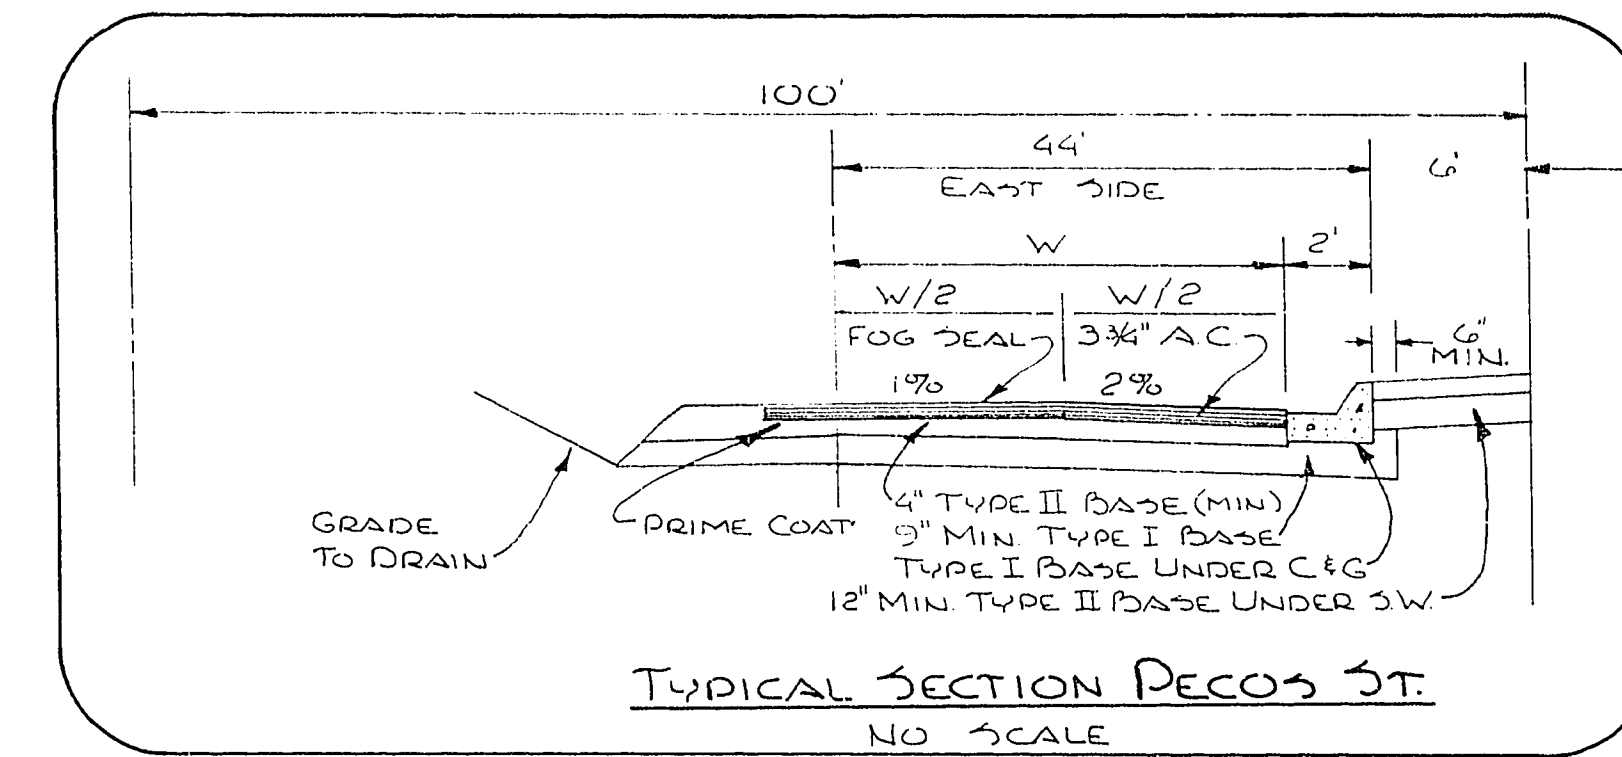


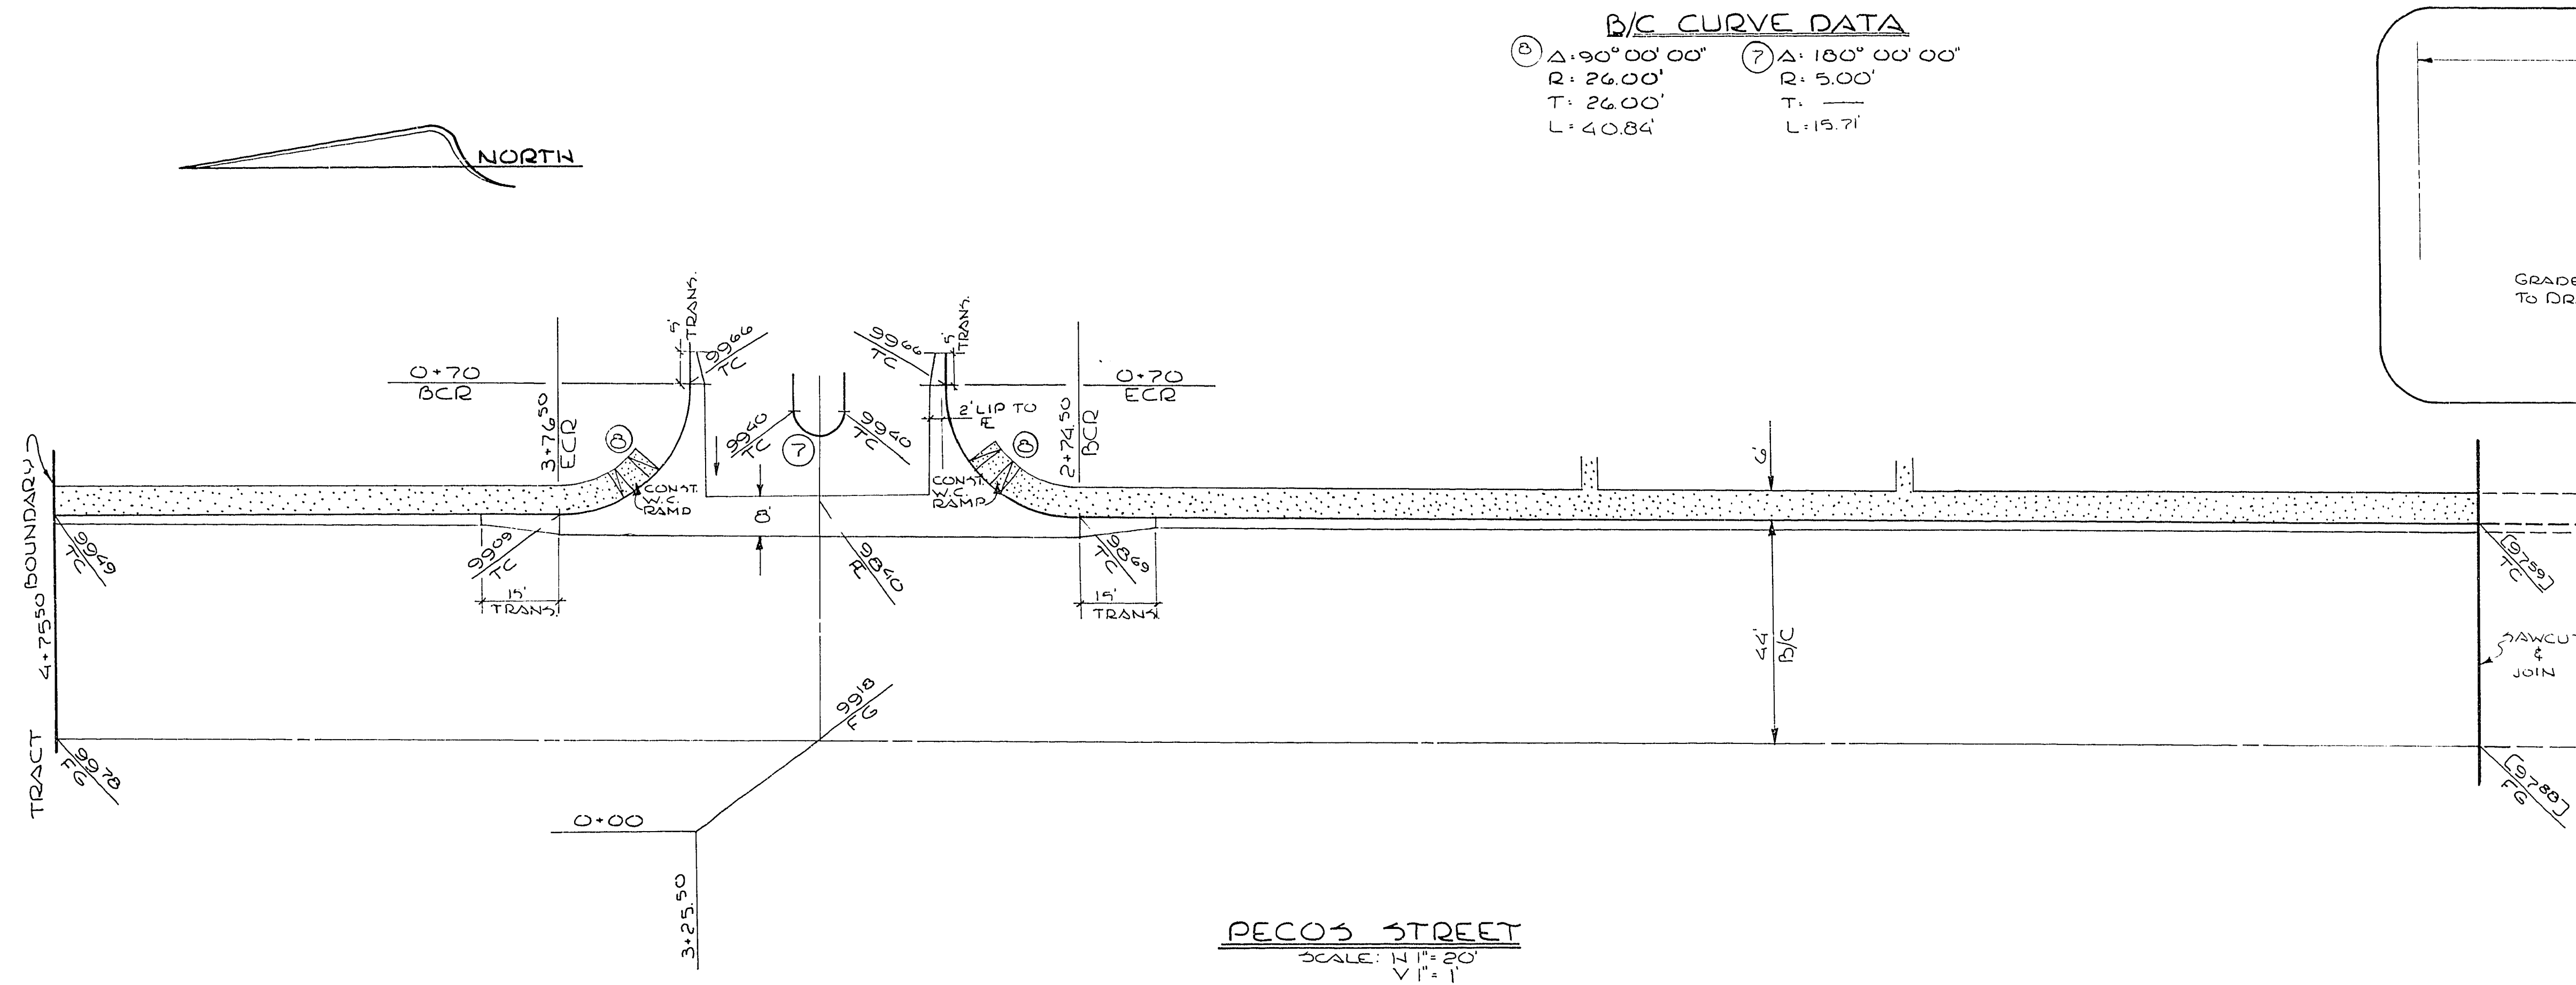

APPROVALS:

CLV CITY ENGINEER	DATE
CLV QUALITY ENGINEER	DATE
CLV CHIEF LAND DEV. & FLOOD CONTROL	DATE
CLV TRAFFIC ENGINEER	DATE

SUBMITTED BY:

MARK L. RUBY, R.P.E. No 1726
DATE

ATRIUM GARDENS IV
PECOS STREET
PLAN & PROFILE

L.R.K. SH. 2 OF 6

NOTE:
REFER TO LETTER DATED 1-6-83
FROM G.C. WALLACE TO G.E.
GARPIN

1074-839-4