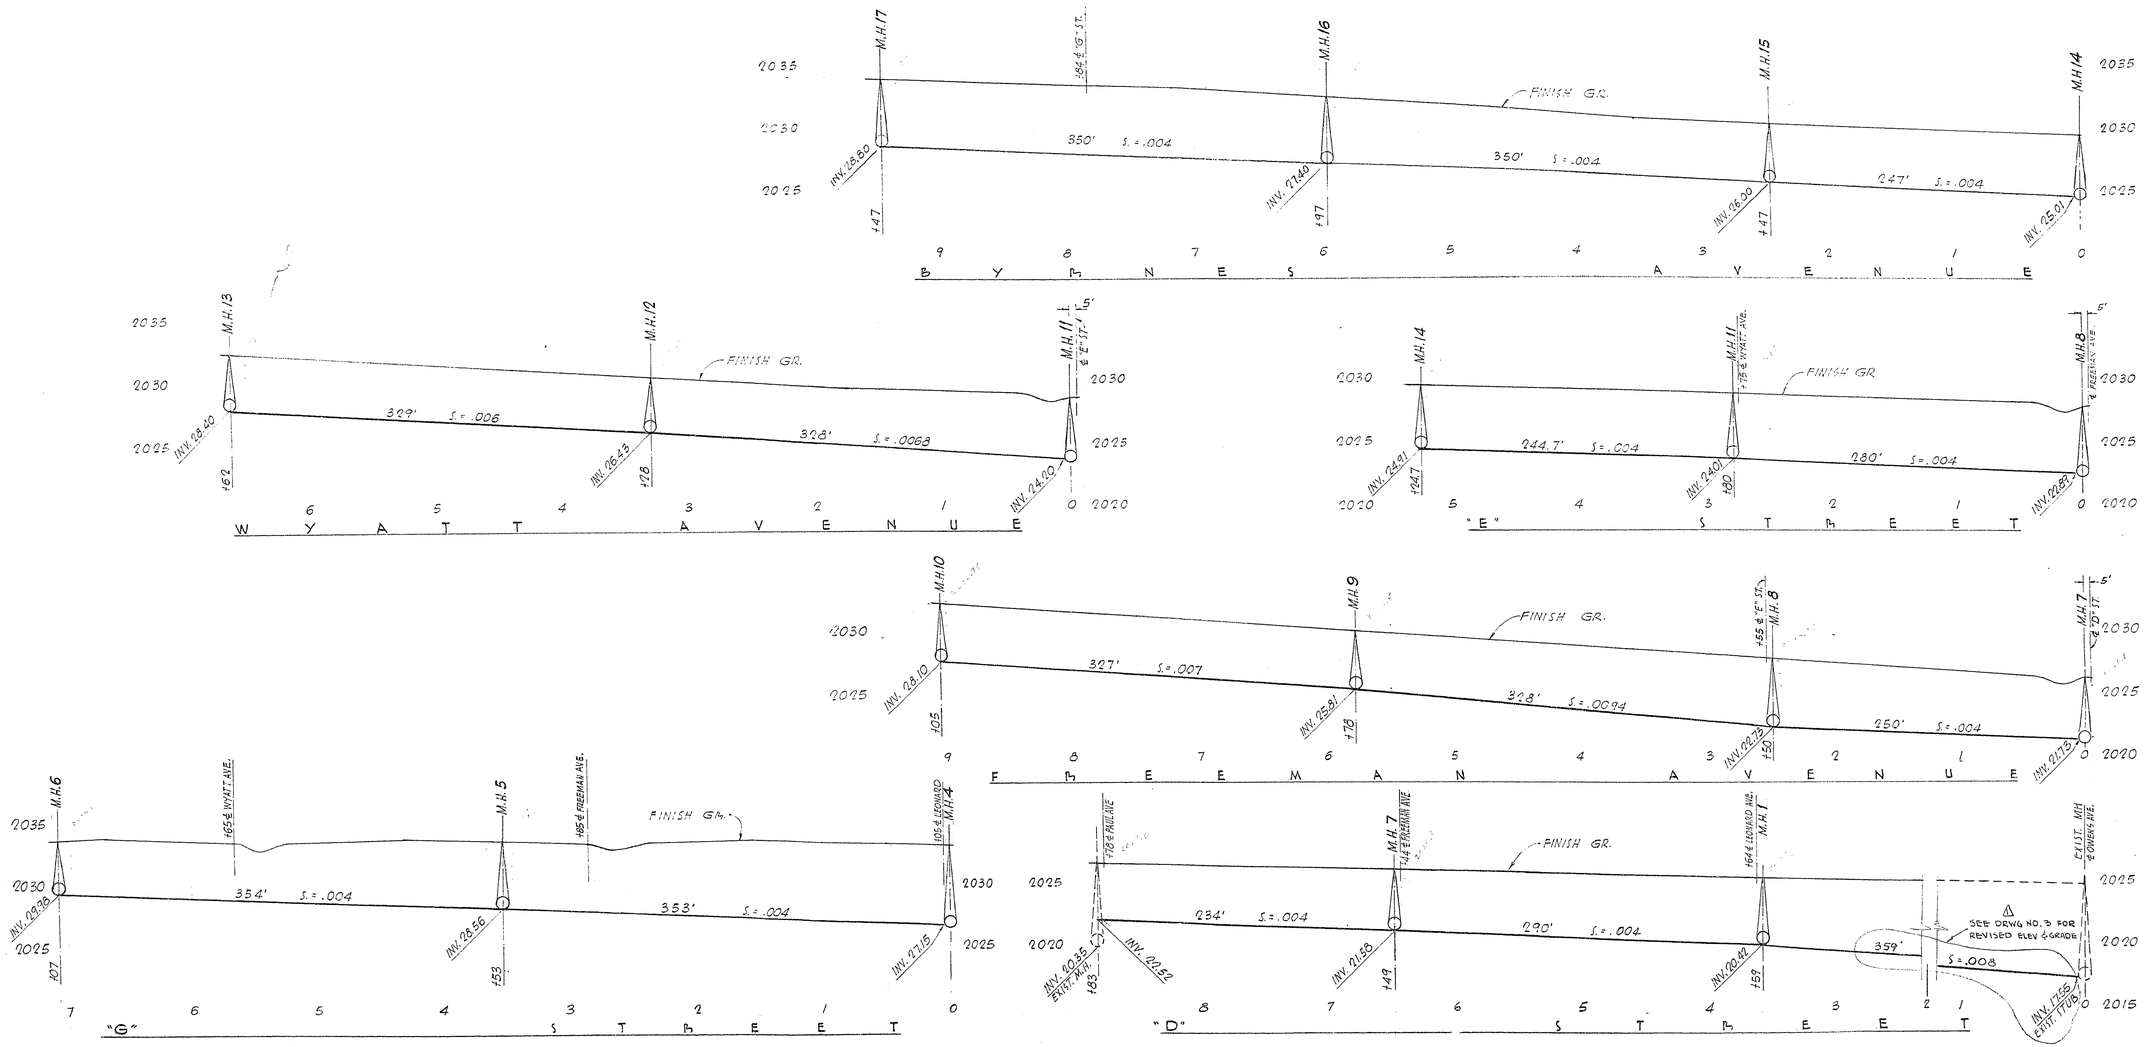

NOTE:
ALL SEWER PIPE TO BE 8" ø VITRIFIED CLAY.

C-3-2

△ 6/26/54 ADDED NOTE ON "D" STREET SEWER

PROFILE OF SEWERS

SEWERAGE SYSTEM
FOR
BERKLEY SQUARE
CITY OF LAS VEGAS • NEVADA

SCALE		
HORIZ. 1"=50' VERT. 1"=5'	PENLITER & SOHING ENGINEERS	DRWG. NO. 2
DATE MAY 1954	448 SO. HILL LOS ANGELES	OF 3

APPROVED

307Y-890-1