


BEL AIR TRACT NO. 5

LAS VEGAS NEVADA

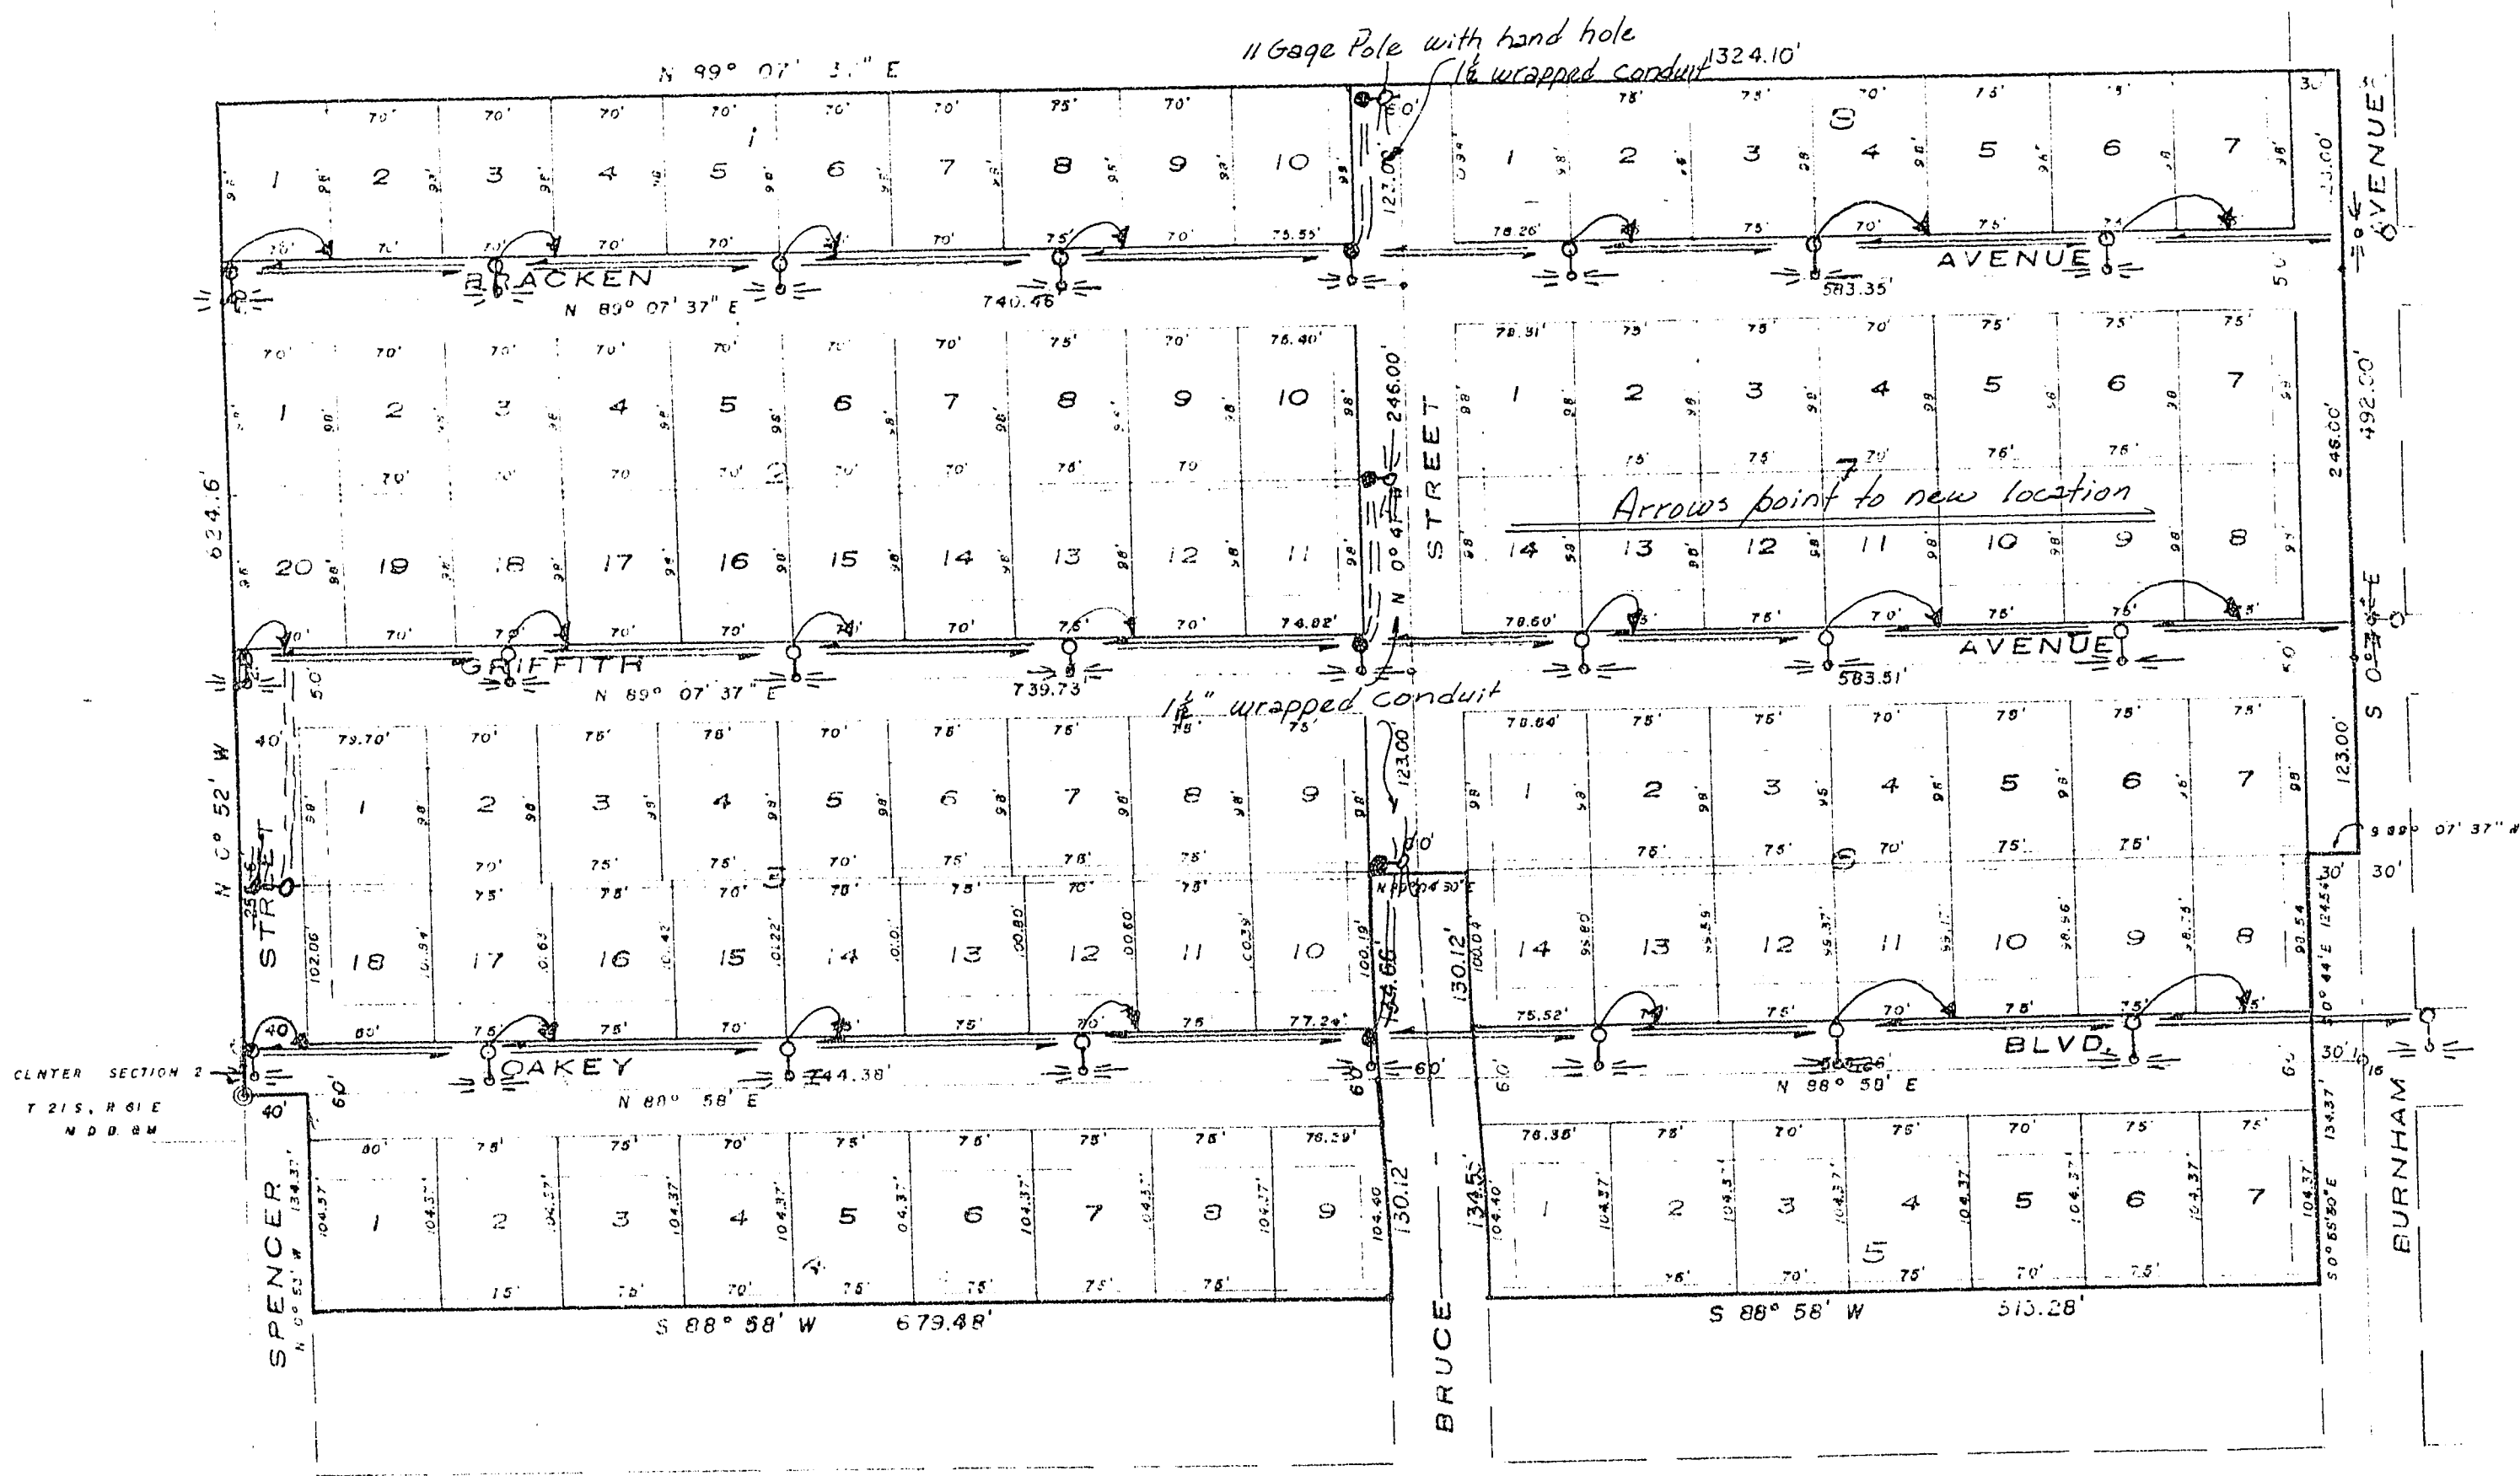

LEGEND

- Points of Bearing & Oakley BLVD.
- Concrete Monument Set
- Public Utility easements
- Block Number
- Street Line

SCALE 1 INCH = 100 FEET

STREET LIGHTING

SPECIFICATIONS

Lighting Standards shall be Pacific Union Metal design FB1130 B16 or FB 330 B16W mod L39 B 14 or approved equal.
Luminaire shall be Line Material Co. Catalog No. LC5 A31 with 2" slip fitter or approved equal.
with 2500 lumen lamp (RS35) 6.6 group replacement.
Luminaire shall be Type III distribution.
Wire shall be No 6 bare, medium hard drawn.
Wire from overhead line to luminaire shall be No. 8, type RR, 5000 volt.
Maximum pole spacing 180 feet.
Location of poles with respect to curb line shall be in accordance with C. L. V. Specifications.
Paint Poles
Comply with C.L.V. Standard Specifications.

LEGEND

- = 3 gage pole
- = 11 gage pole
- = Overhead line

APPROVALS

[Signature] City Engineer Date *11/17/60*
[Signature] City Electrician Date
[Signature] Southern Nevada Power Co. 5-3-60 Date

Approval of this plan by the City of Las Vegas, Nevada, does not relieve the Subdivider of responsibility in consultation, design, or planning by the Subdivider, Surveyor.

CITY OF LAS VEGAS
ENGINEERING DEPT.

2074-870-5
16-6-47