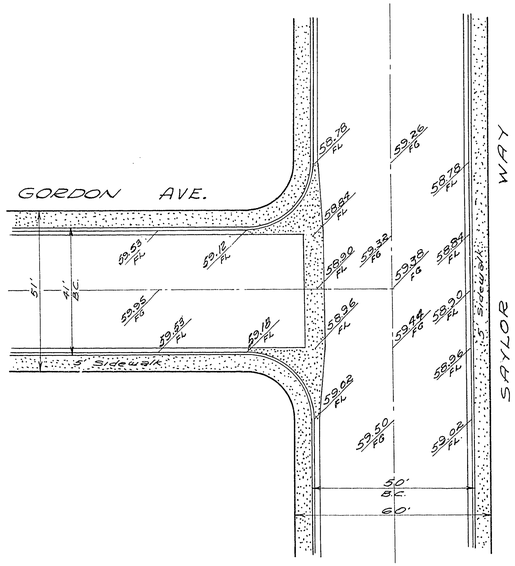

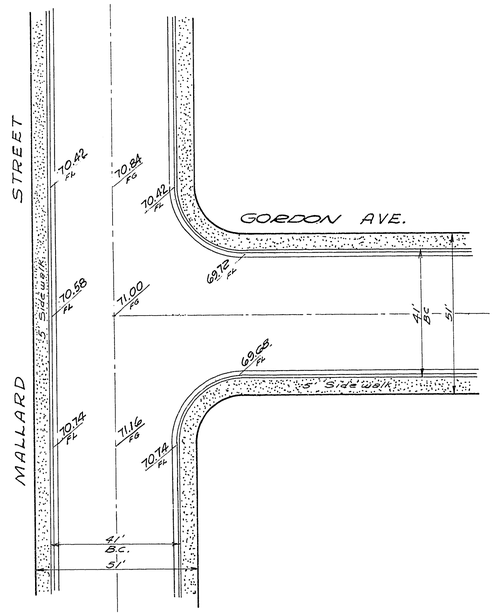

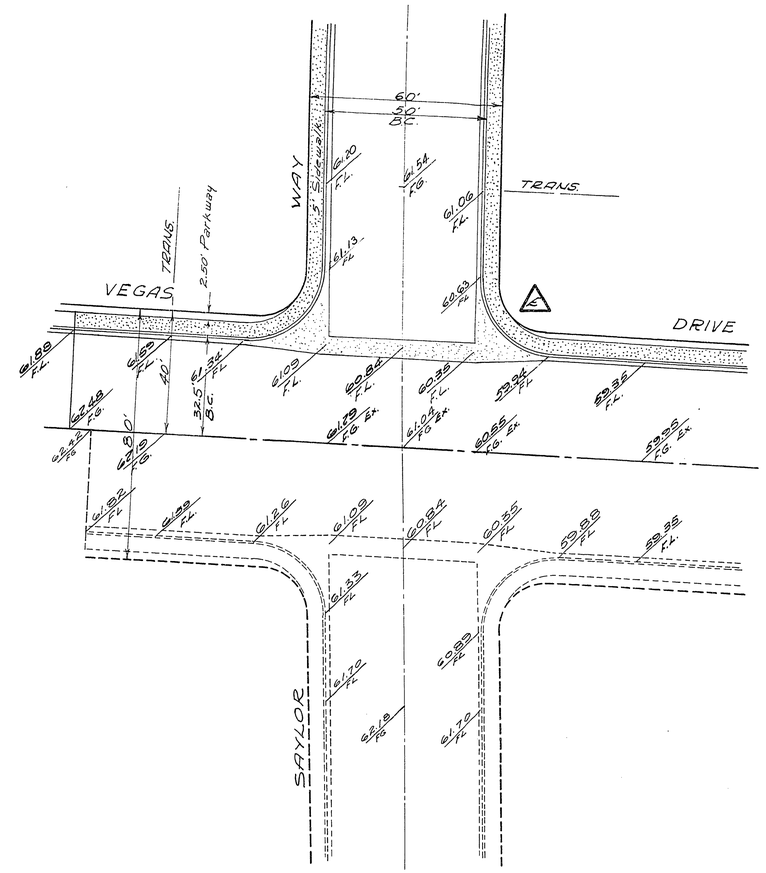

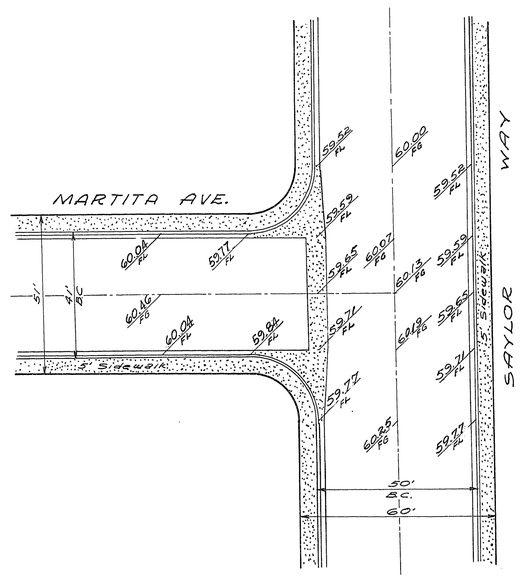

REV	DATE	DESCRIPTION	BY	APPROVED
H				
G				
F				
E	9-16-63	Added Valley gutter @ Vegas Dr.	R.L.	
D	8-1-63	Grade changed and Curb Change Needed To Correct	CG	
C	7-25-63	Grade Change	CS	
B	7-18-63	Grade Change	R.L.	
A	9 July 63	GRADE CHANGED	MR.	

CHARLESTON HEIGHTS
TRACT No 48-A

STREET INTERSECTIONS

SCALE: 1" = 20'

DESIGNED	CDF	WESTERN ENGINEERS, INC.	SHEET 3
DRAWN	CDF	LAS VEGAS NEVADA	OF 4
CHECKED		APPROVED DATE 6/7/63	

107 y-1040-48A