
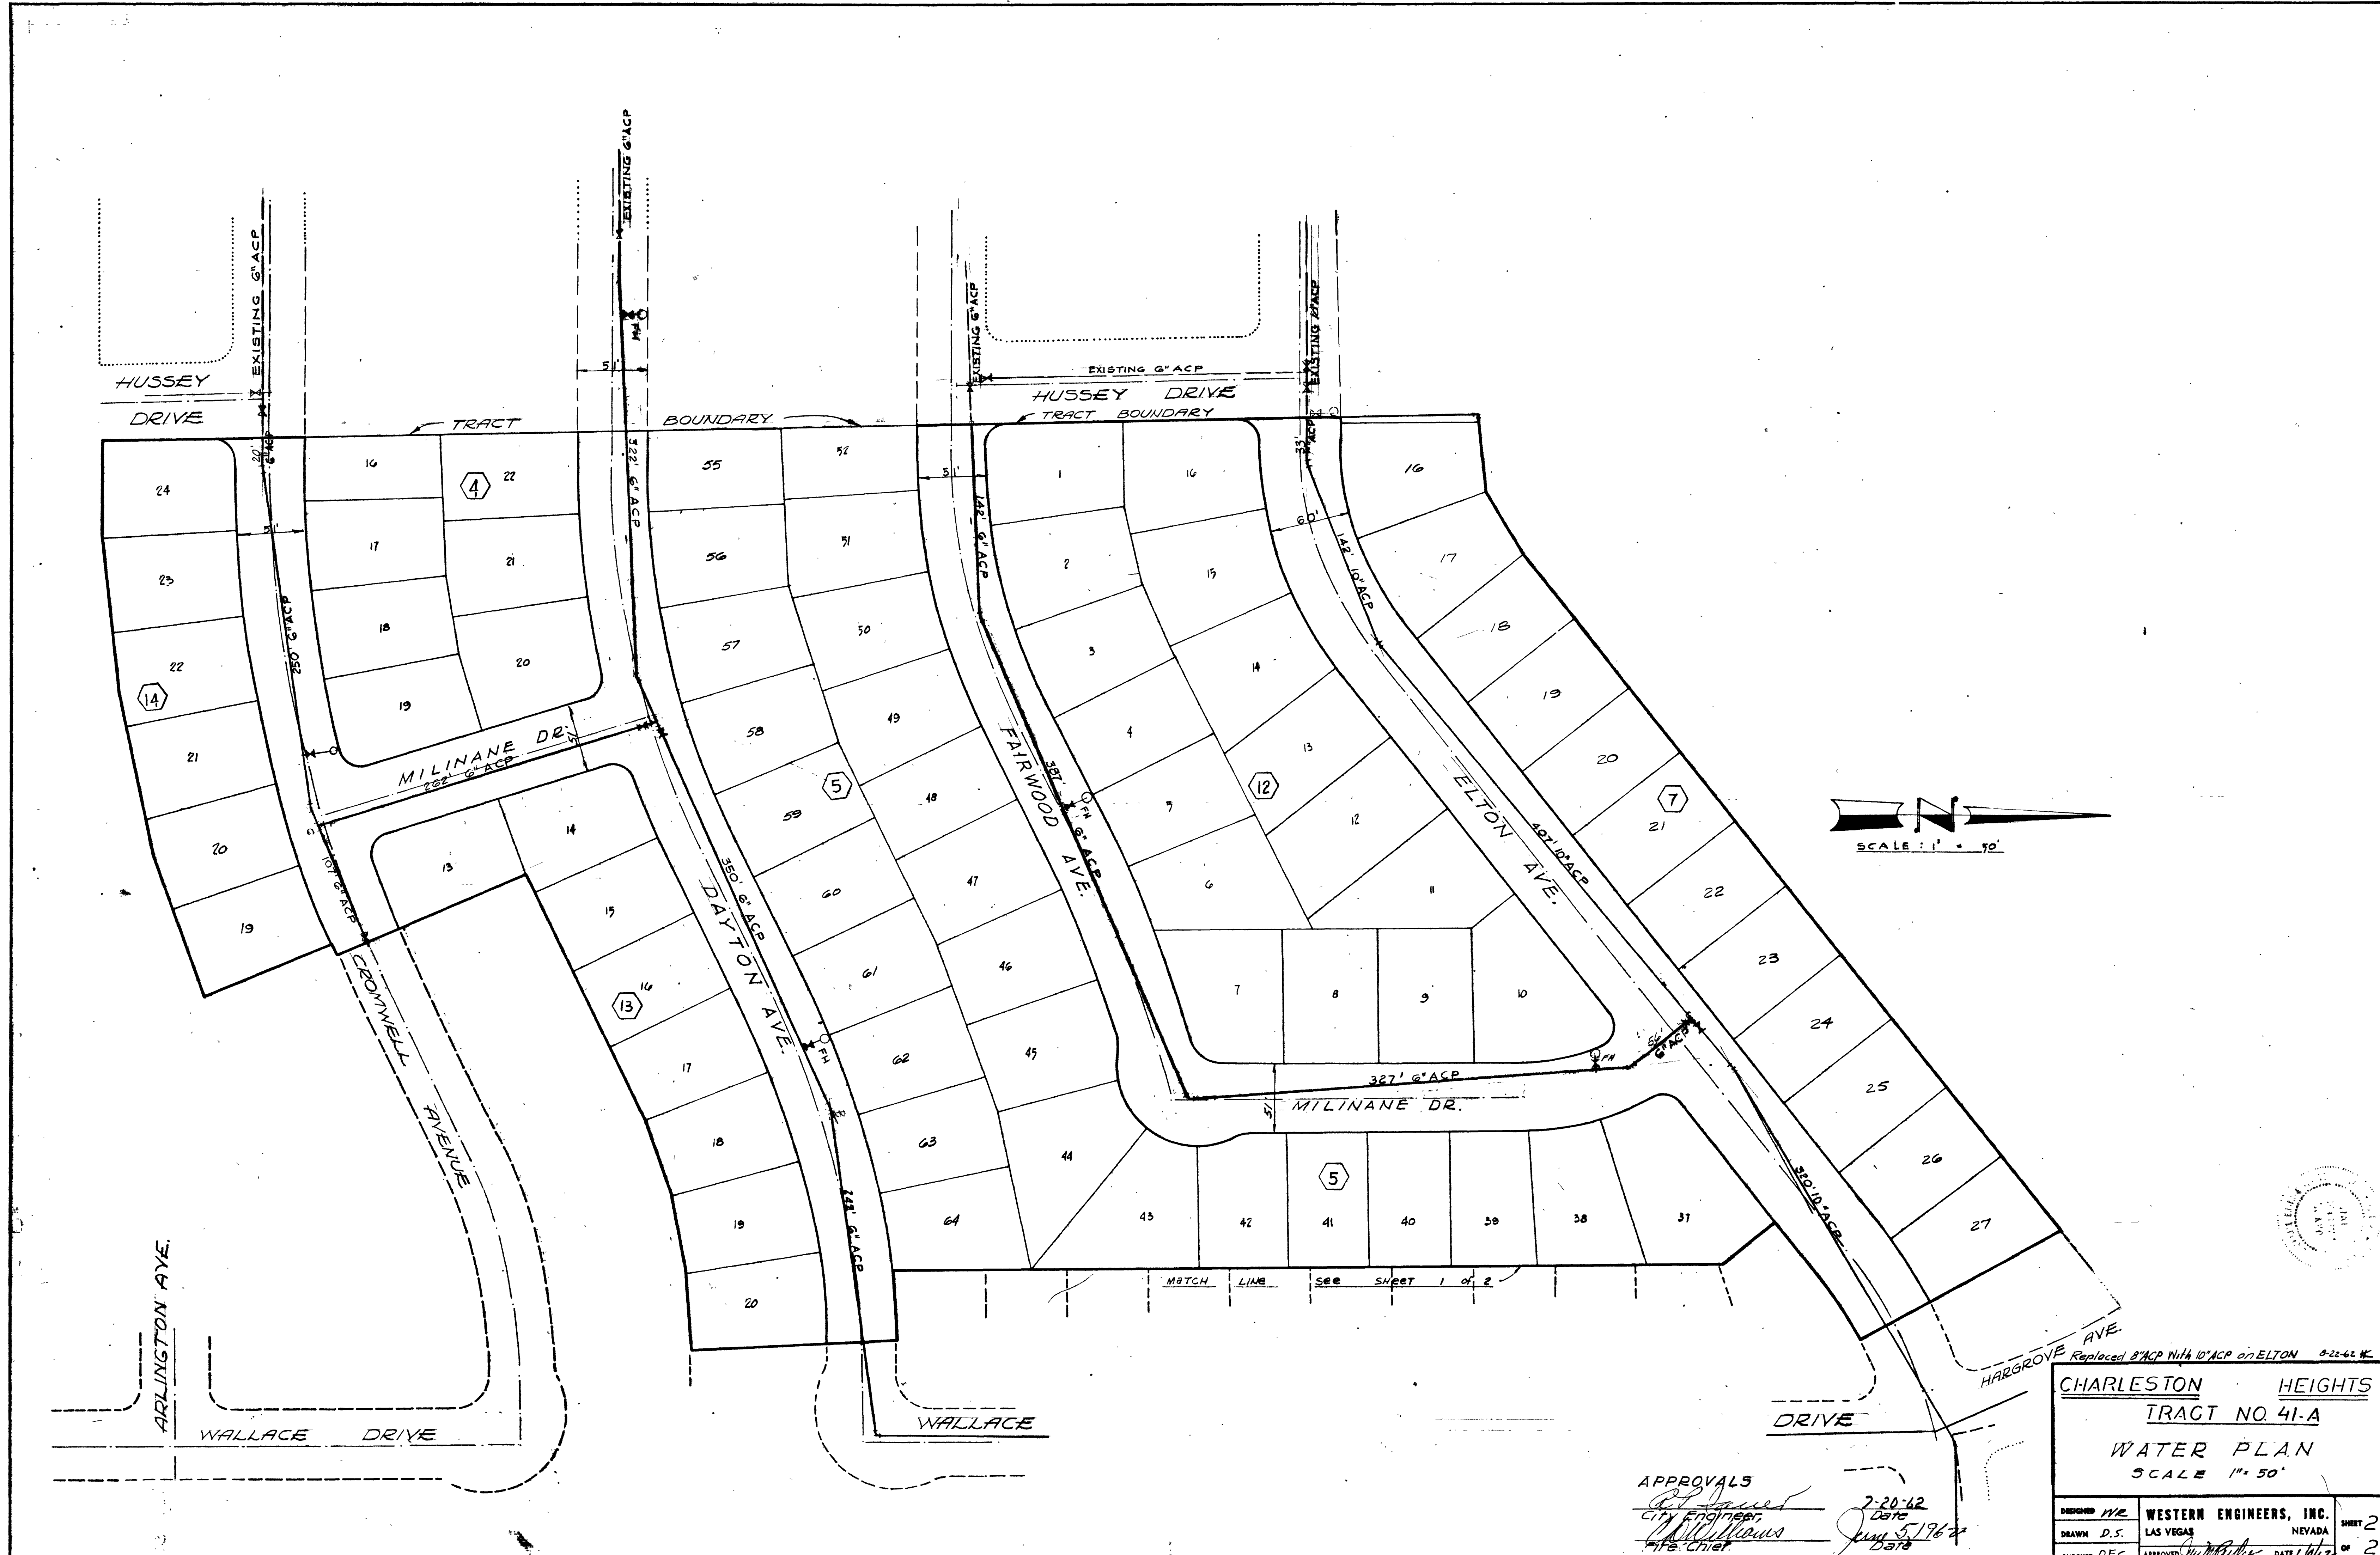



APPROVALS
City Engineer
Date 7-20-62
Pipe Chief
Date June 5, 1962

CHARLESTON HEIGHTS	
TRACT NO 41-A	
WATER PLAN	
SCALE 1" = 50'	
DESIGNED H.R.	WESTERN ENGINEERS, INC.
DRAWN D.S.	LAS VEGAS NEVADA
CHECKED D.F.C.	APPROVED [Signature] DATE 6/1/62

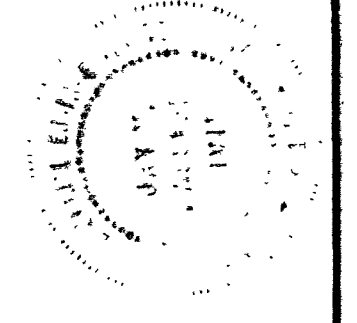

3548

5617-1040-41A

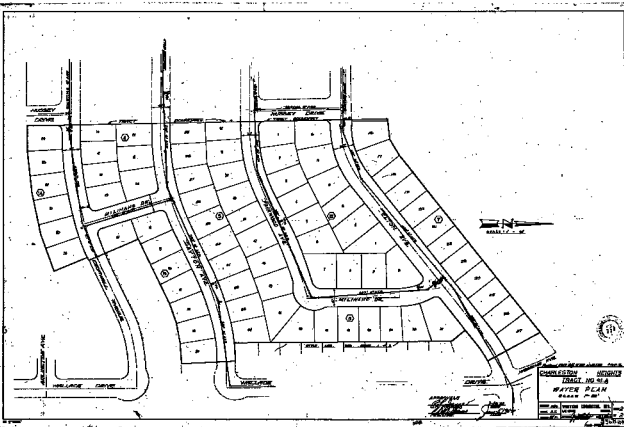

