


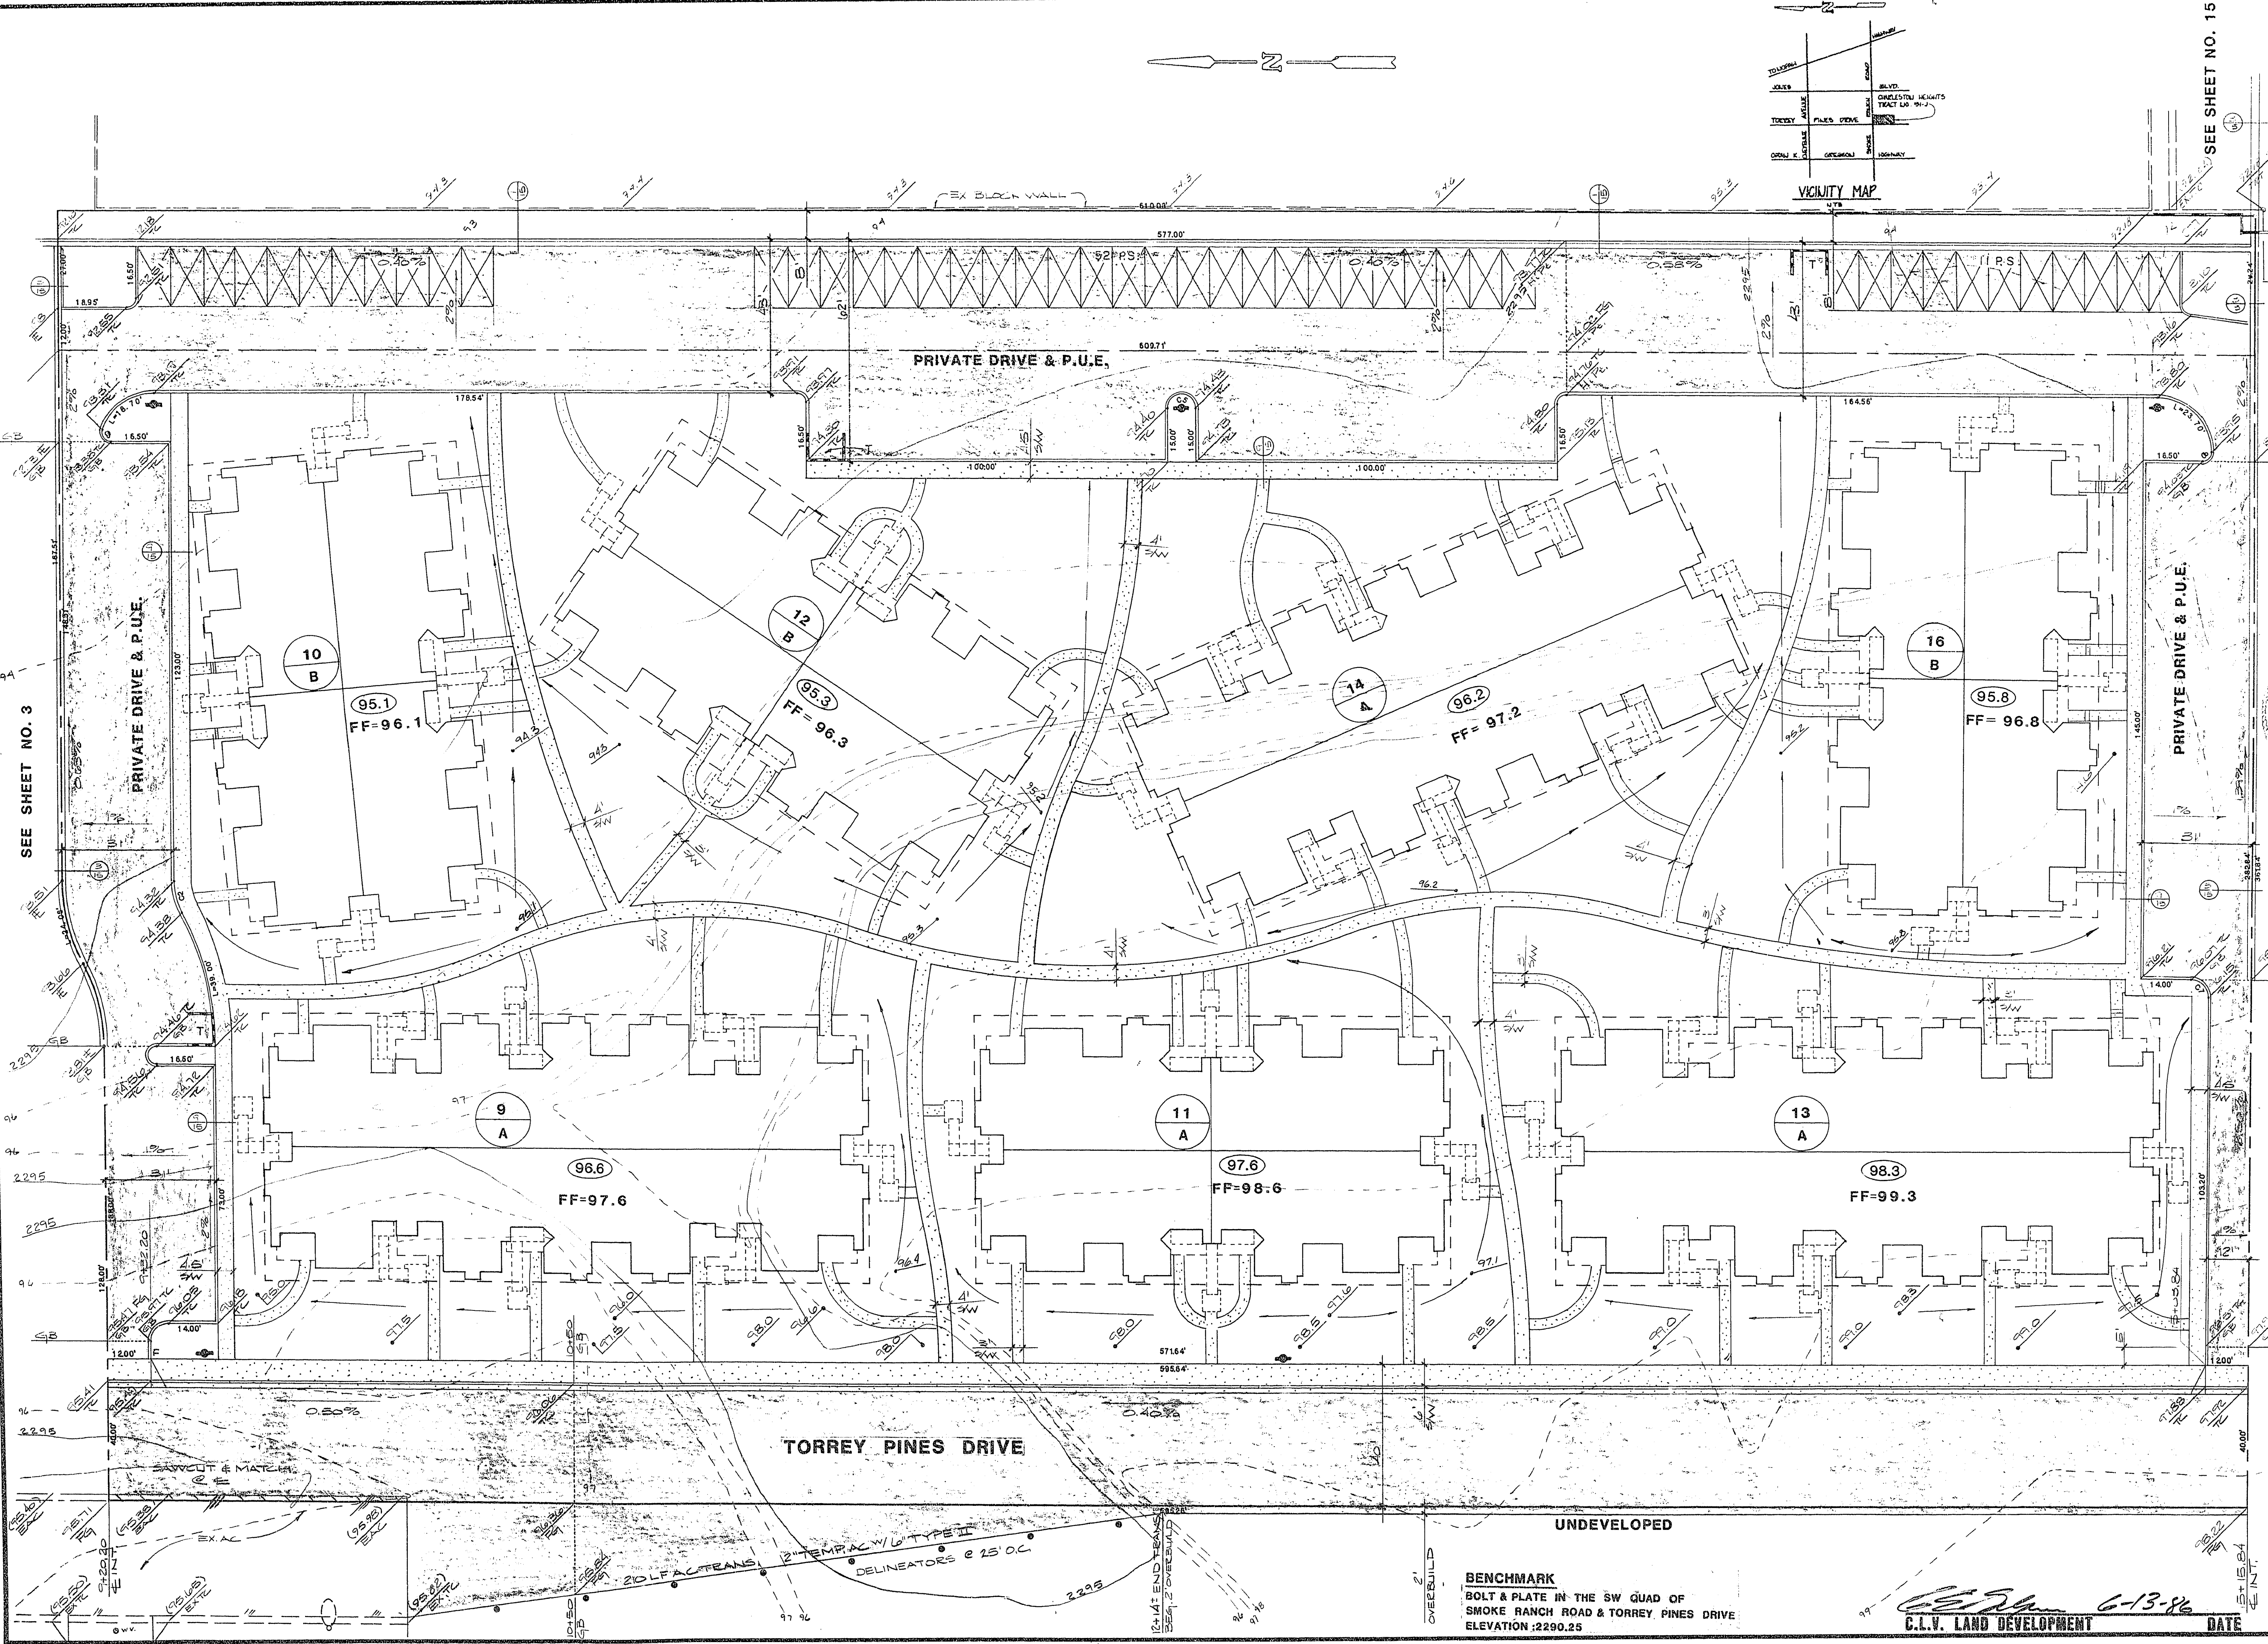

SEE SHEET NO. 3

SEE SHEET NO. 5

SEE SHEET NO. 15

REVISION	DATE	BY	REVISION
1	4-18-86	SCD	REVISIONS PER CLAY
2	6-17-86	MLP	BLDG. NO. 5
3	8-18-86	MLP	ADD TIE-IN AREAS
4	11-18-86	MLP	ADD TIE-IN AREAS

CLAYTON J. JAMES 2/18/86

CONSULTING ENGINEERS • PLANNERS

2300 PASEO DEL PRADO, BUILDING A, SUITE 100
LAS VEGAS, NEVADA 89102 PHONE (702) 873-7550

ROUGH GRADING PLAN

CHARLESTON HEIGHTS TRACT NO. 51-J

WO NO. 3311
BY SCD
DATE JAN. '86
SCALE 1"=20'
SHEET 4
OF 15 SHEETS

BENCHMARK
BOLT & PLATE IN THE SW QUAD OF
SMOKE RANCH ROAD & TORREY PINES DRIVE
ELEVATION: 2290.25

DATE 6-13-86
C.L.V. LAND DEVELOPMENT

107Y-1040-51-J