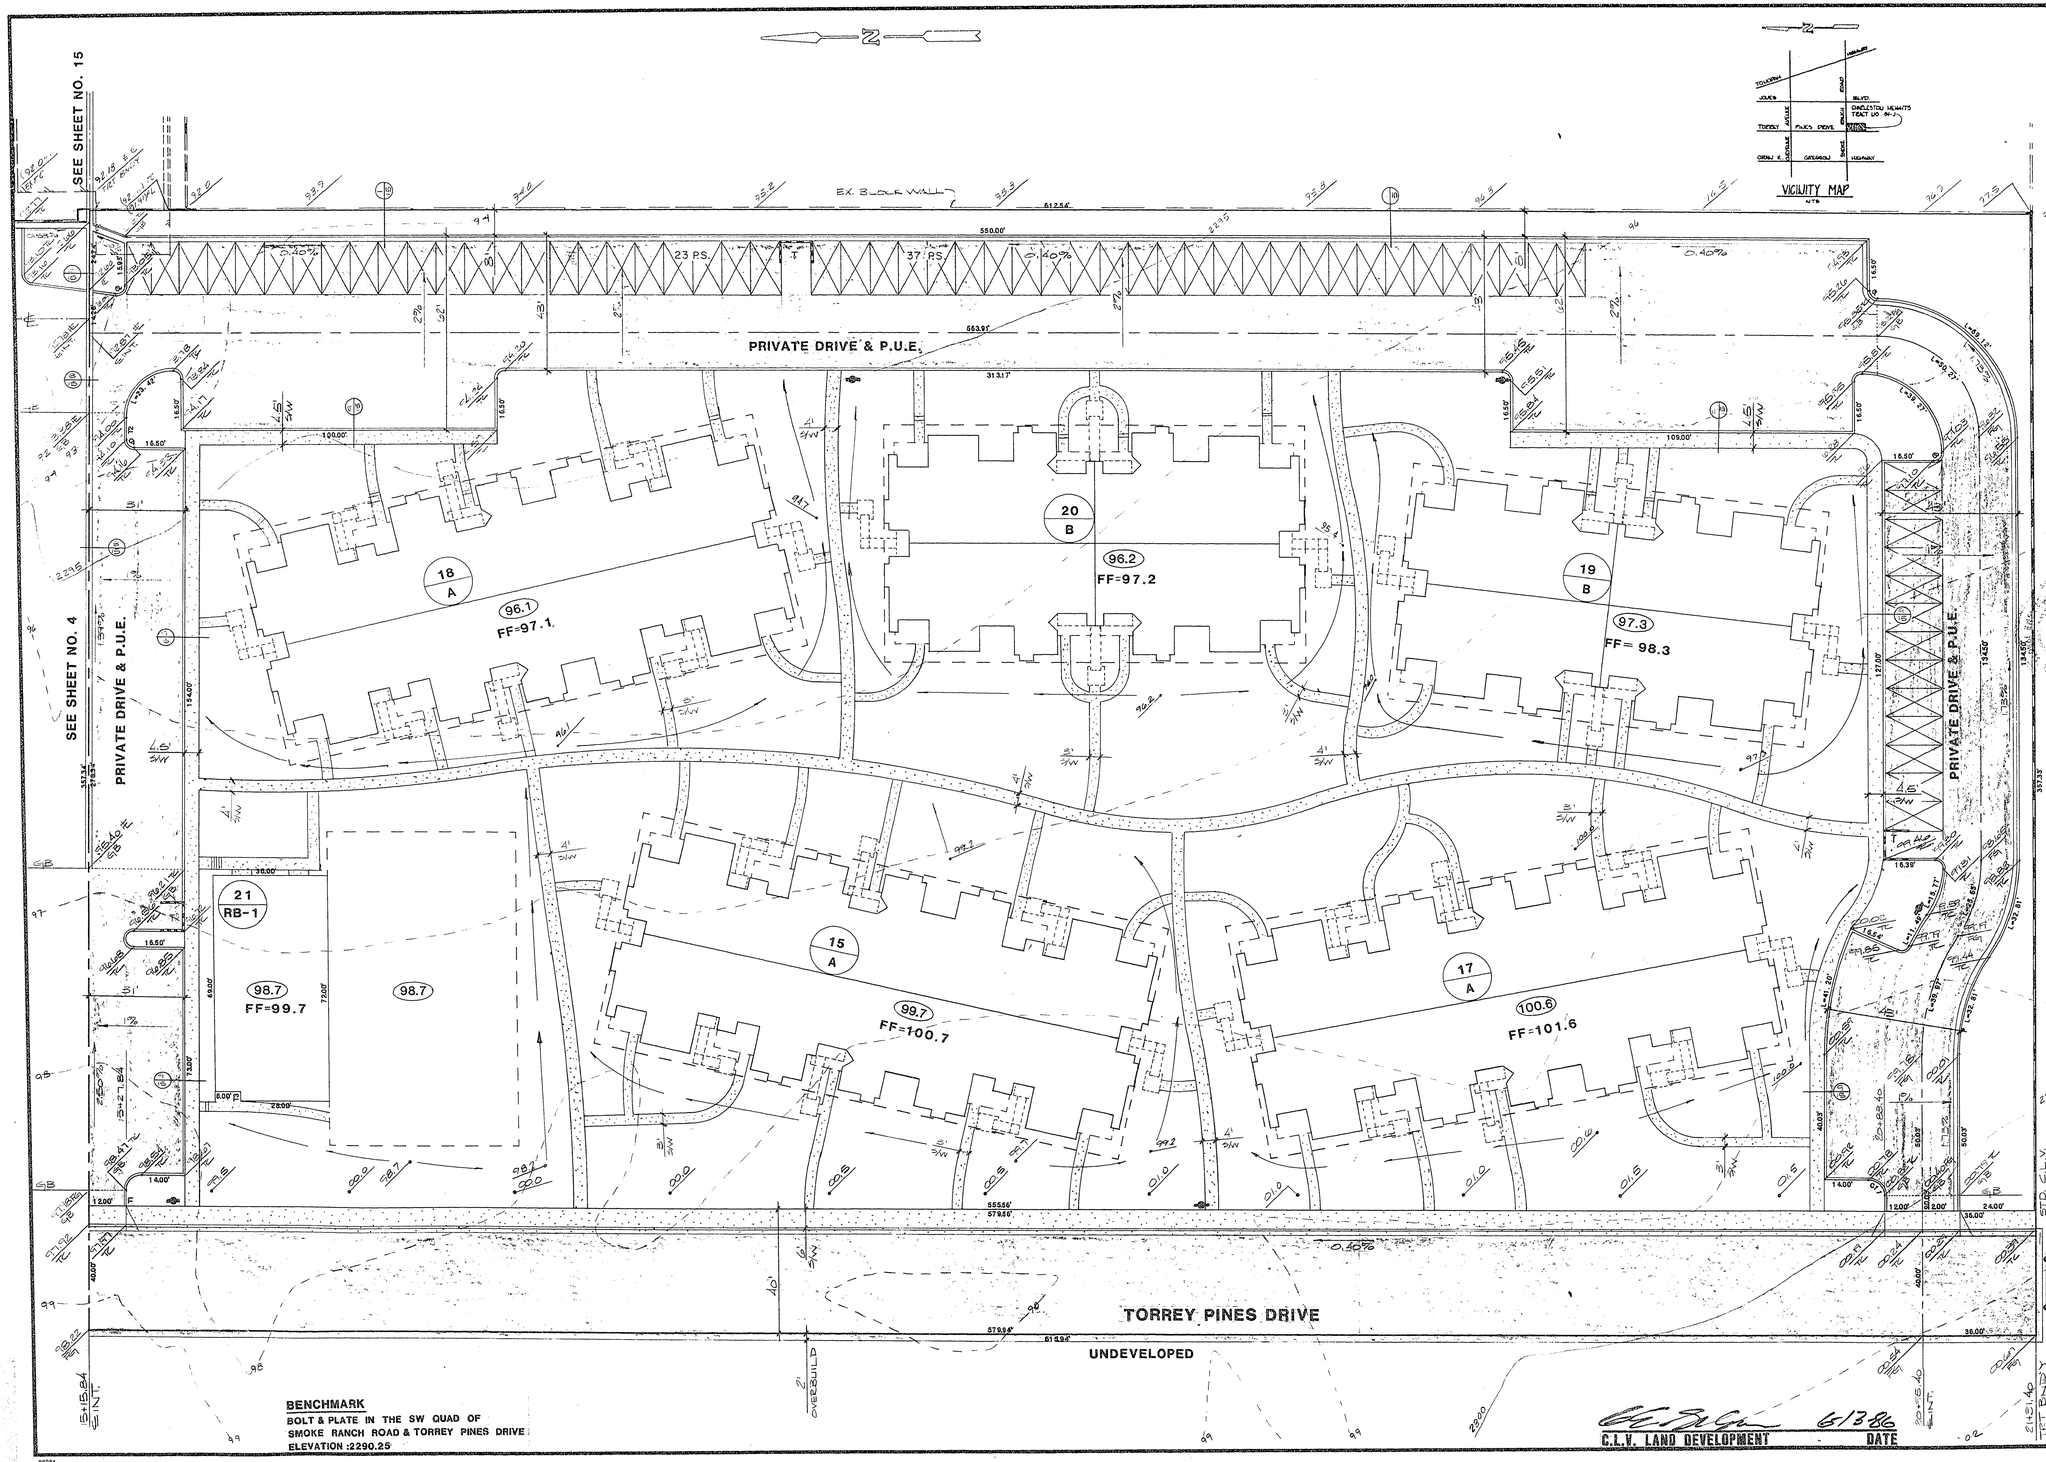

REV	DATE	BY	REVISION
1	1-8-86	SCD	REVISIONS PER C.L.V.
2	6-17-86	MLP	BLDG. NOS. K.U. 8-18-86
3	8-28-86	SCD	ADD TRASH AREAS K.U. 8-18-86

2/12/86

CONSULTING ENGINEERS • PLANNERS
2300 PASEO DEL PRADO BUILDING A SUITE 100
LAS VEGAS, NEVADA 89102 PHONE (702) 873-7550

vtn nevada

TITLE
ROUGH GRADING PLAN

PROJECT
CHARLESTON HEIGHTS TRACT NO. 51-J

WO NO. 3311
BY SCD
DATE JAN. '86
SCALE 1":20'

SHEET 5 OF 15 SHEETS

107Y-1040-51-J