

Call
before you
Dig.
1-800-277-2600
UNDERGROUND SERVICE DATA

BENCHMARK
BOLT & PLATE IN THE SW QUAD OF
SMOKE RANCH ROAD & TORREY PINES DRIVE
ELEVATION: 3290.35

La Riva Inc. 2-21-84
NEVADA POWER CO. DATE

LAS VEGAS VALLEY WATER DIST. DATE

P.L. Oster
C.L.V. SANITATION SUPERVISOR DATE

6-13-84
C.L.V. LAND DEVELOPMENT DATE

6-13-84
C.L.V. FIRE DEPARTMENT DATE

DATE

SHEET

12

OF 14 SHEETS

MASTER UTILITY PLAN

CHARLESTON HEIGHTS TRACT 51-J

WO NO 3311



BY SCD

DATE JAN. '88


SCALE 1"=20'

CONSULTING ENGINEERS • PLANNERS
2300 PASEO DEL PRADO BUILDING A SUITE 100
LAS VEGAS, NEVADA 89102 PHONE (702) 873-7550


nevada
vtn

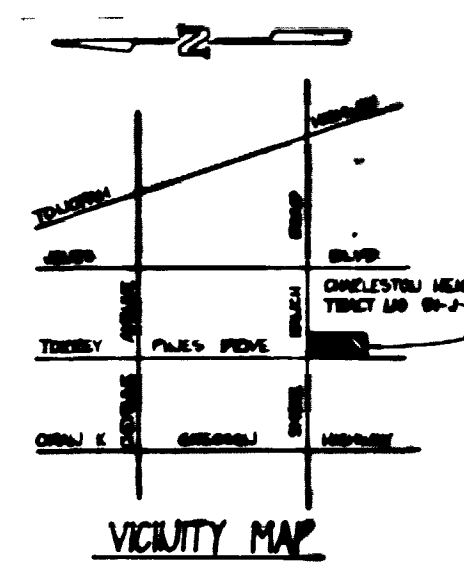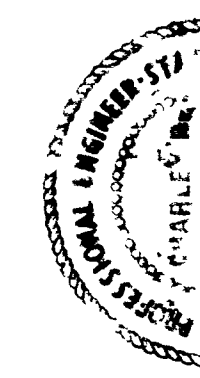

SEE SHEET NO. 13

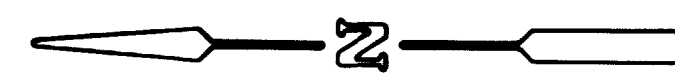


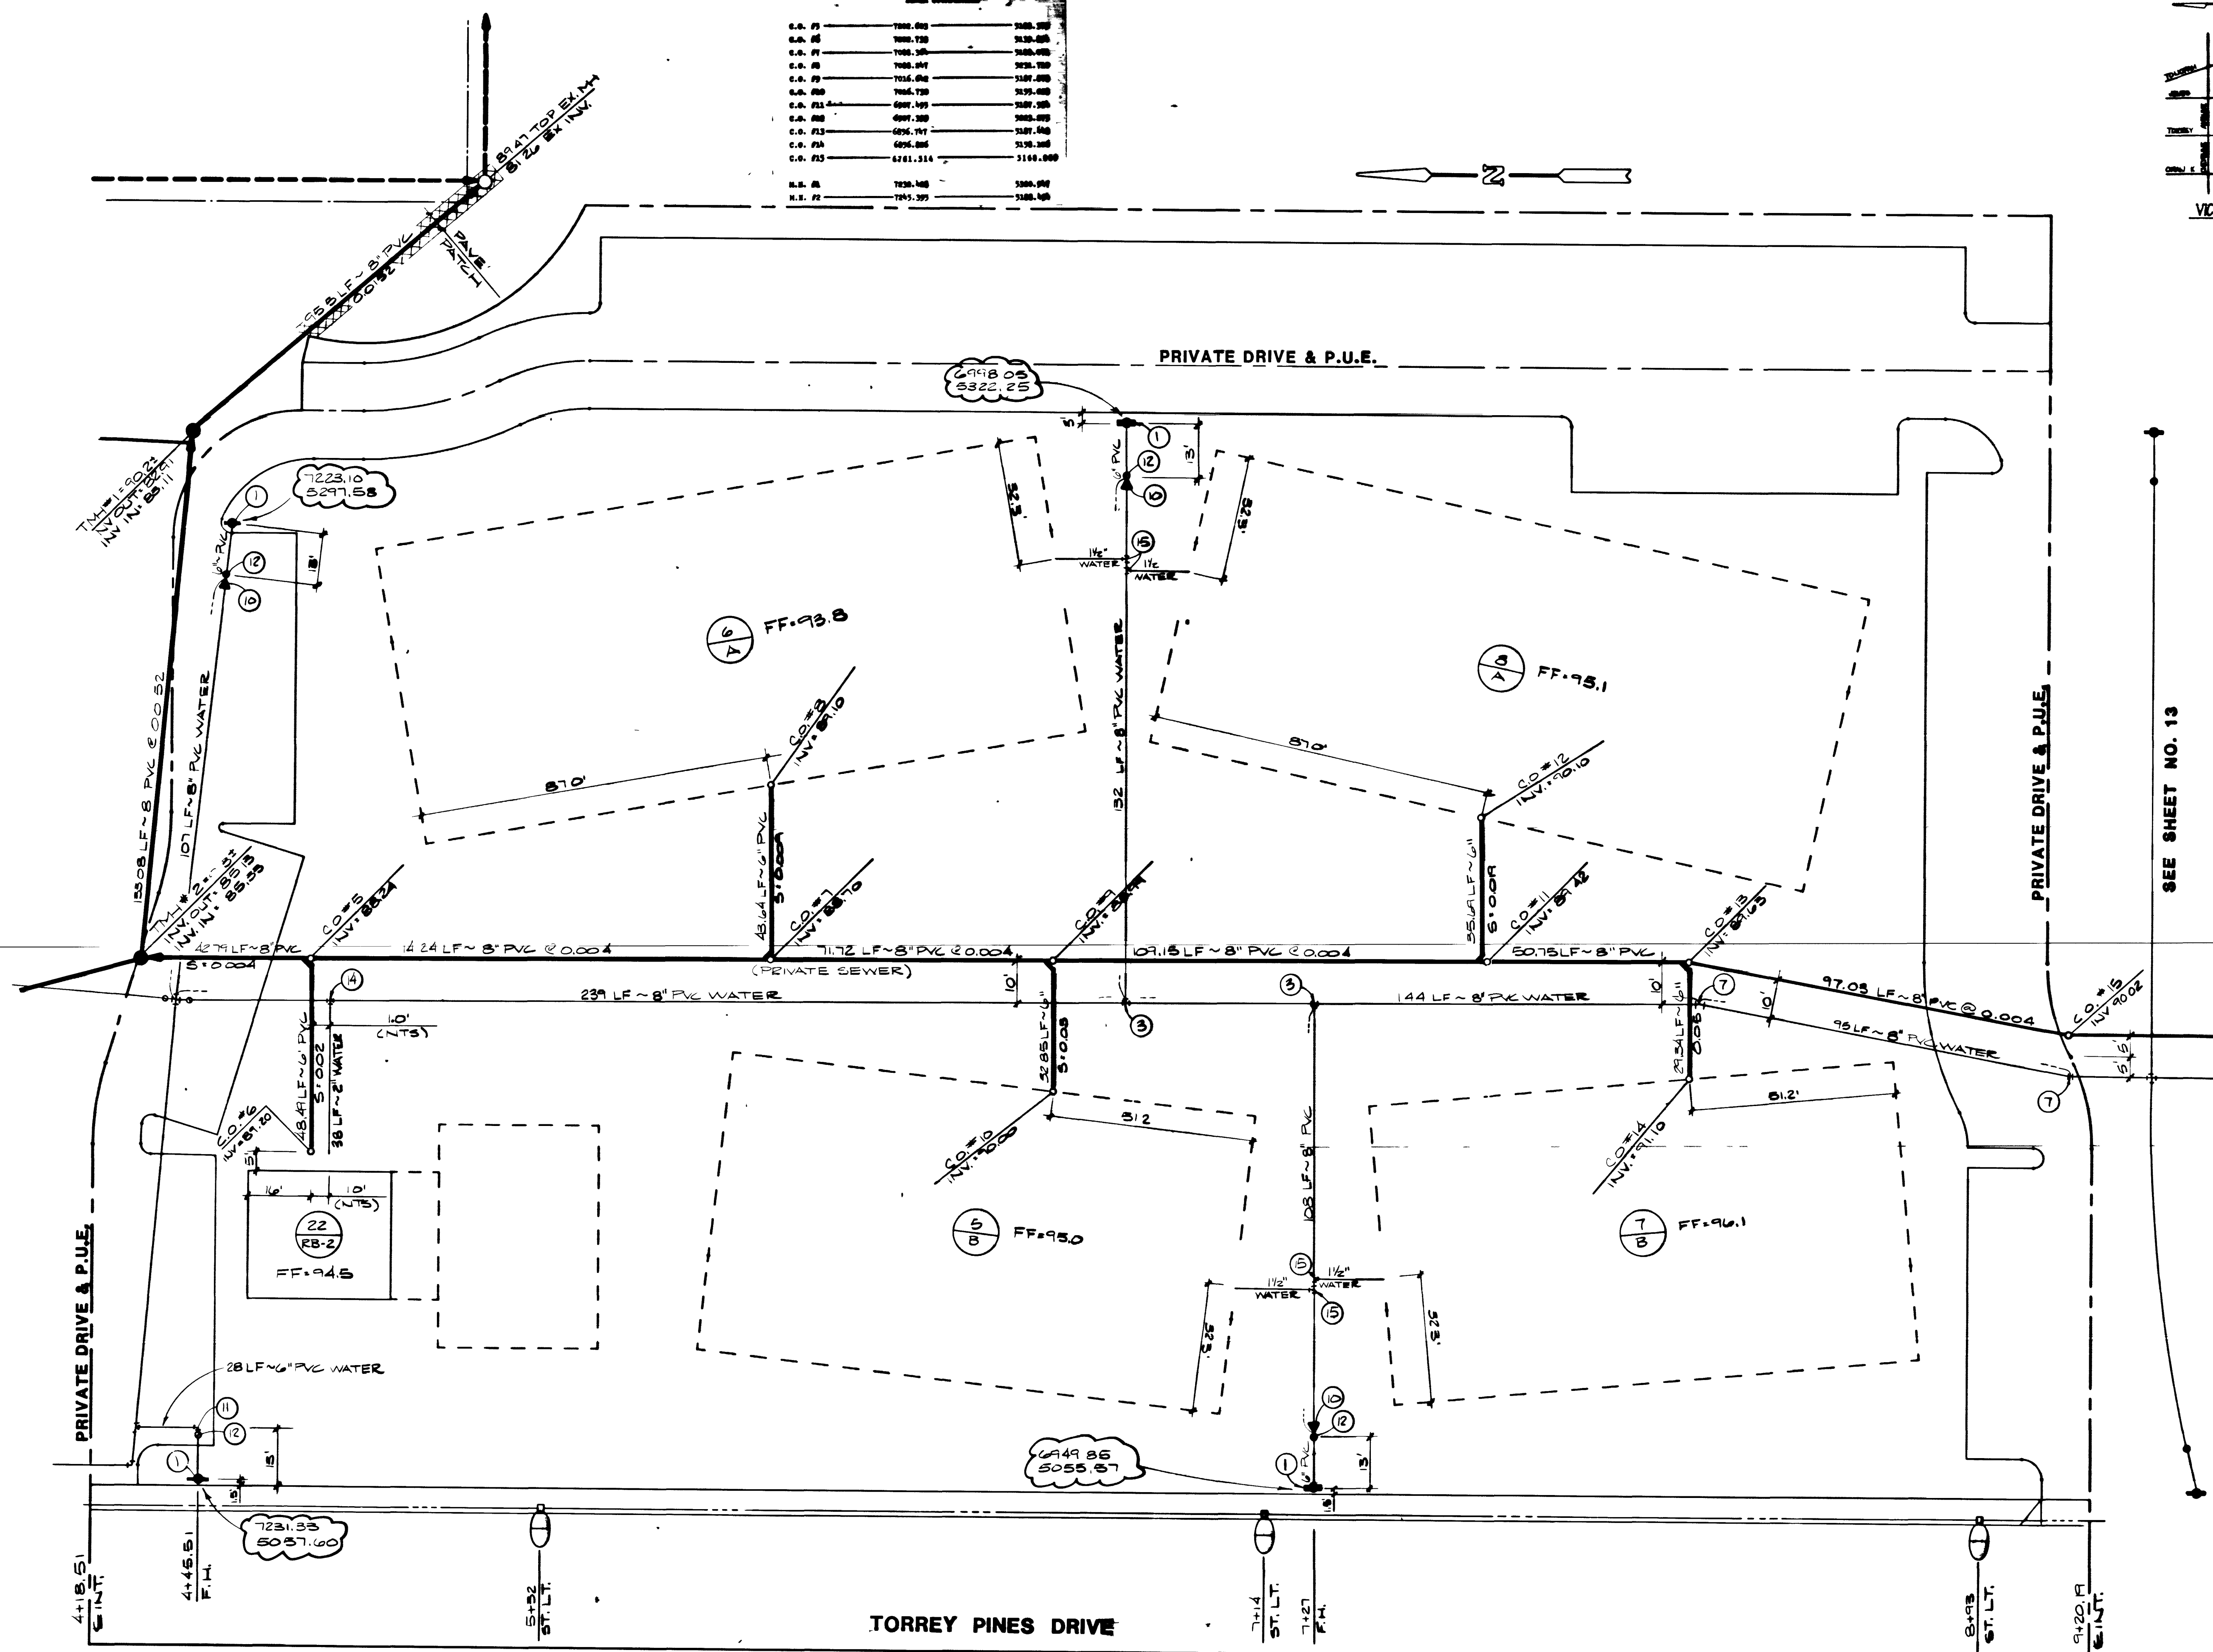

SEE SHEET NO. 11

3631

307Y-1040-51-J

